




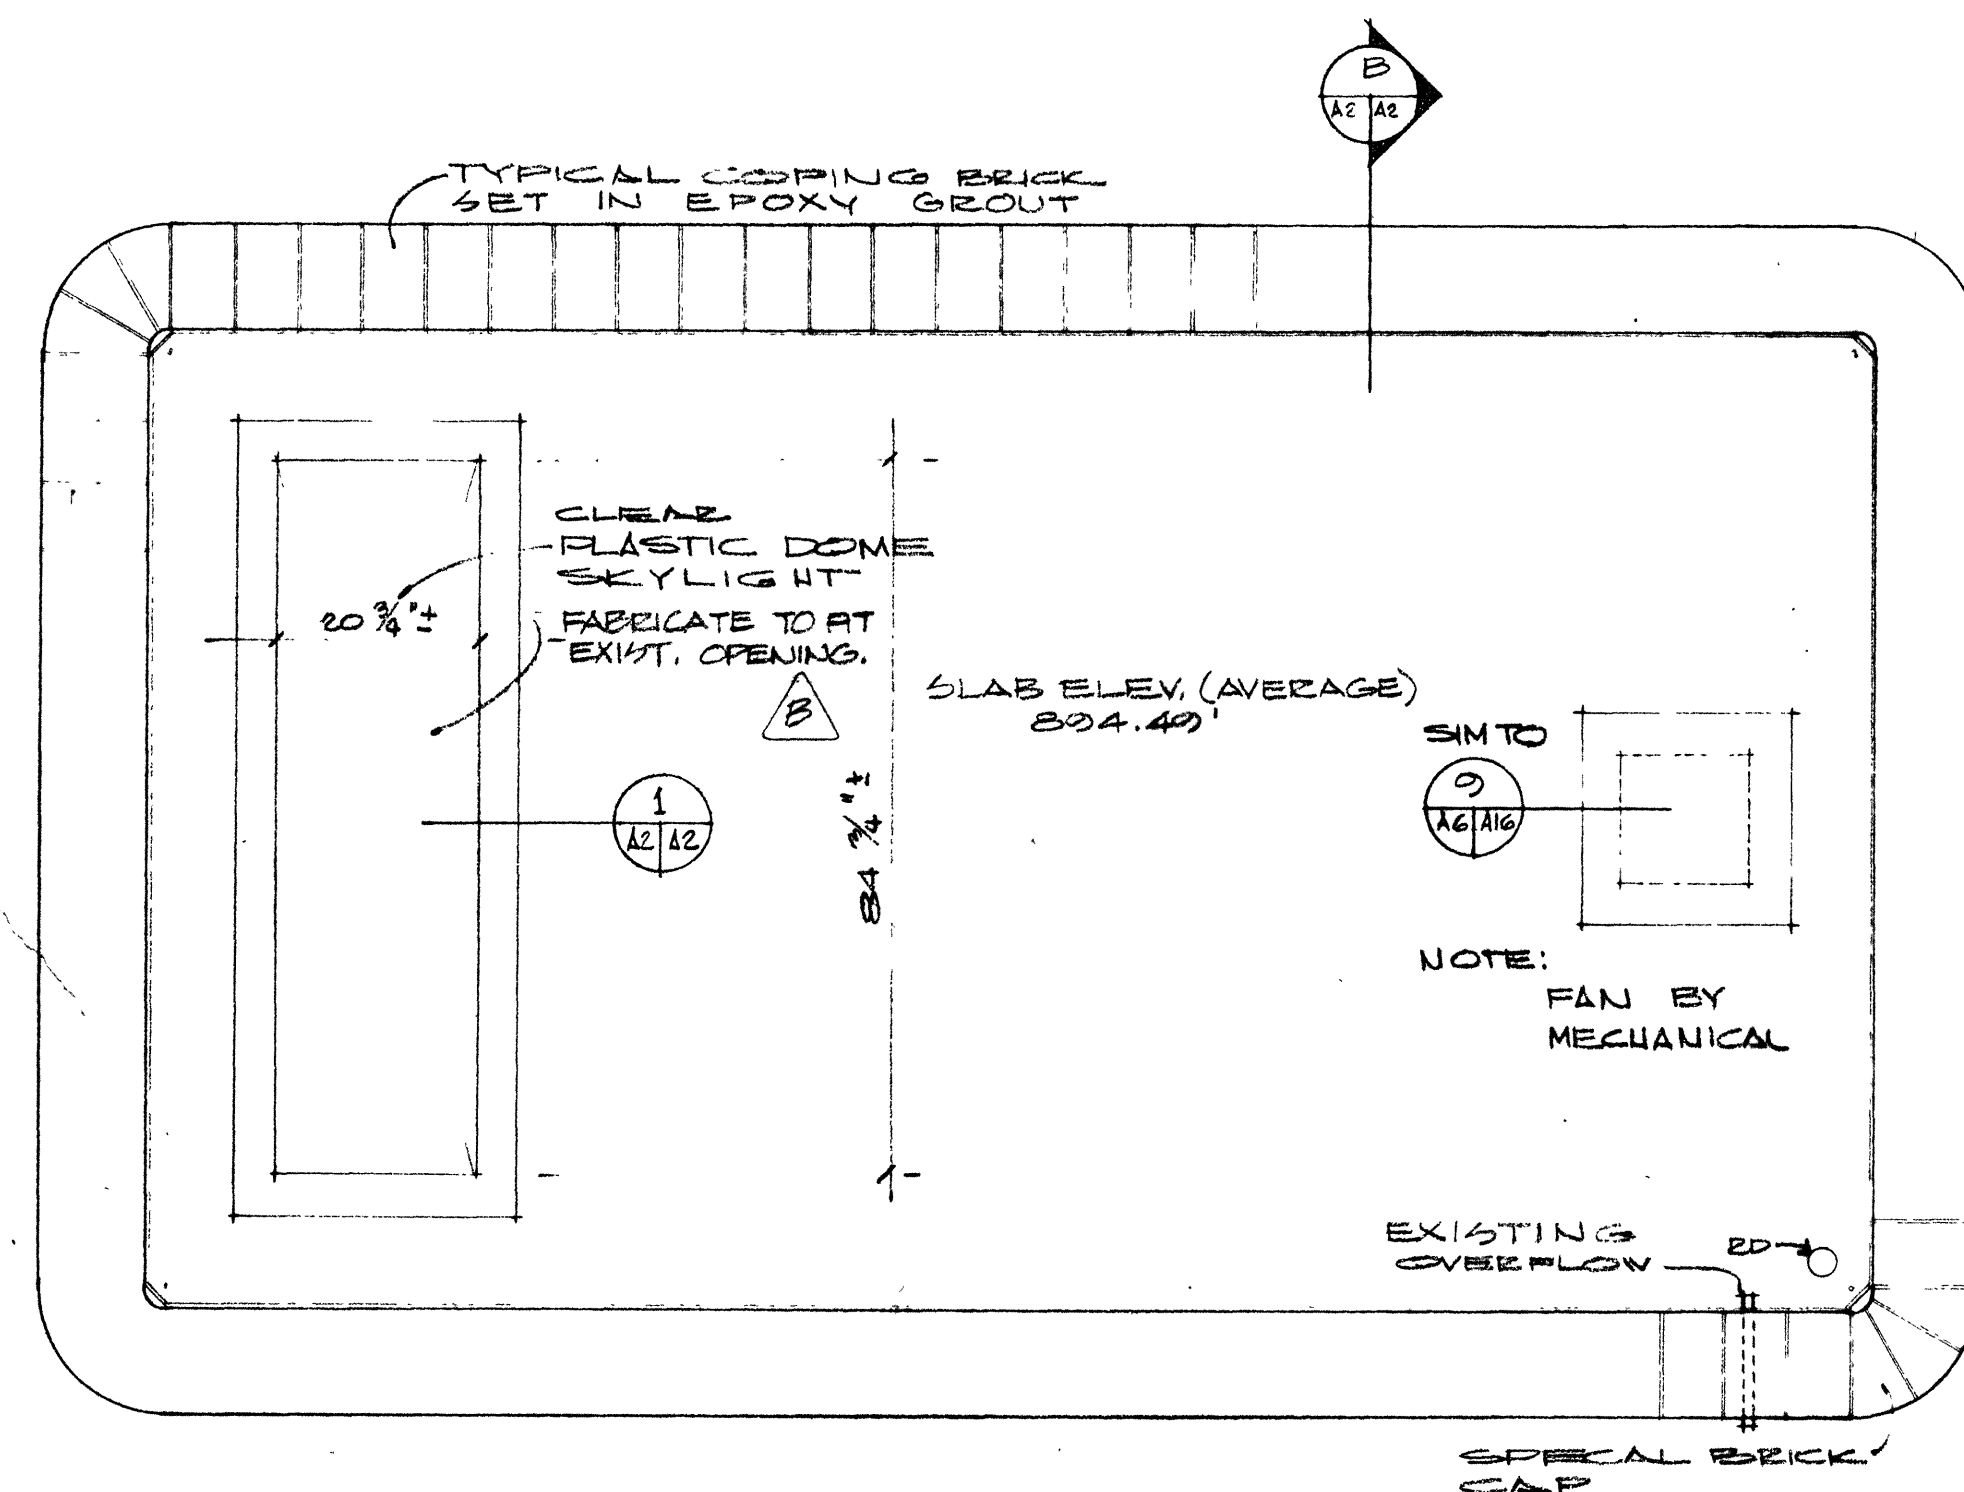


ROOF PLAN
1/2"=1'-0"

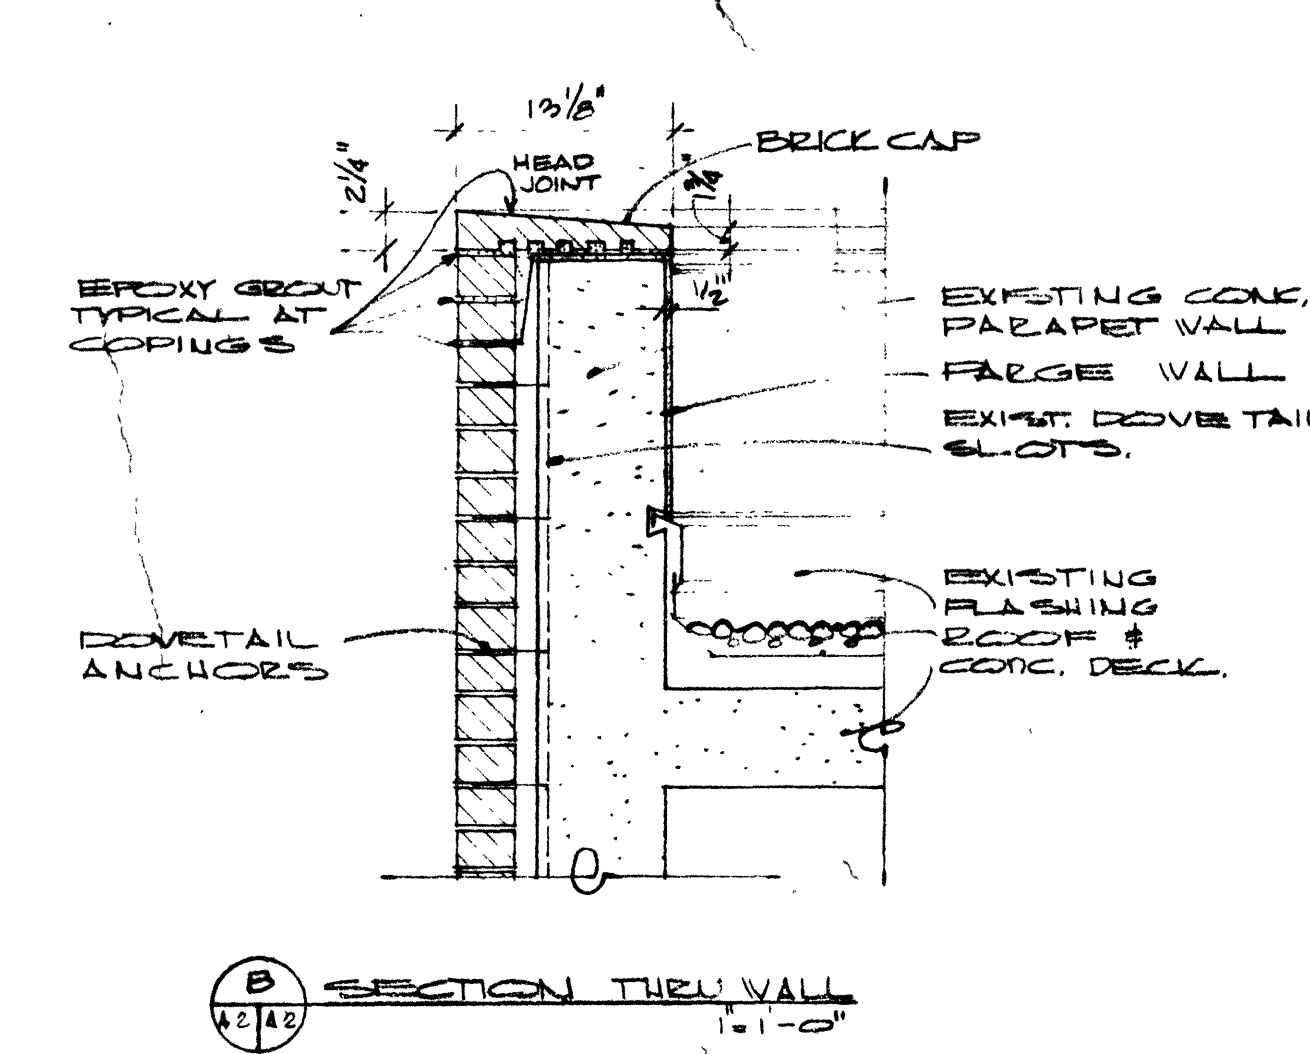


SECTION THROUGH WALL
1/2"=1'-0"

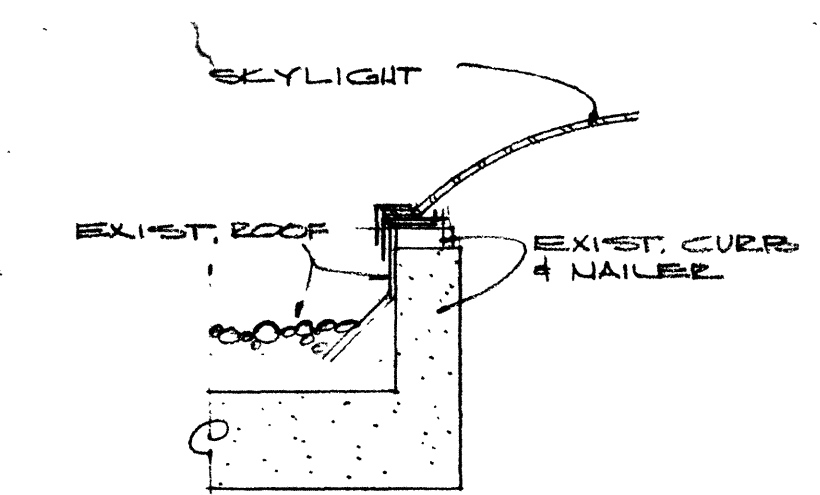



SKYLIGHT DETAIL
1/2"=1'-0"

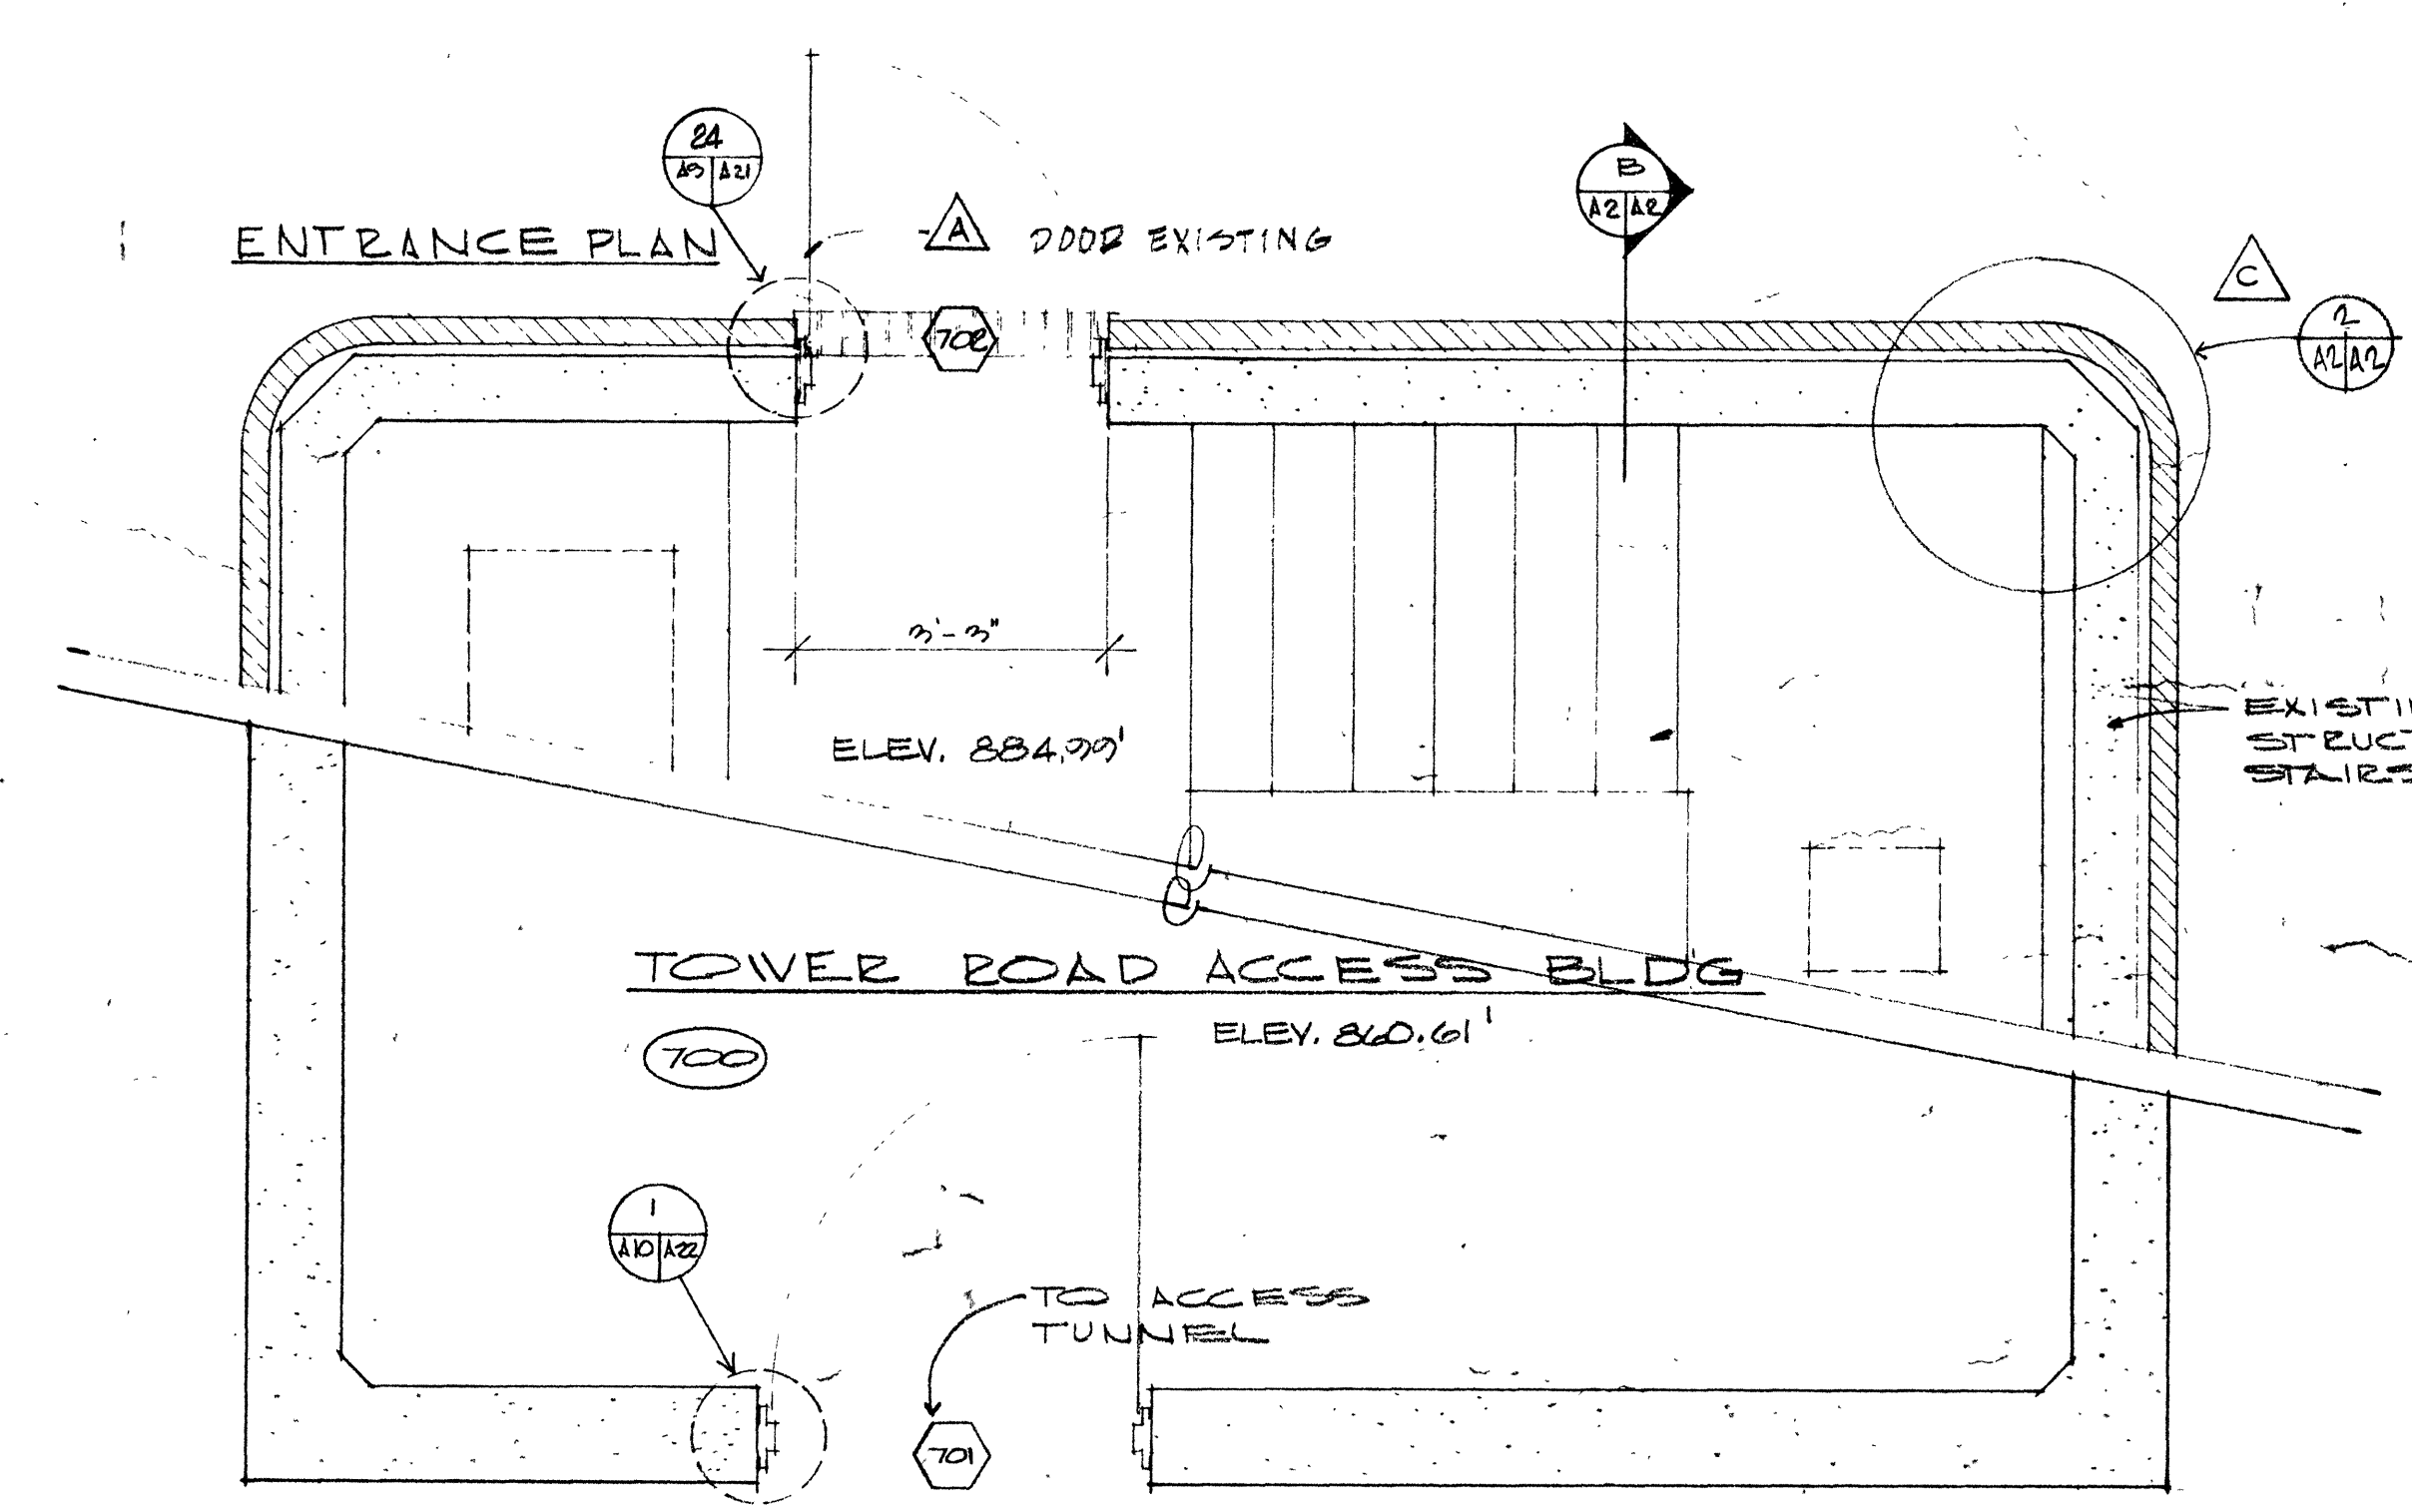


BELOW GRADE PLAN
1/2"=1'-0"

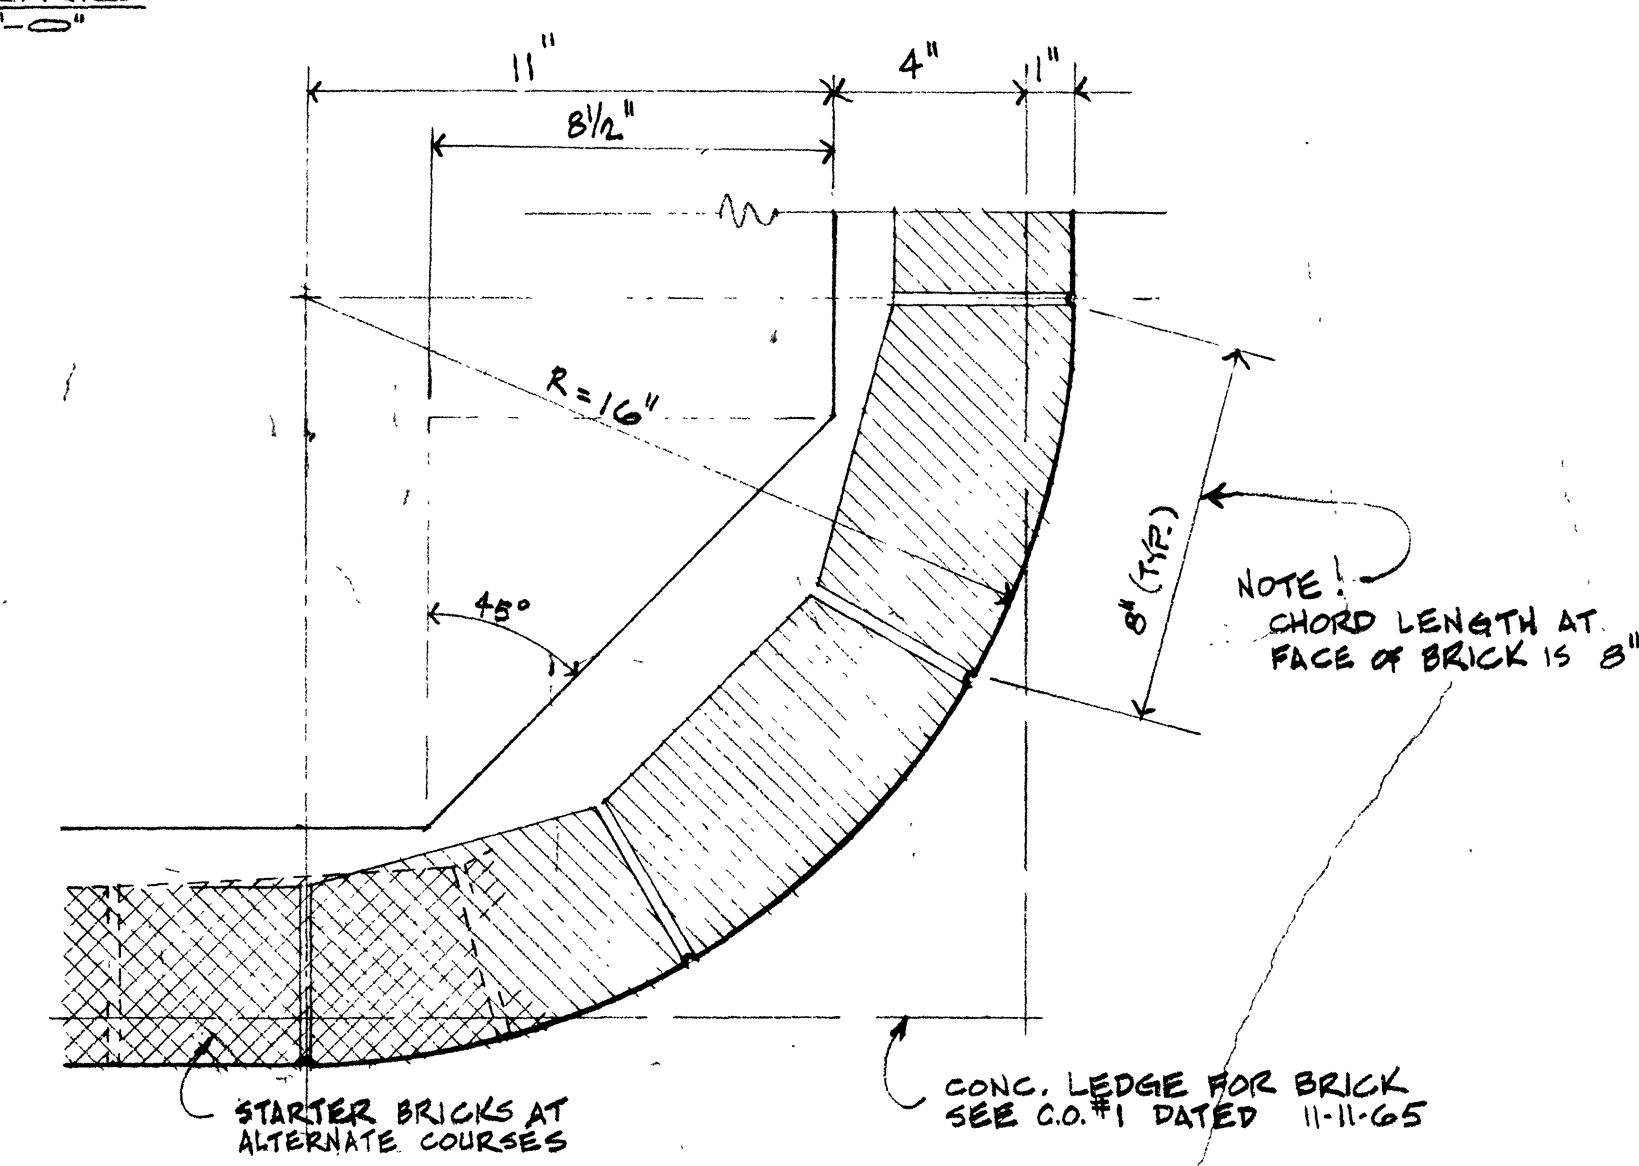

TYPICAL CORNER BRICK
1/4 F.S.

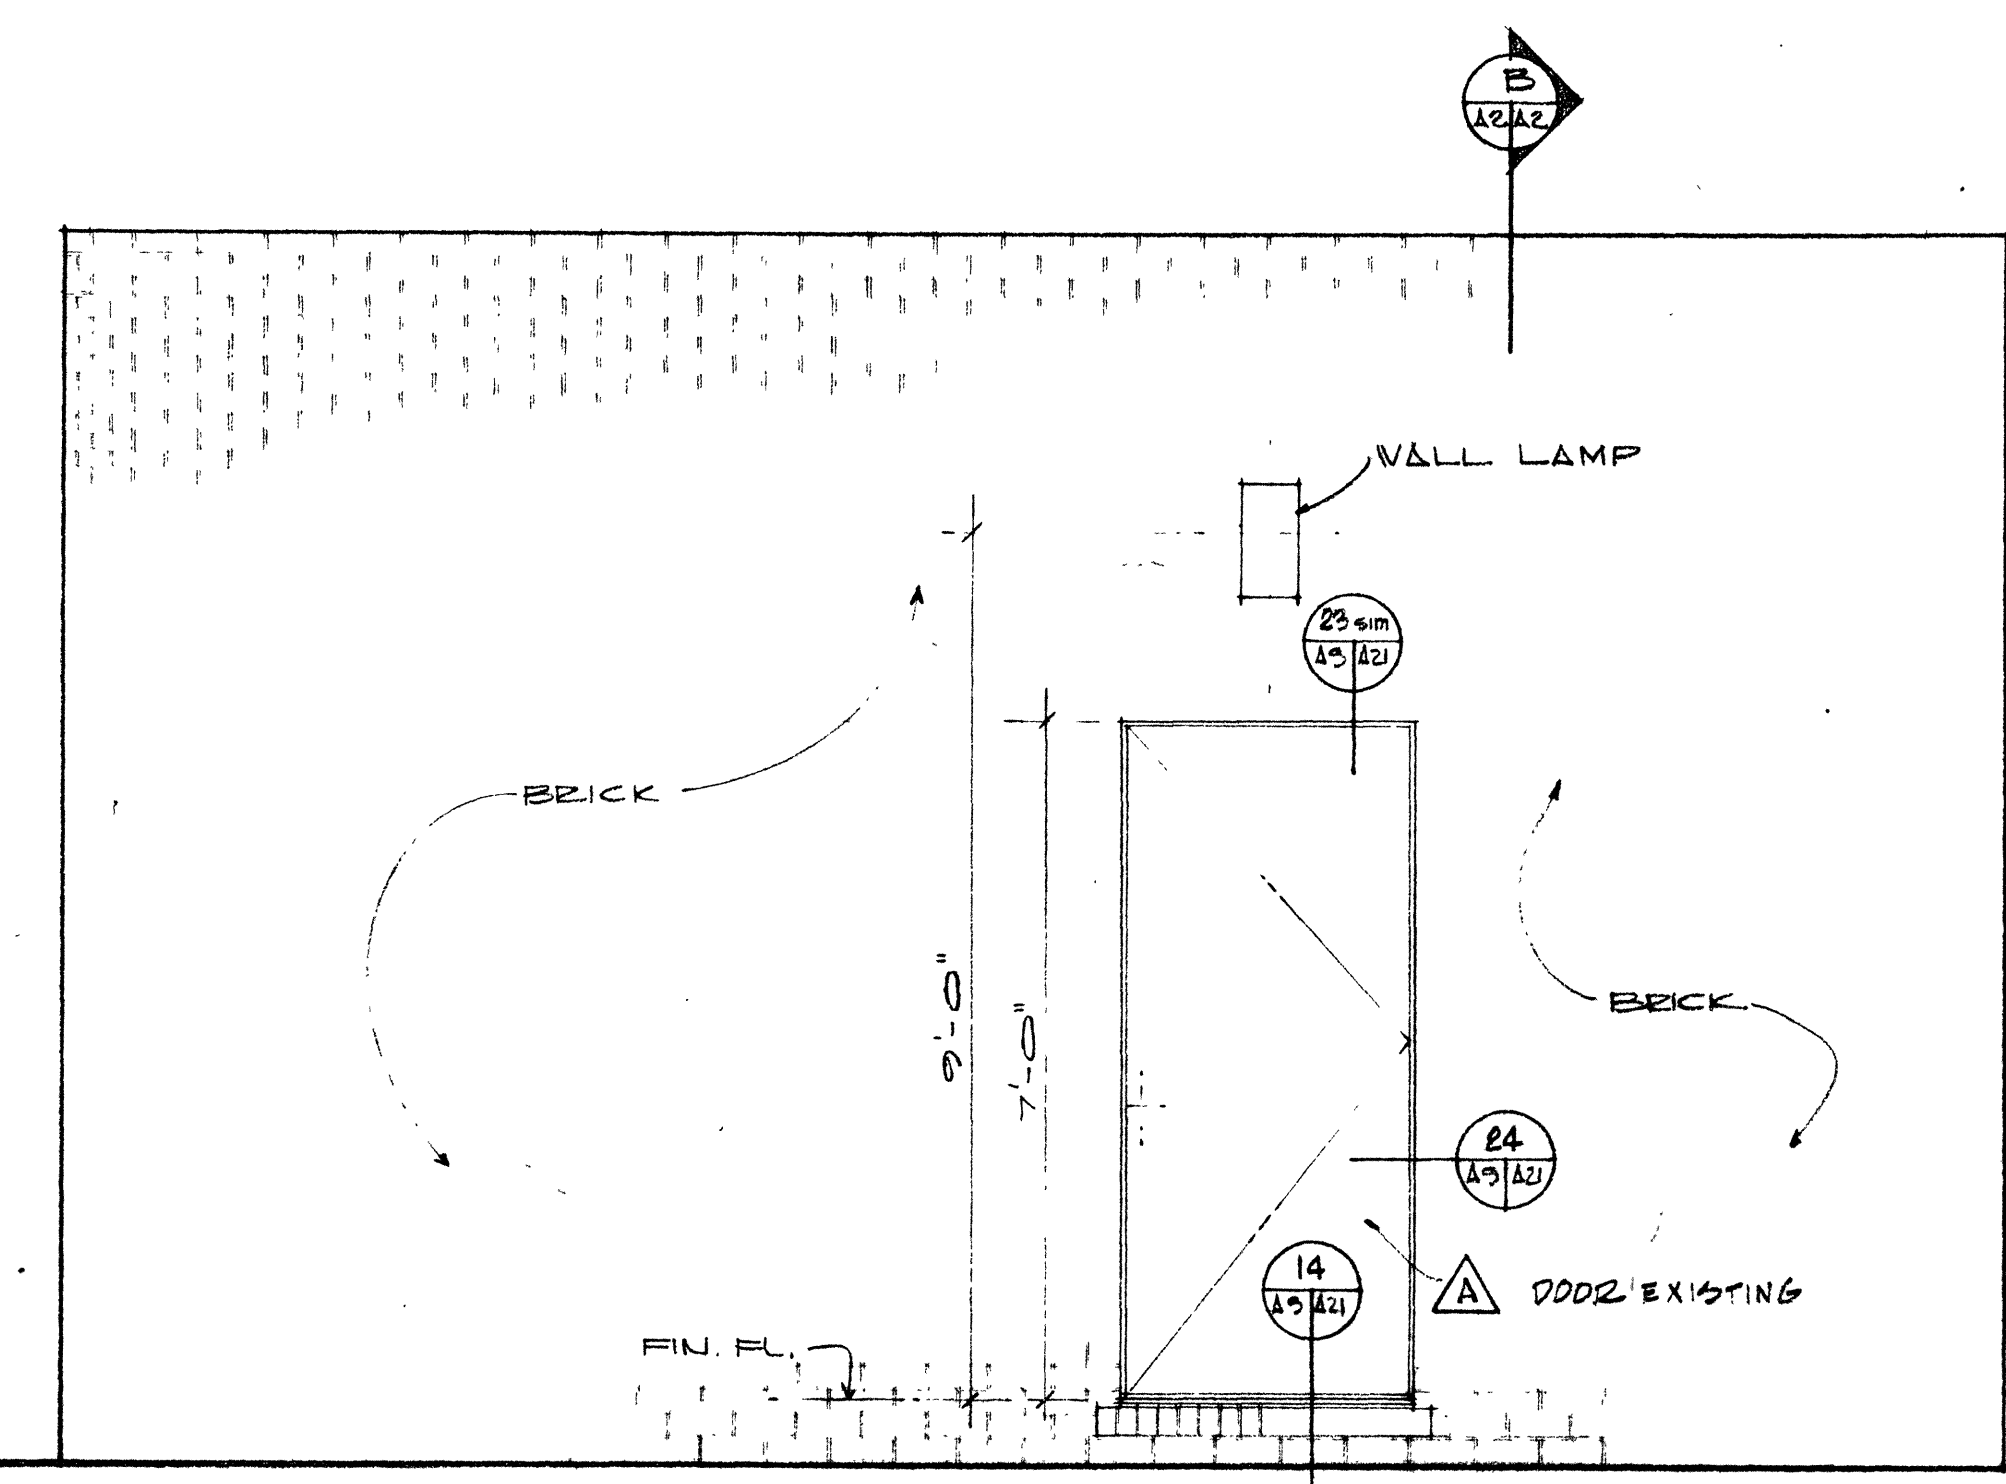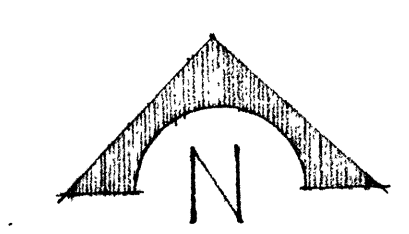

NORTH ELEVATION
1/2"=1'-0"

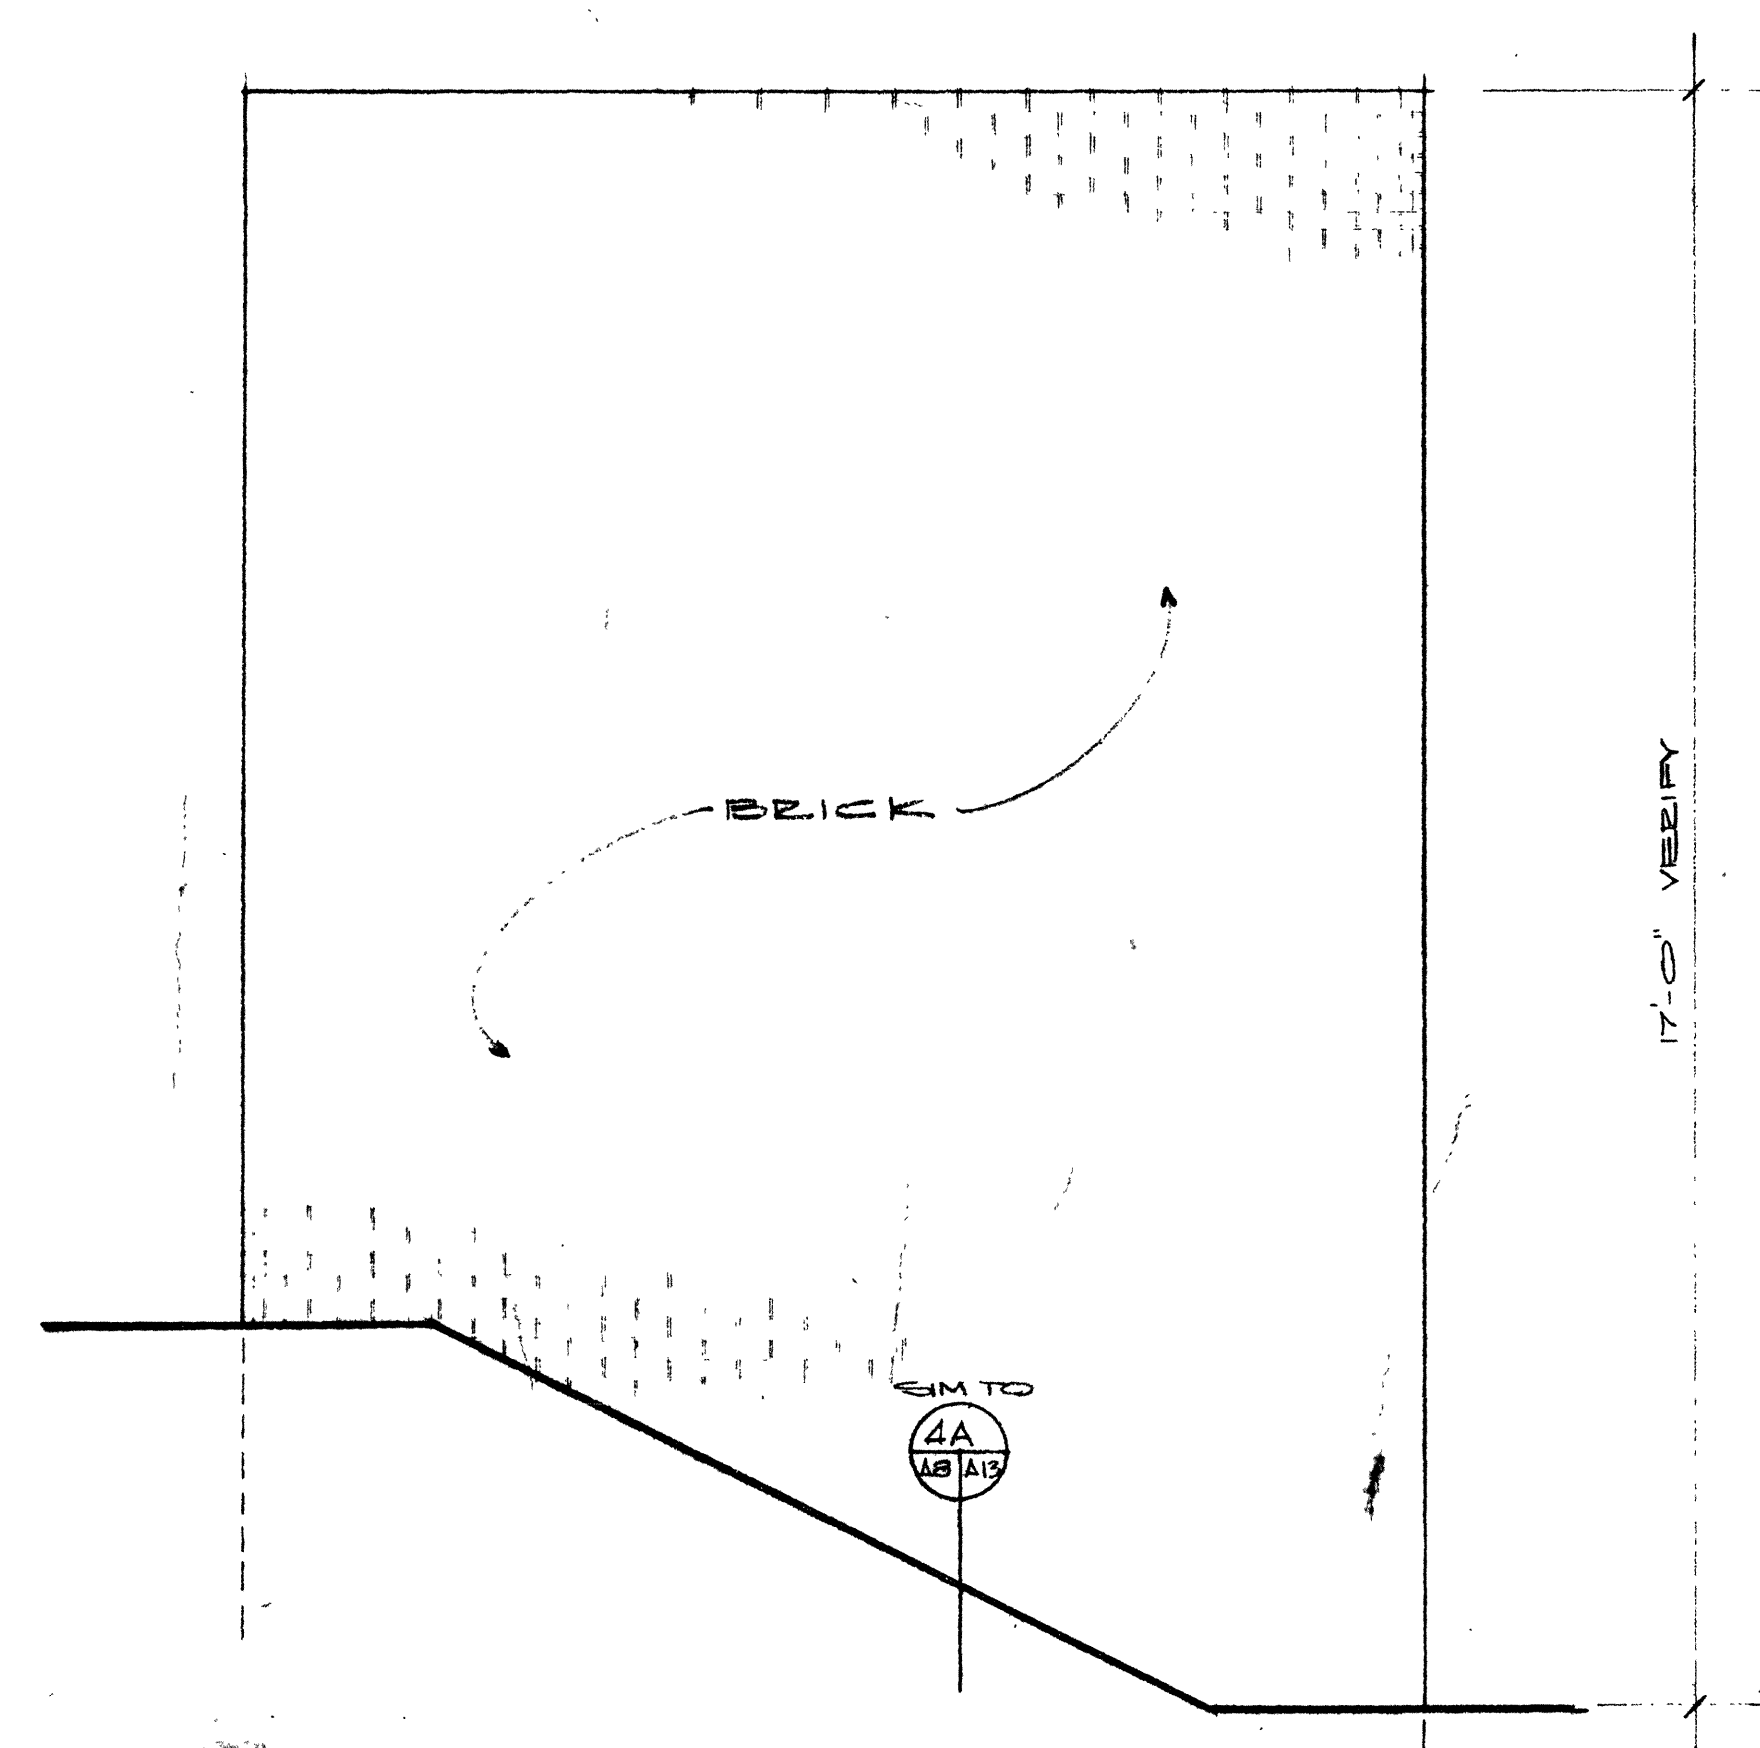

ELEVATION (EAST SIM.)
1/2"=1'-0"

AS BUILT	4/8/69	4/18/69	DYS	TBC
ADDED NOTE - ROOF PLAN	11/15/68	11/15/68	B.D.	1
SEE APPENDUM NO. 1	11/15/68	11/15/68	F.C.W.	1
LTR	REVISIONS	DATE	CHK'D	APP'D
		BY	APP'D	
IO GEV CORNELL SYNCHROTRON LABORATORY CORNELL UNIVERSITY ITHACA, NEW YORK				
TOWER ROAD ACCESS BLDG				
WILLIAM M. BROBECK AND ASSOCIATES IAN MACKINLAY, AIA ARCHITECT PREGNOFF & MATHEU STRUCTURAL ENGR. JACOBS ASSOCIATES CONSTRUCTION ENGR. 950 GILMAN ST. BERKELEY, CALIF. 94710 TELEPHONE 415 - 524 - 8664				
DR. REV'D	CHK.	SUPV.	SCALE	
RELEASED	APPROVED	LAB NUCLEAR STUDIES	SHEET	OF
			7	102
DATE NOV 15, 1968			DRAWING NO. A2	
DATE JAN 15, 1969			WMB & A NO. 1144	
21085-33-65-102 044 204 Cornell University B. & P.				