

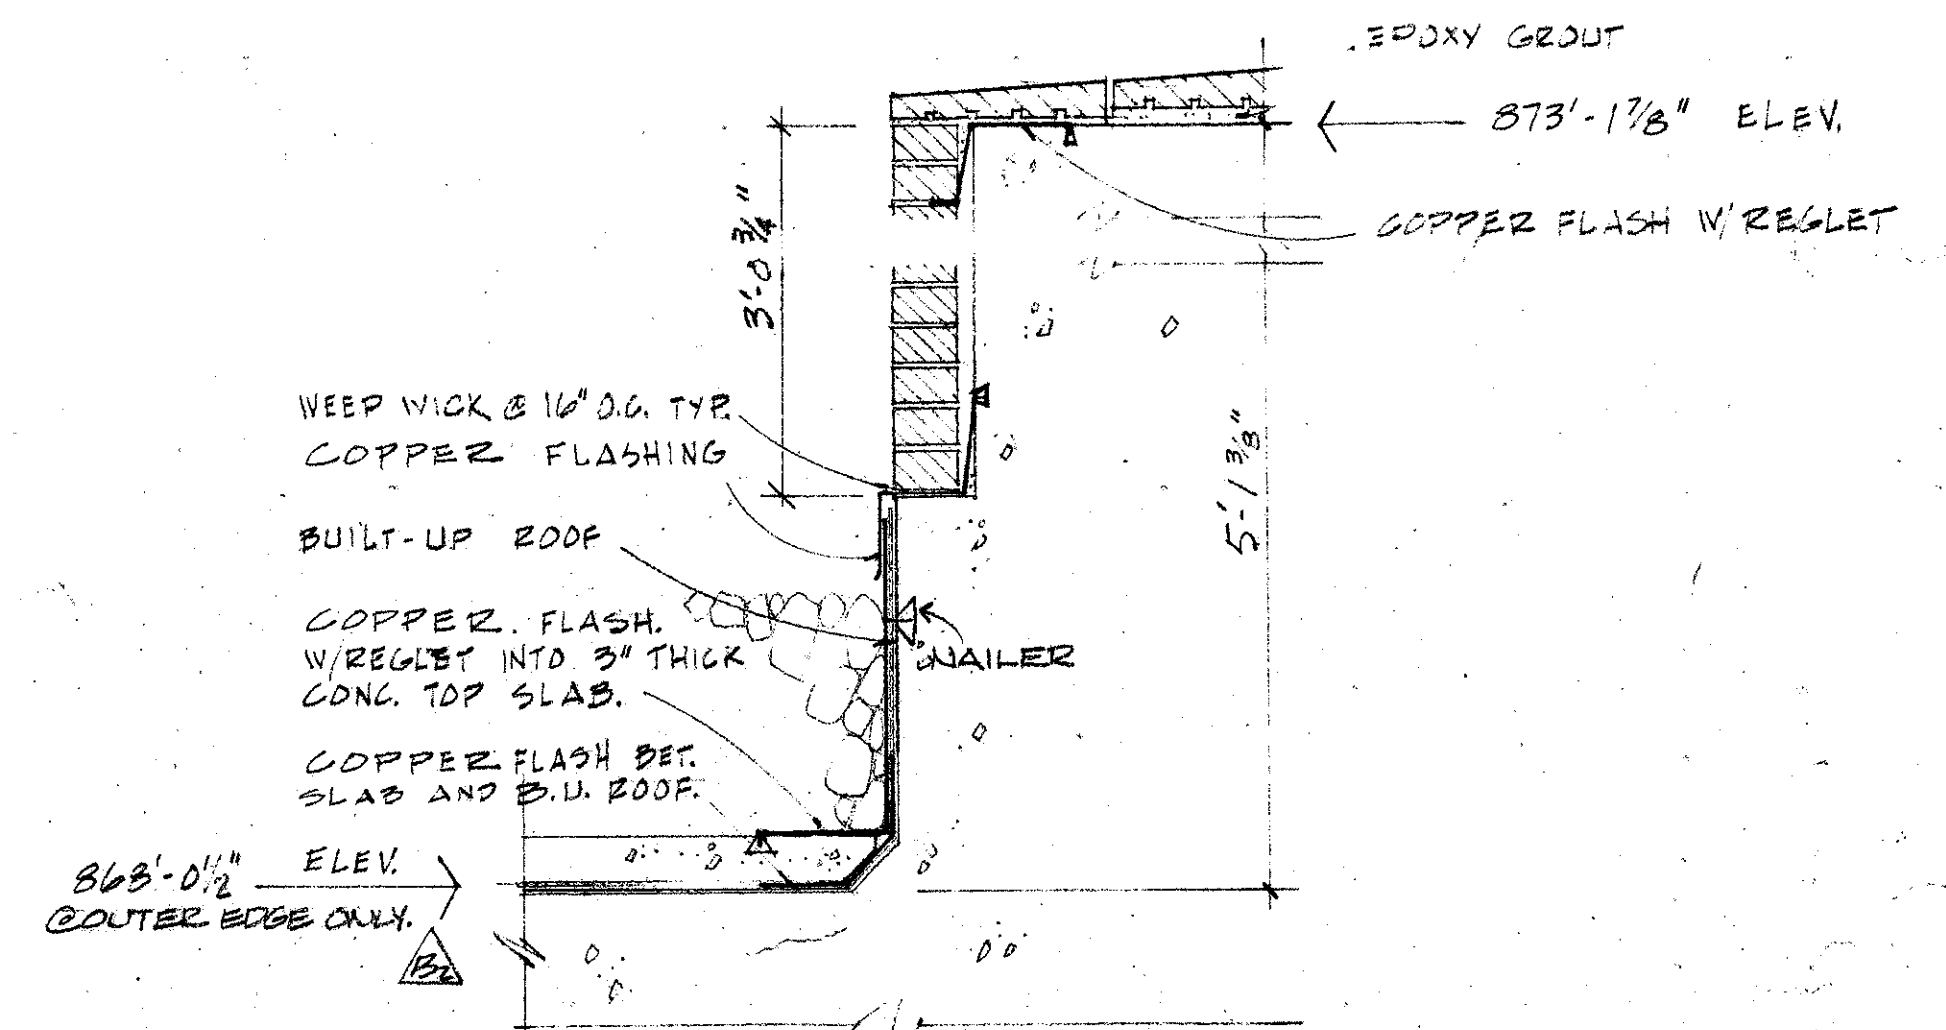


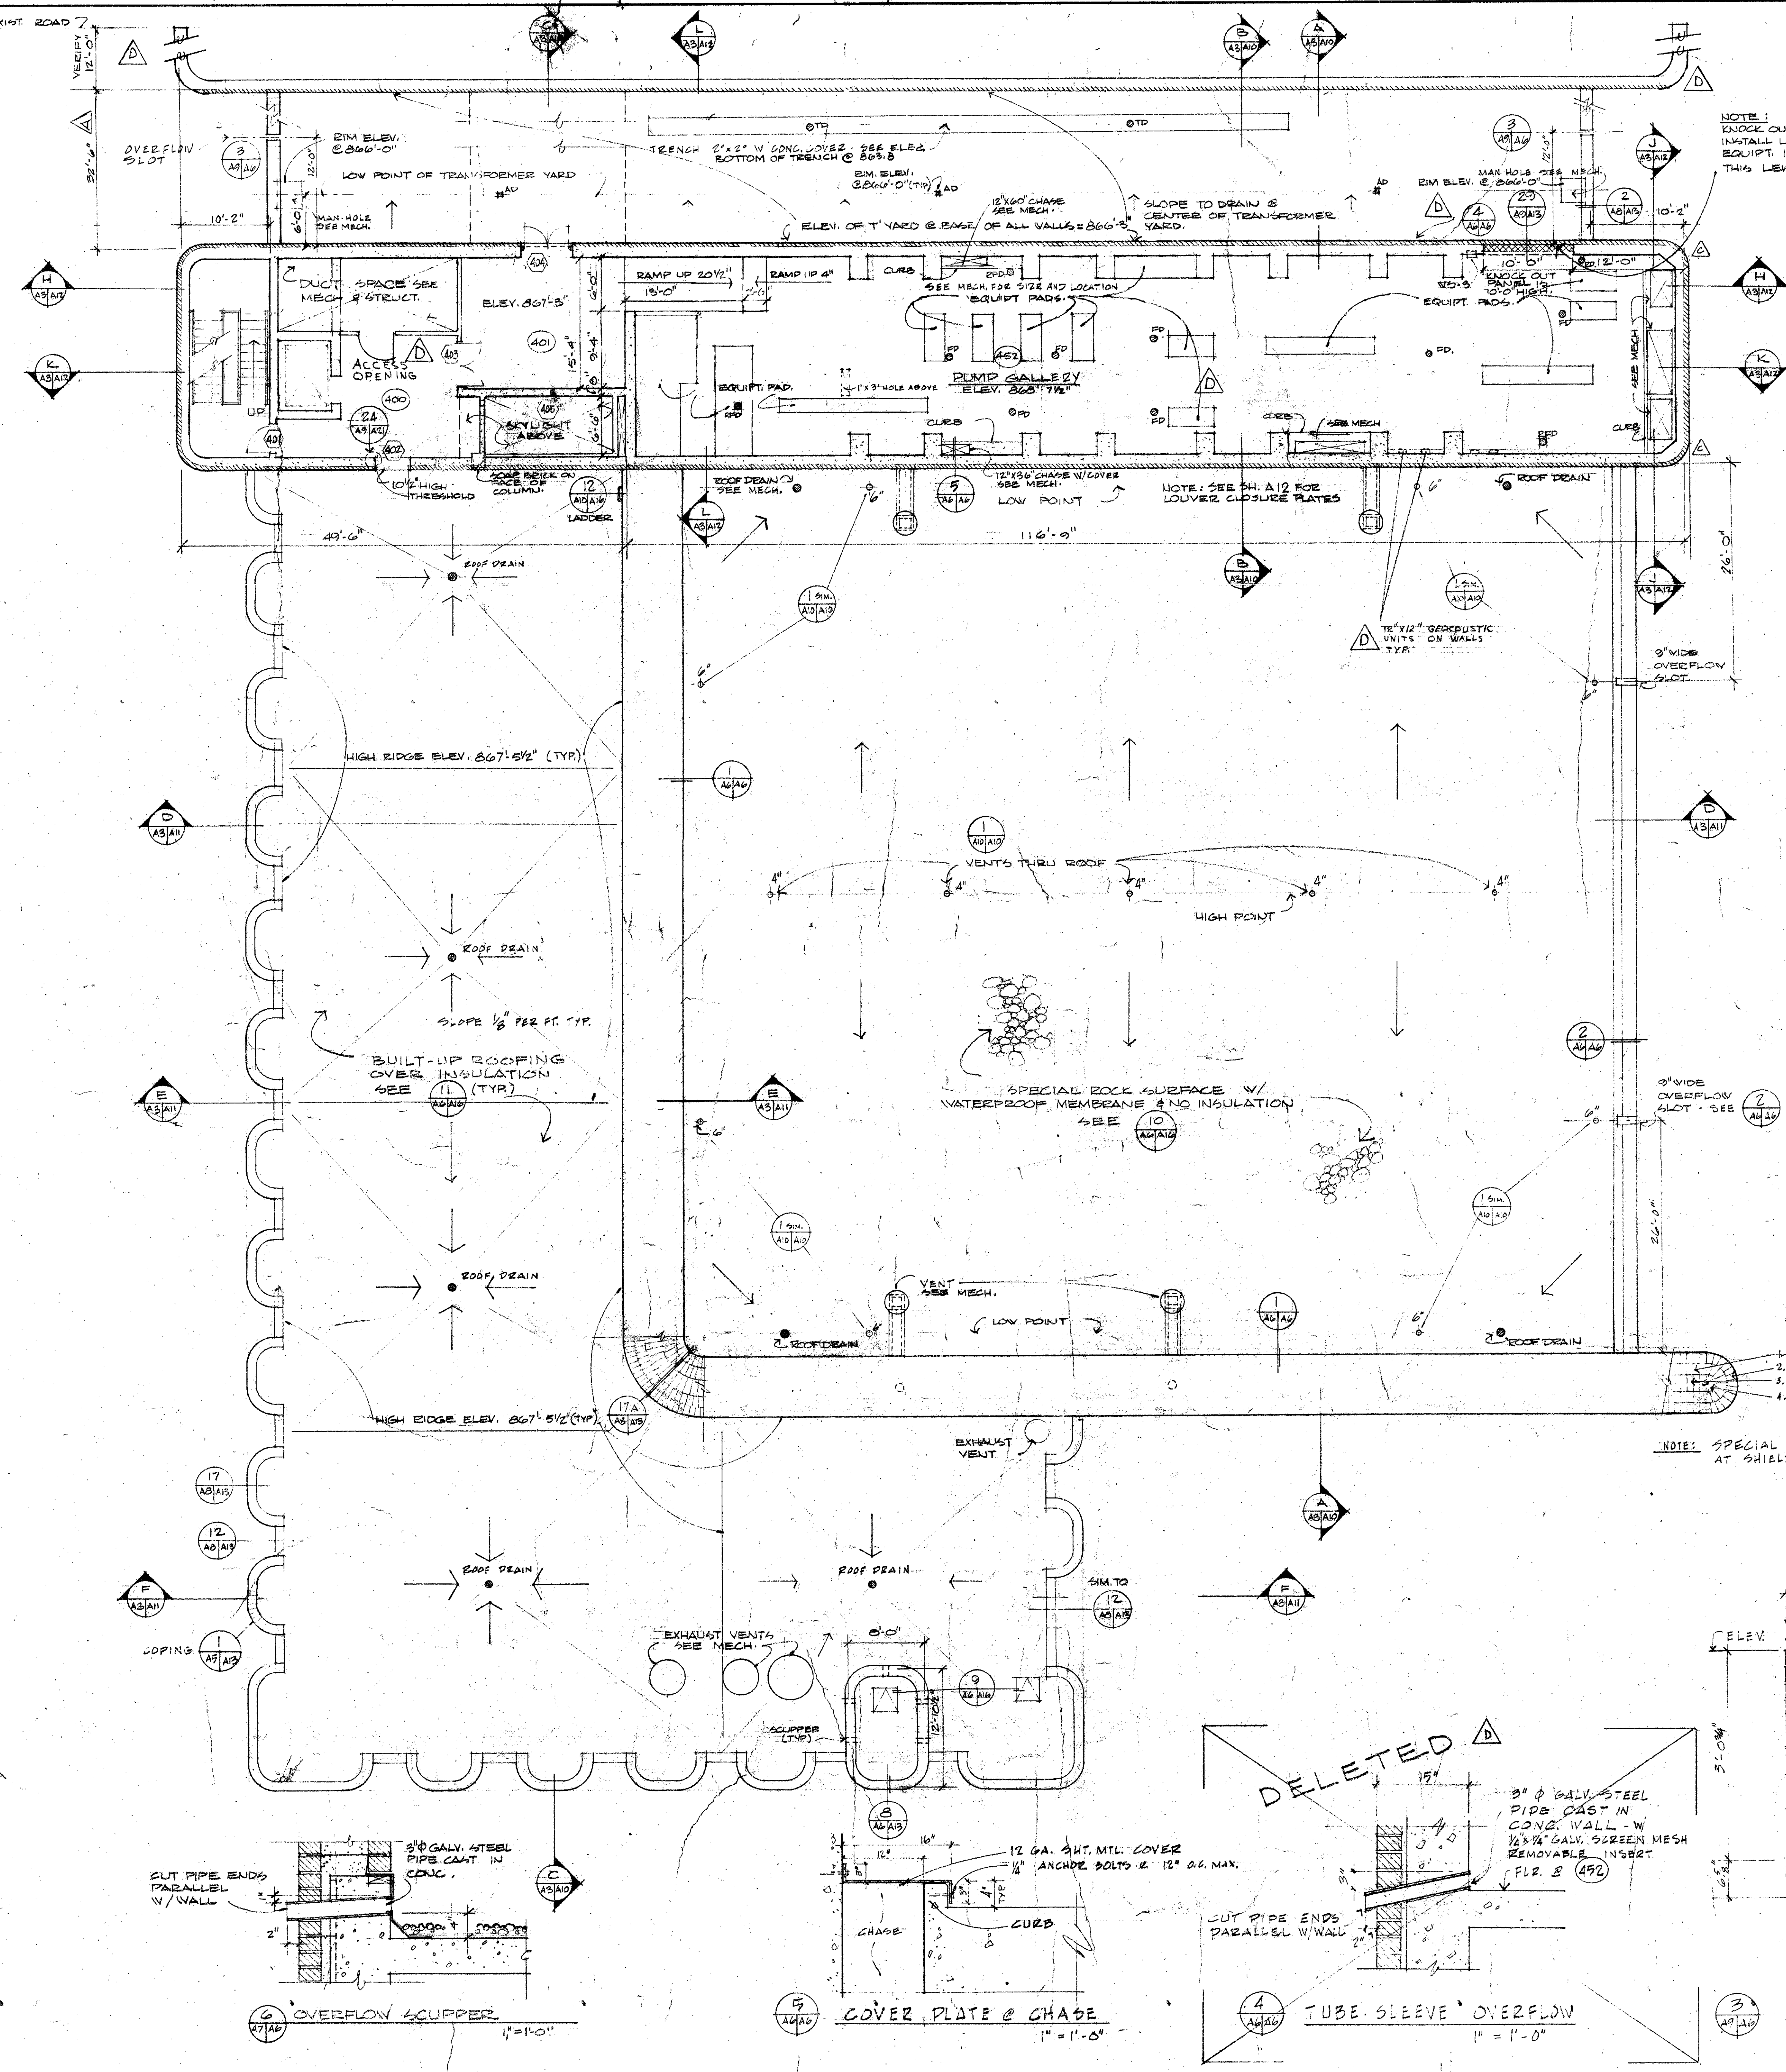


1 SHIELDING WALL & ROOF of SYNCHROTRON HALL
1" = 1'-0"

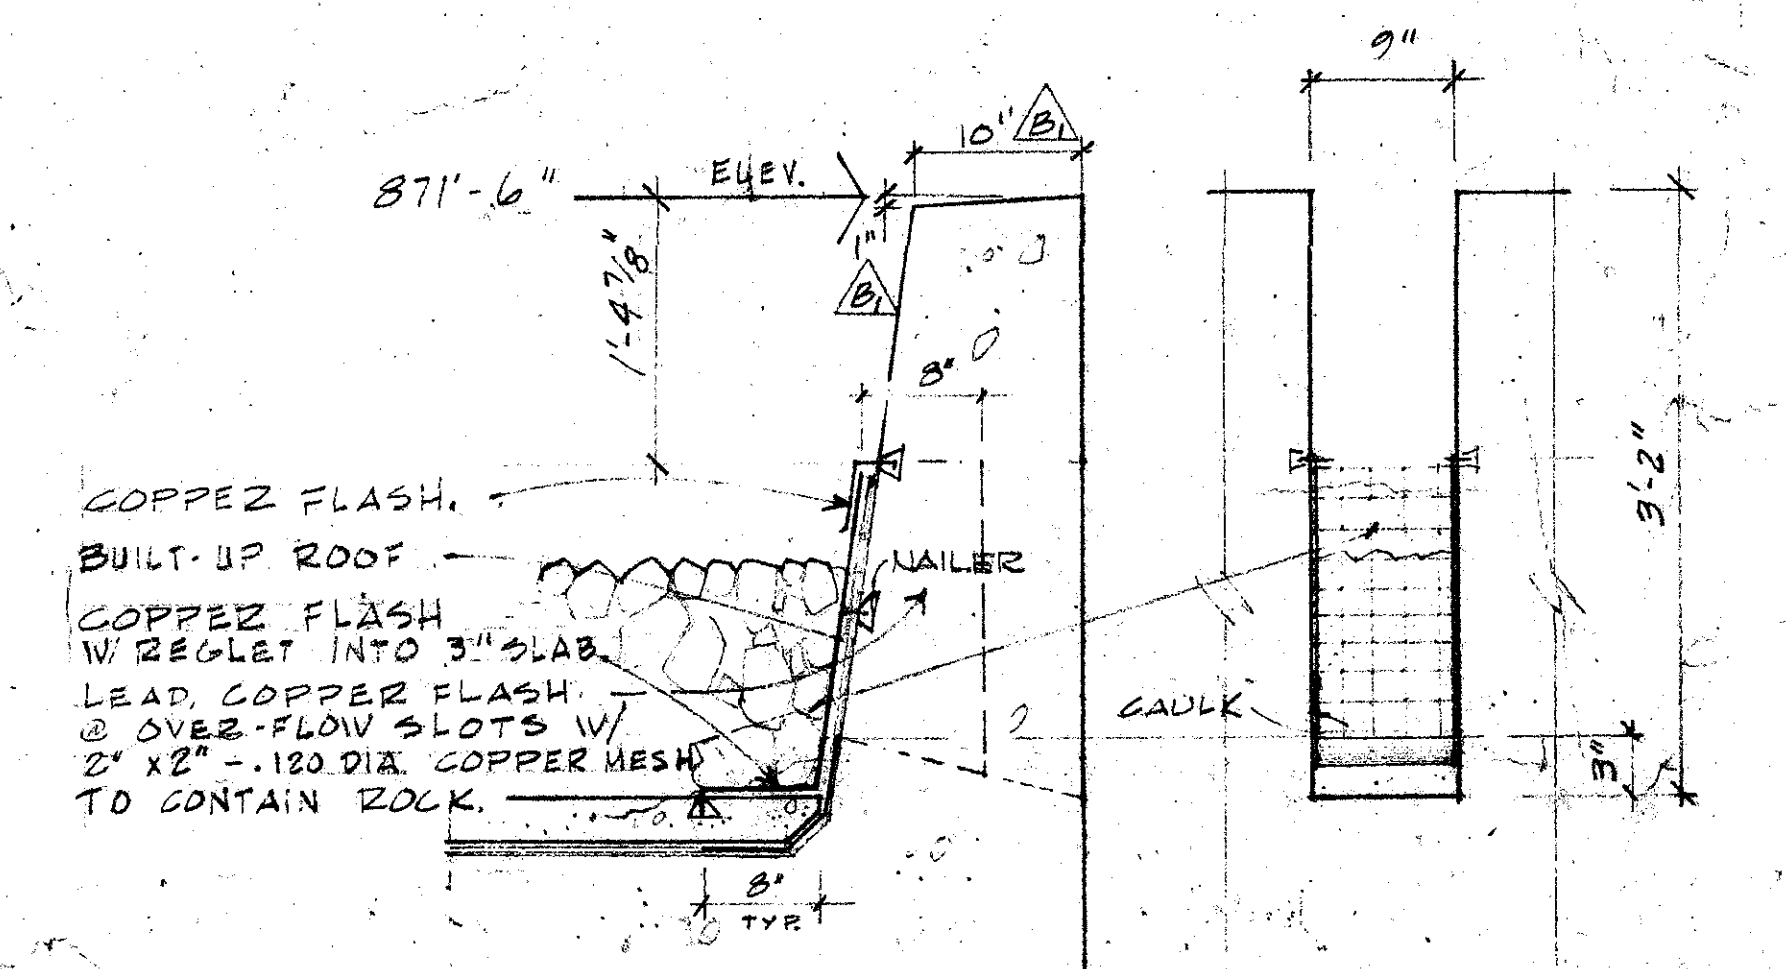


2 SECTION & PARAPET of CONCRETE EAST WALL
ELEVATION OF OVERFLOW SLOT
2 EAST SHIELDING WALL @ ROOF
1" = 1'-0"

- 1. TYP. COPING BRICK STRAIGHT WALLS
- 2. SPECIAL COPING BRICK @ CURVE
- 3. SPECIAL COPING BRICK @ RIDGE
- 4. SPECIAL COPING BRICK @ END OF RIDGE


NOTE: SPECIAL COPING BRICK AT SHIELD WALL

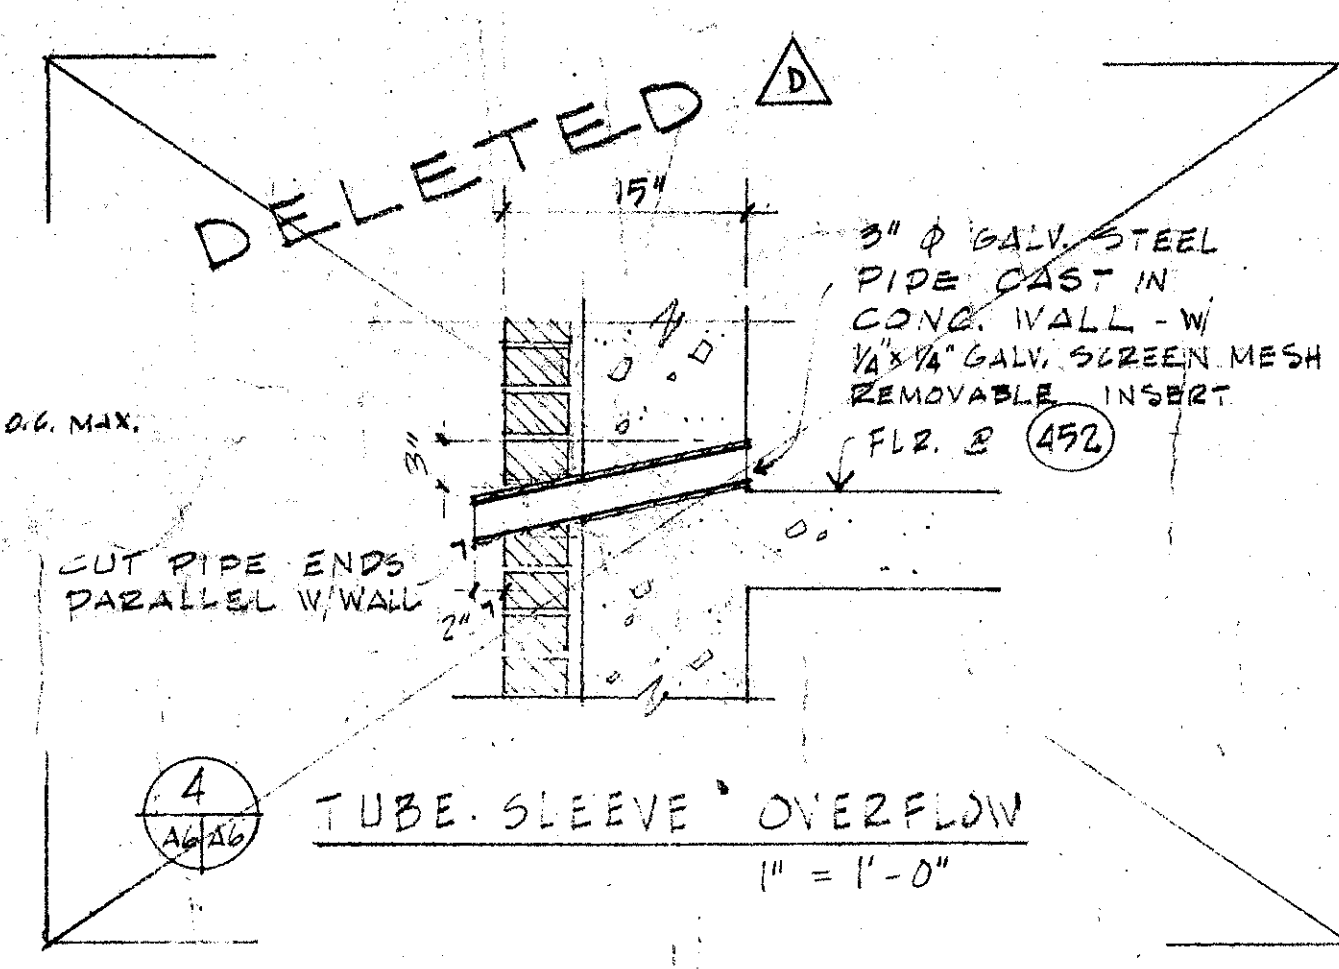

5 COVER PLATE @ CHASE
1" = 1'-0"

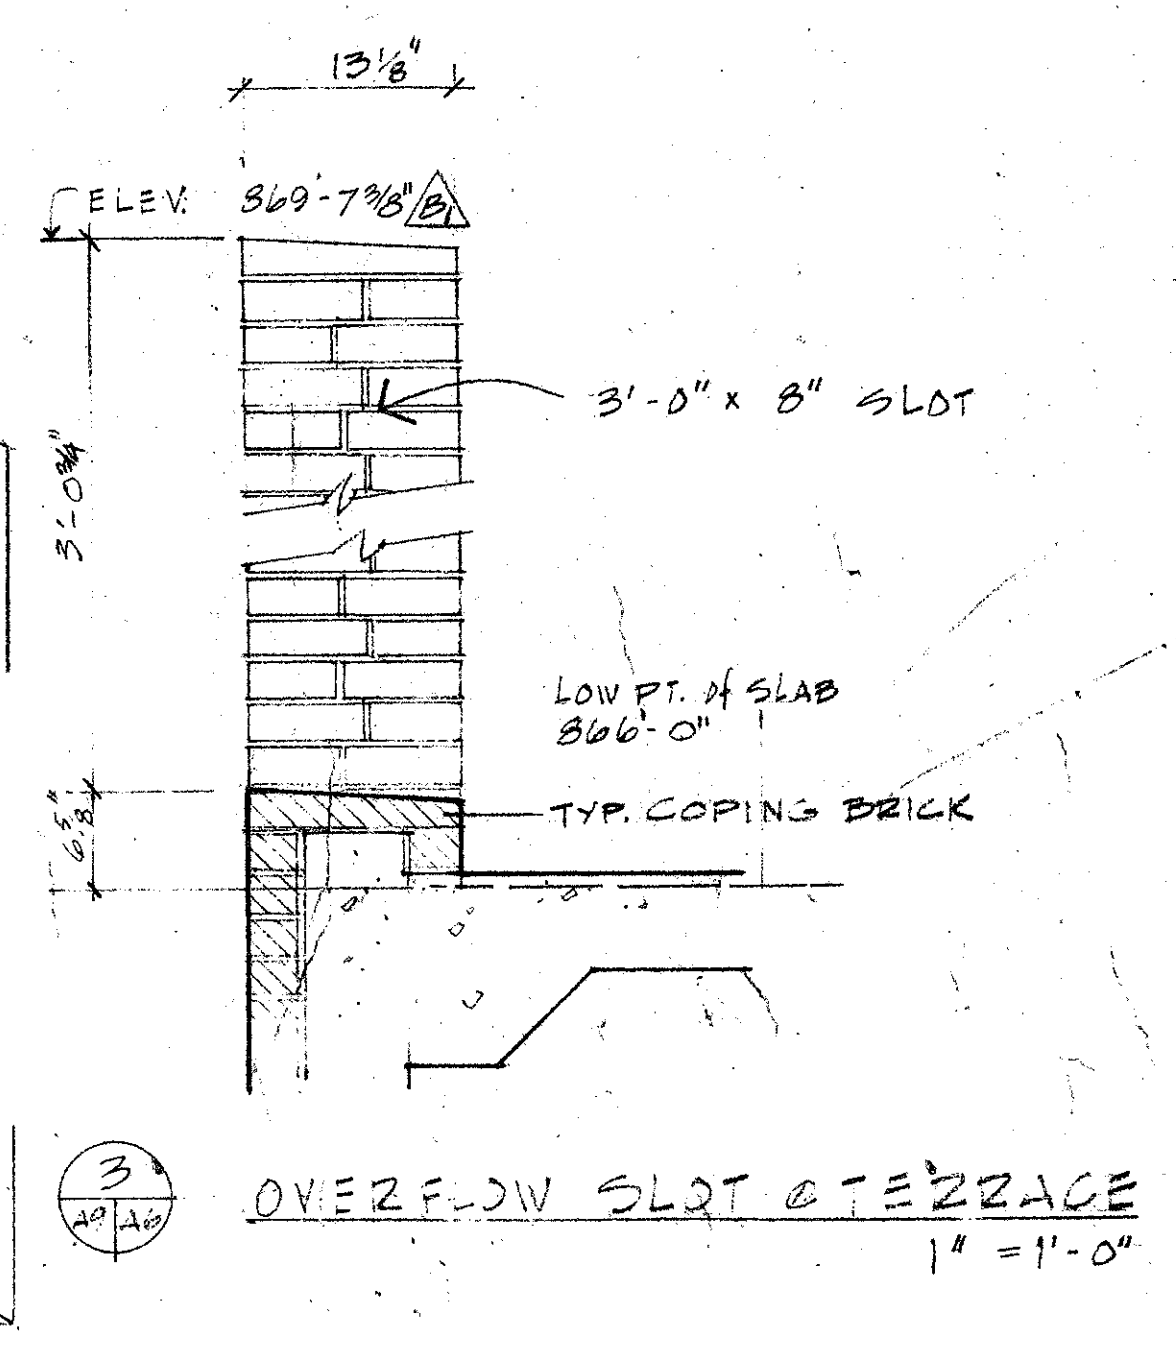

3 OVERFLOW SLOT @ TERRACE
1" = 1'-0"

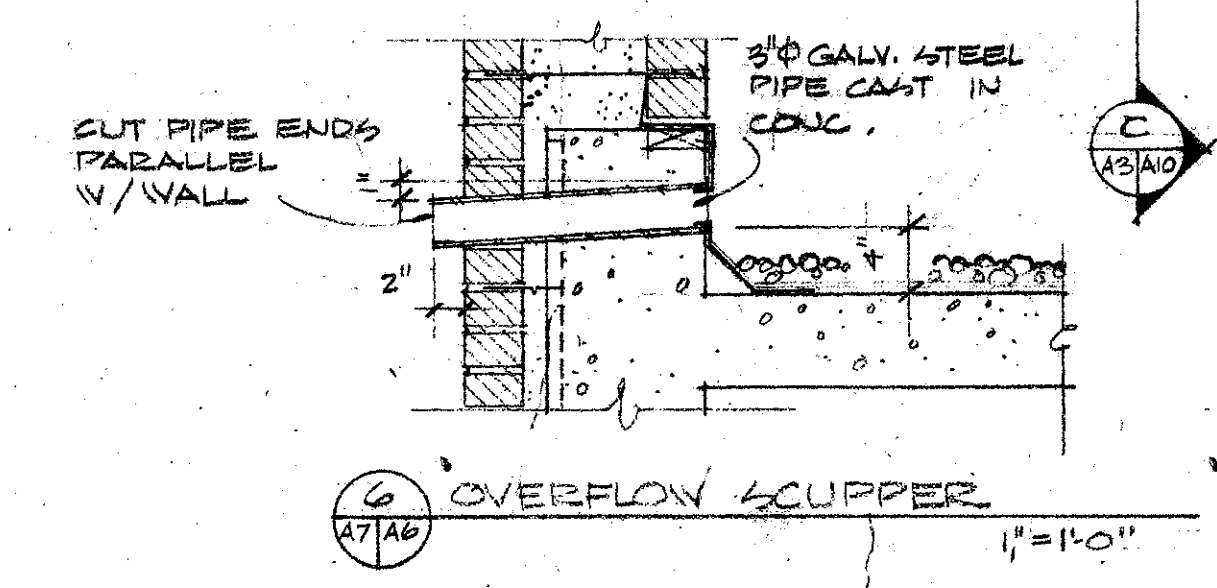

6 OVERFLOW SCUPPER
1" = 1'-0"

AS BUILT	4-1-80	4-1-80	
CORRECT CORNERS CASE	5-1-80	5-1-80	
3. ADD NOTE DET. 1.	10-1-80	10-1-80	
1. ADD OR CORRECT DIMENSION	10-1-80	10-1-80	
SEE APPENDIX NO. 1	11-1-80	11-1-80	
LTR	REVISIONS	DATE	CHKD APPD
		BY	
IO GEV CORNELL SYNCHROTRON LABORATORY CORNELL UNIVERSITY ITHACA NEW YORK			
FOURTH LEVEL PLAN ROOF FLASHING DETAILS			
WILLIAM M. BROBECK AND ASSOCIATES IAN MACKINLAY, AIA ARCHITECT PREGNOFF & MATHEU STRUCTURAL ENGR. JACOBS ASSOCIATES CONSTRUCTION ENGR. 950 GILMAN ST. BERKELEY, CALIF. 94710 TELEPHONE 415-524-8664			
DR. ED. H.H.	CHK.	SUPV.	SCALE
RELEASED		APPROVED	1/8" = 1'-0"
		LAB NUCLEAR STUDIES	SHEET 11 OF 102
			DRAWING NO.
			A6
DATE NOV 15, 1983	DATE JAN 15, 1986	WMB & A NO. 1113	
2085-33-65-006 044 212 Cornell University B. & P.			