
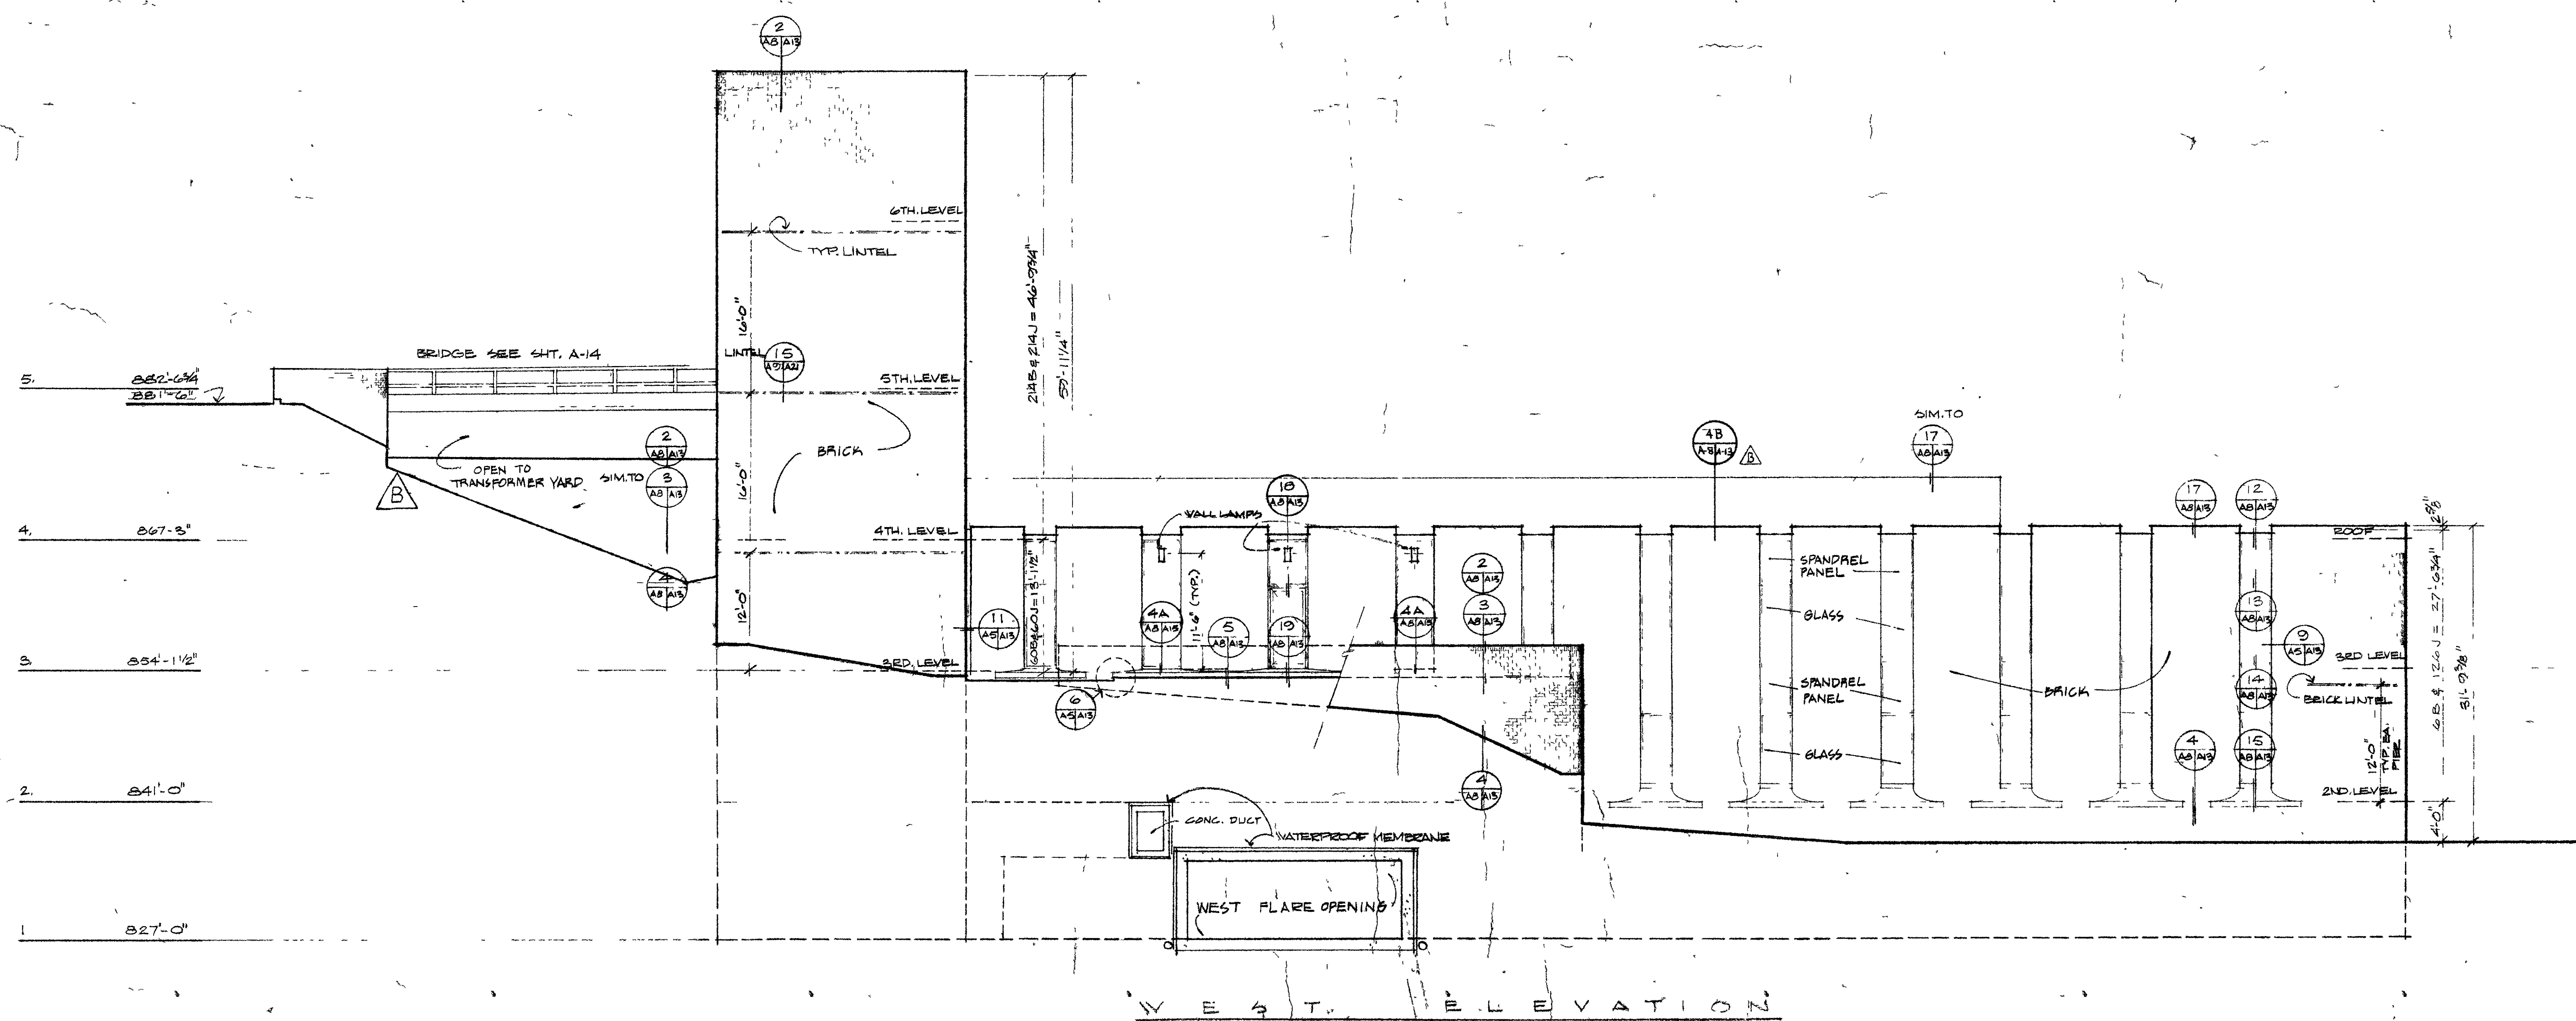


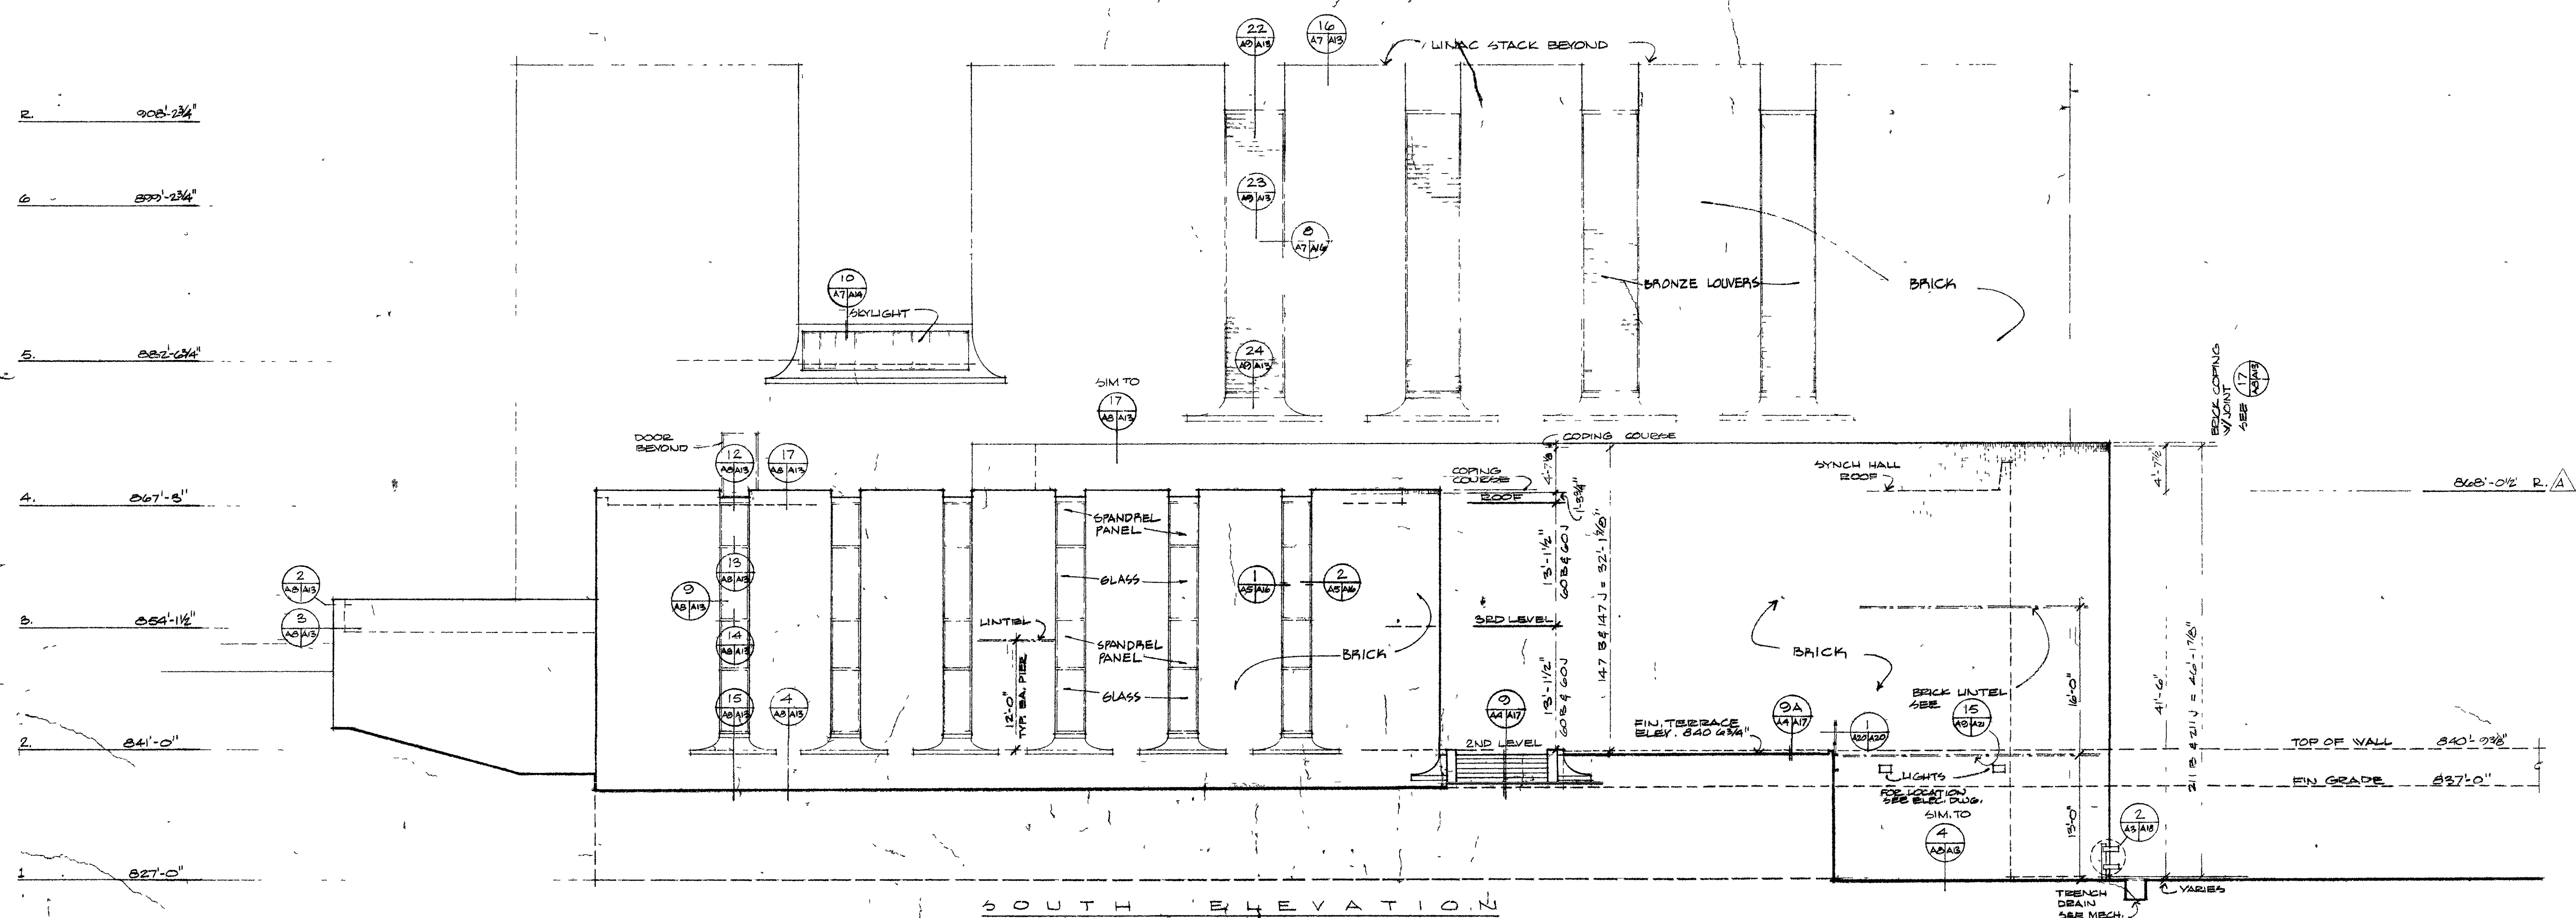

AS BUILT		4-22-69	4-22-69	
CORRECT ROOF ELEV. (SOUTH)		DY 5	77C	
LTR	REVISIONS	DATE	CHK'D	APP'D
		BY	APP'D	

**IO GEV CORNELL
SYNCHROTRON LABORATORY
CORNELL UNIVERSITY
ITHACA**

ELEVATIONS

WILLIAM M. BROBECK AND ASSOCIATES
IAN MACKINLAY, AIA ARCHITECT
PREGNOFF & MATHEU STRUCTURAL ENGR.
JACOBS ASSOCIATES CONSTRUCTION ENGR.
950 GILMAN ST. BERKELEY, CALIF. 94710
TELEPHONE 415 - 824 - 8664

DR. B.D.	CHK.	SUPV.	SCALE
RELEASED	APPROVED	LAB NUCLEAR STUDIES	1/8" = 1'-0"
DATE MAY 15, 1983	DATE JAN 15, 1986	WMB & A NO. 1115	

2785-33-65-008 044 214 Cornell University B & P
110