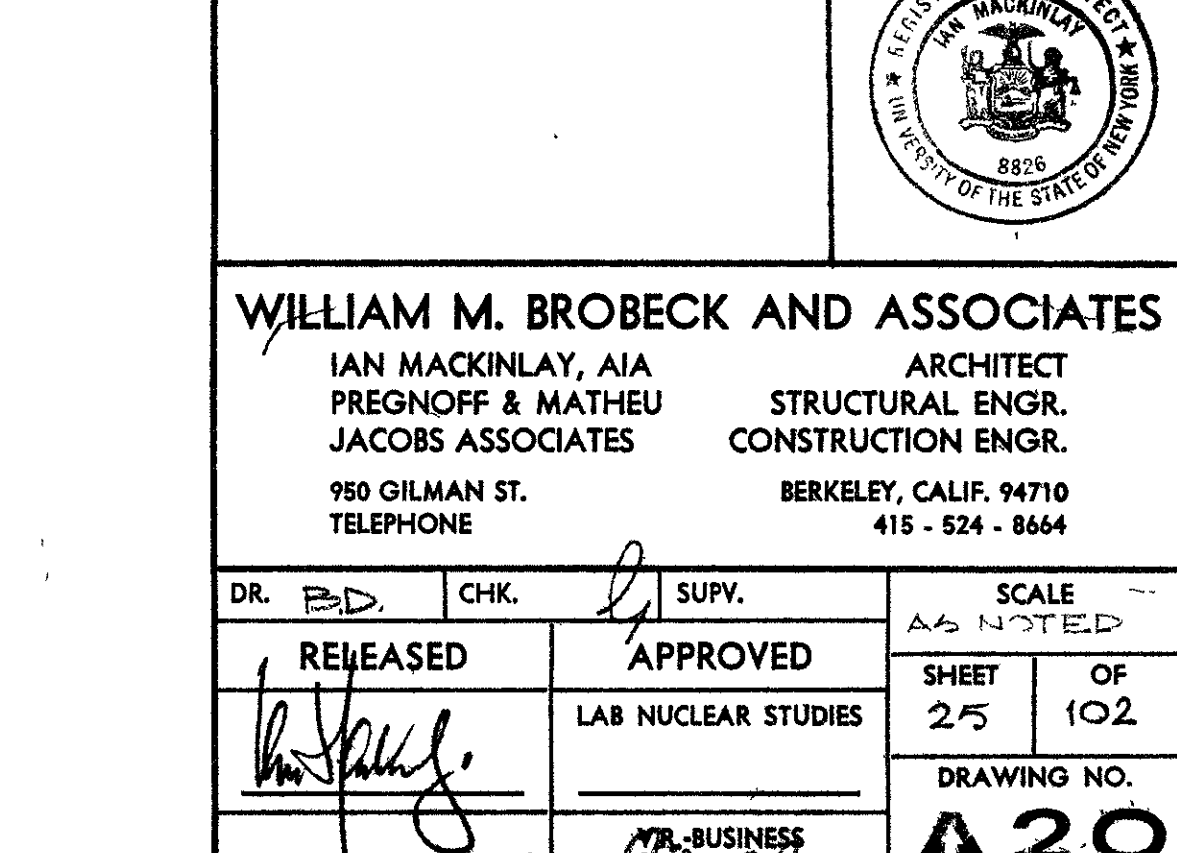
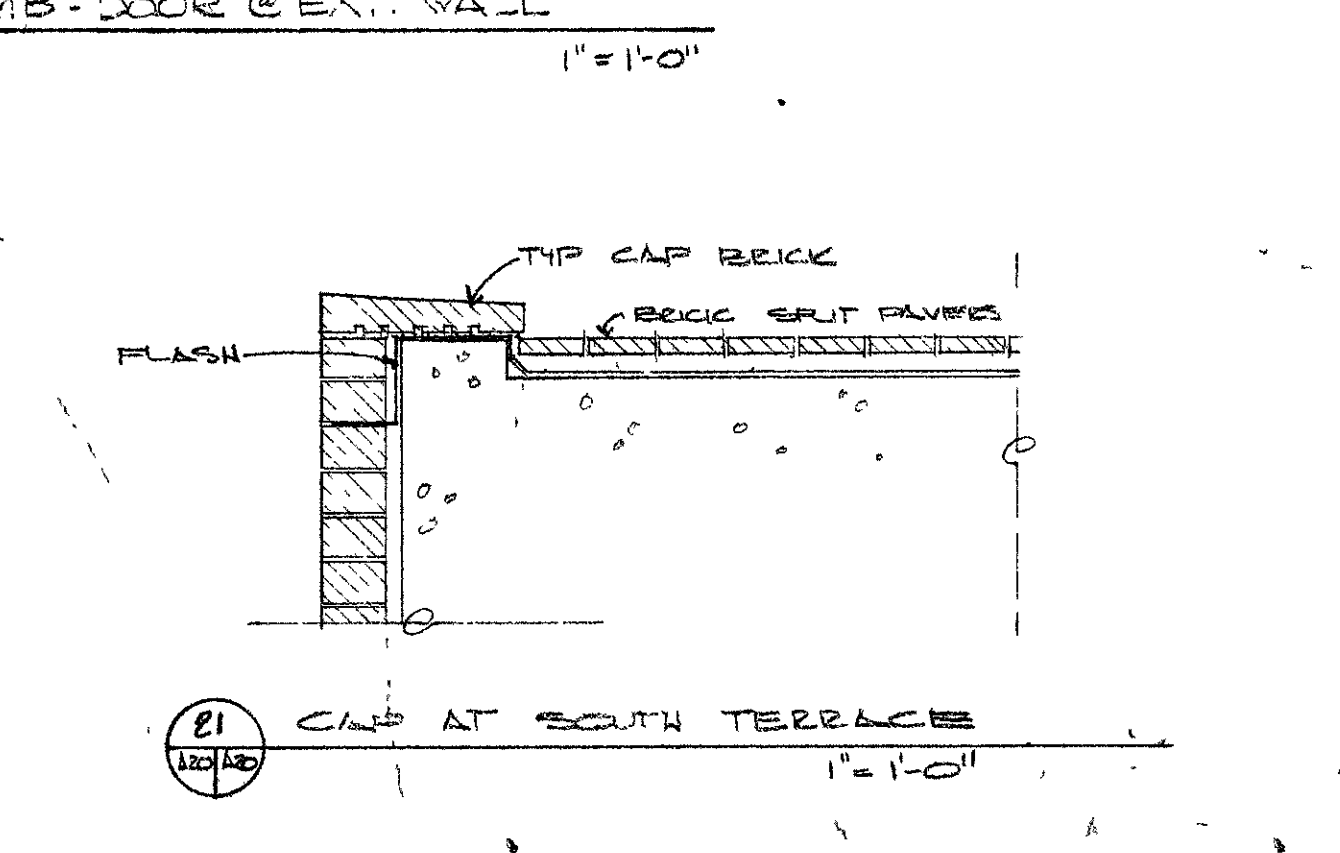
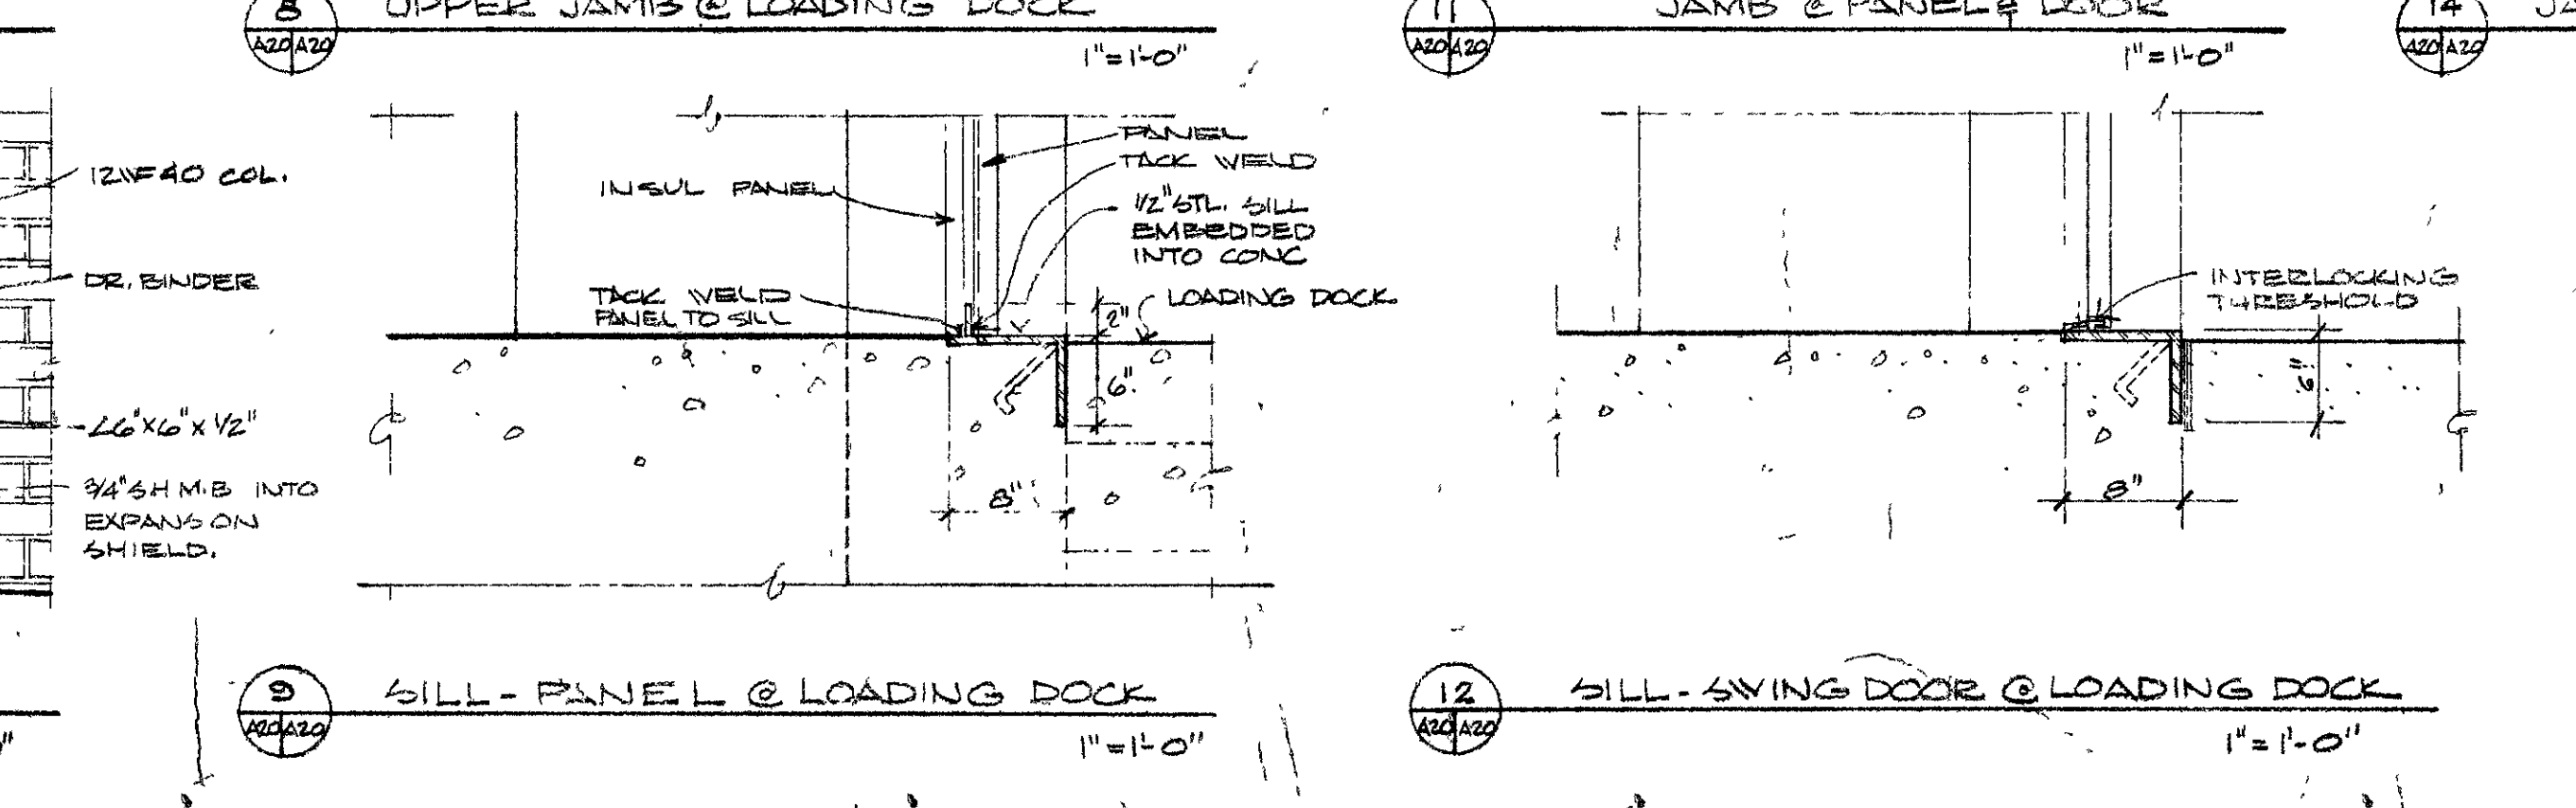
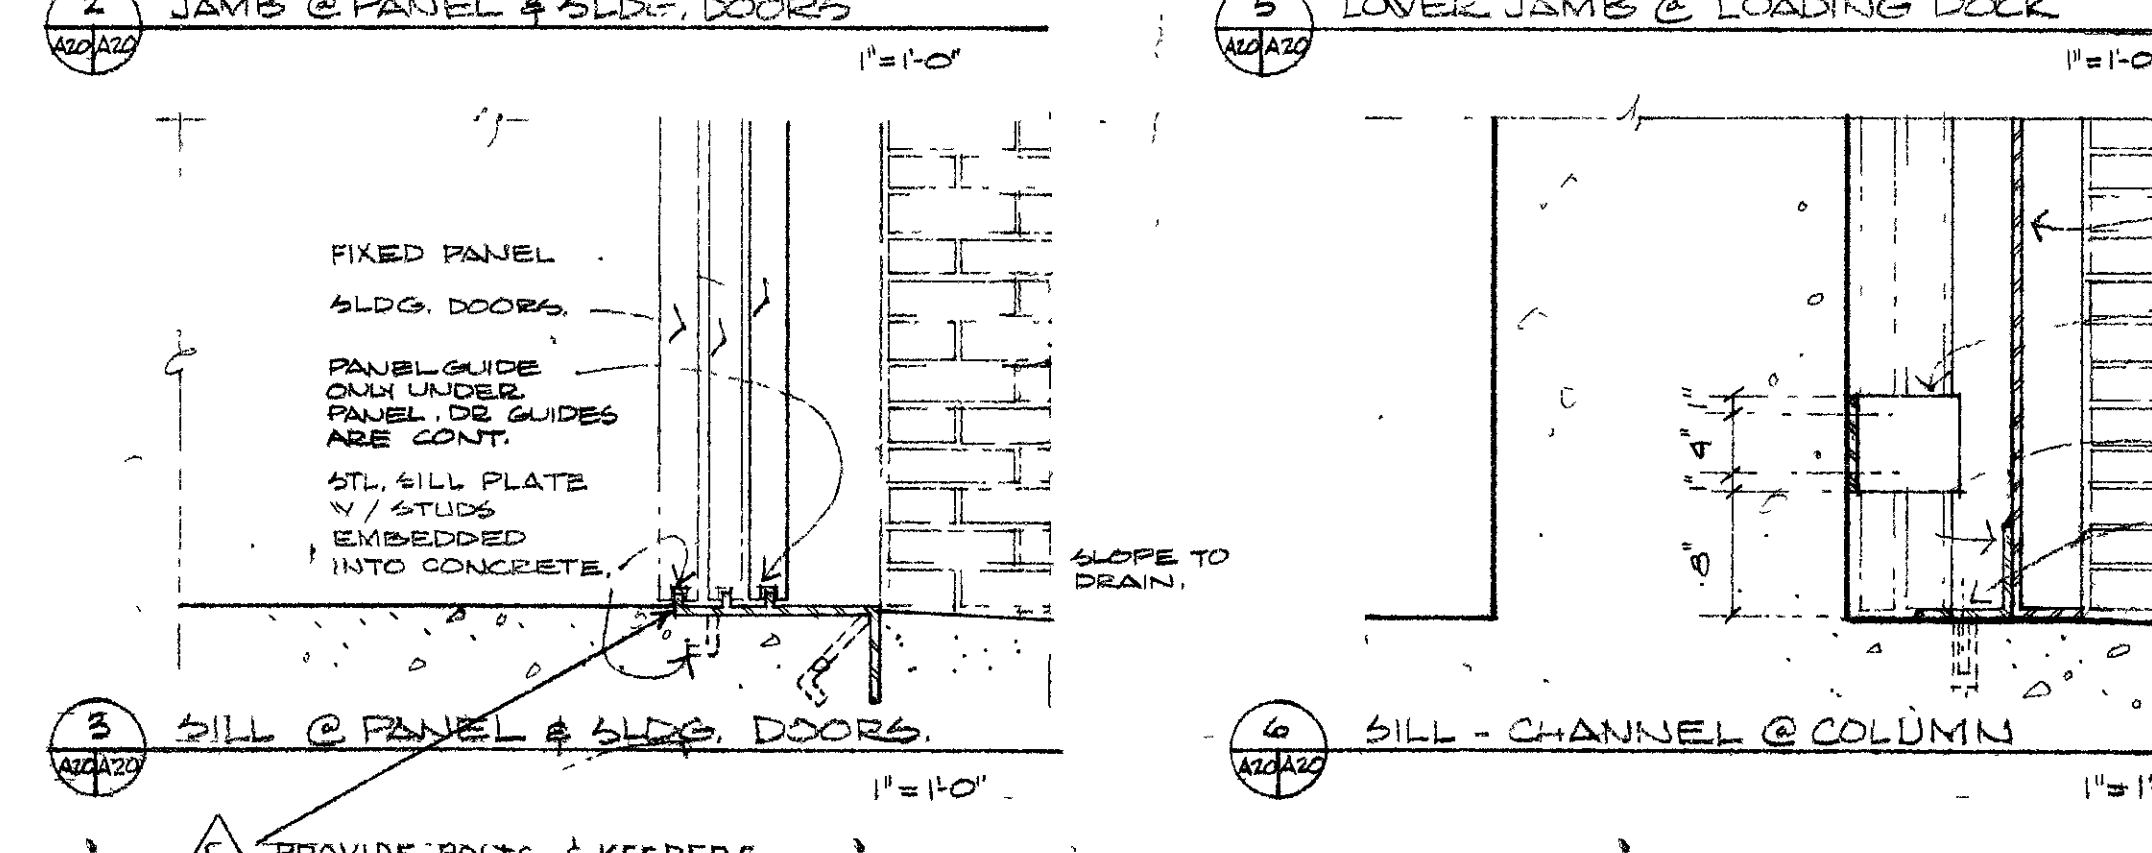
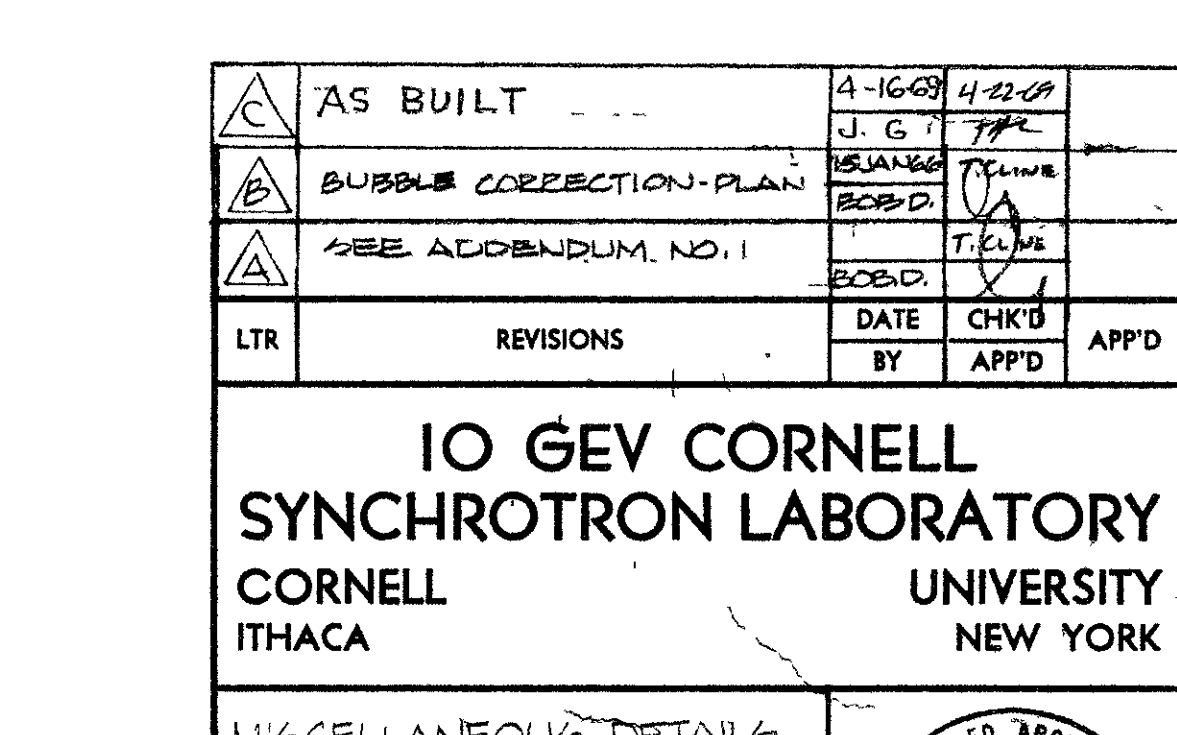
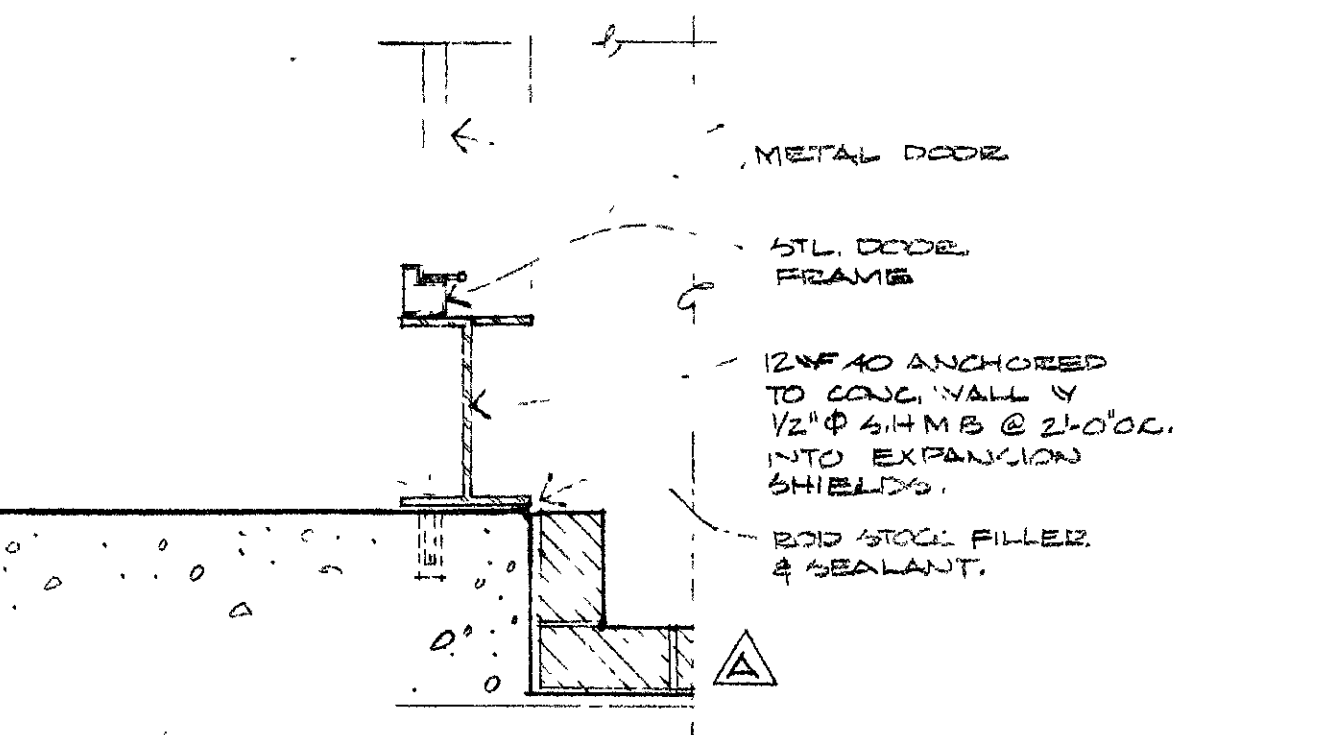
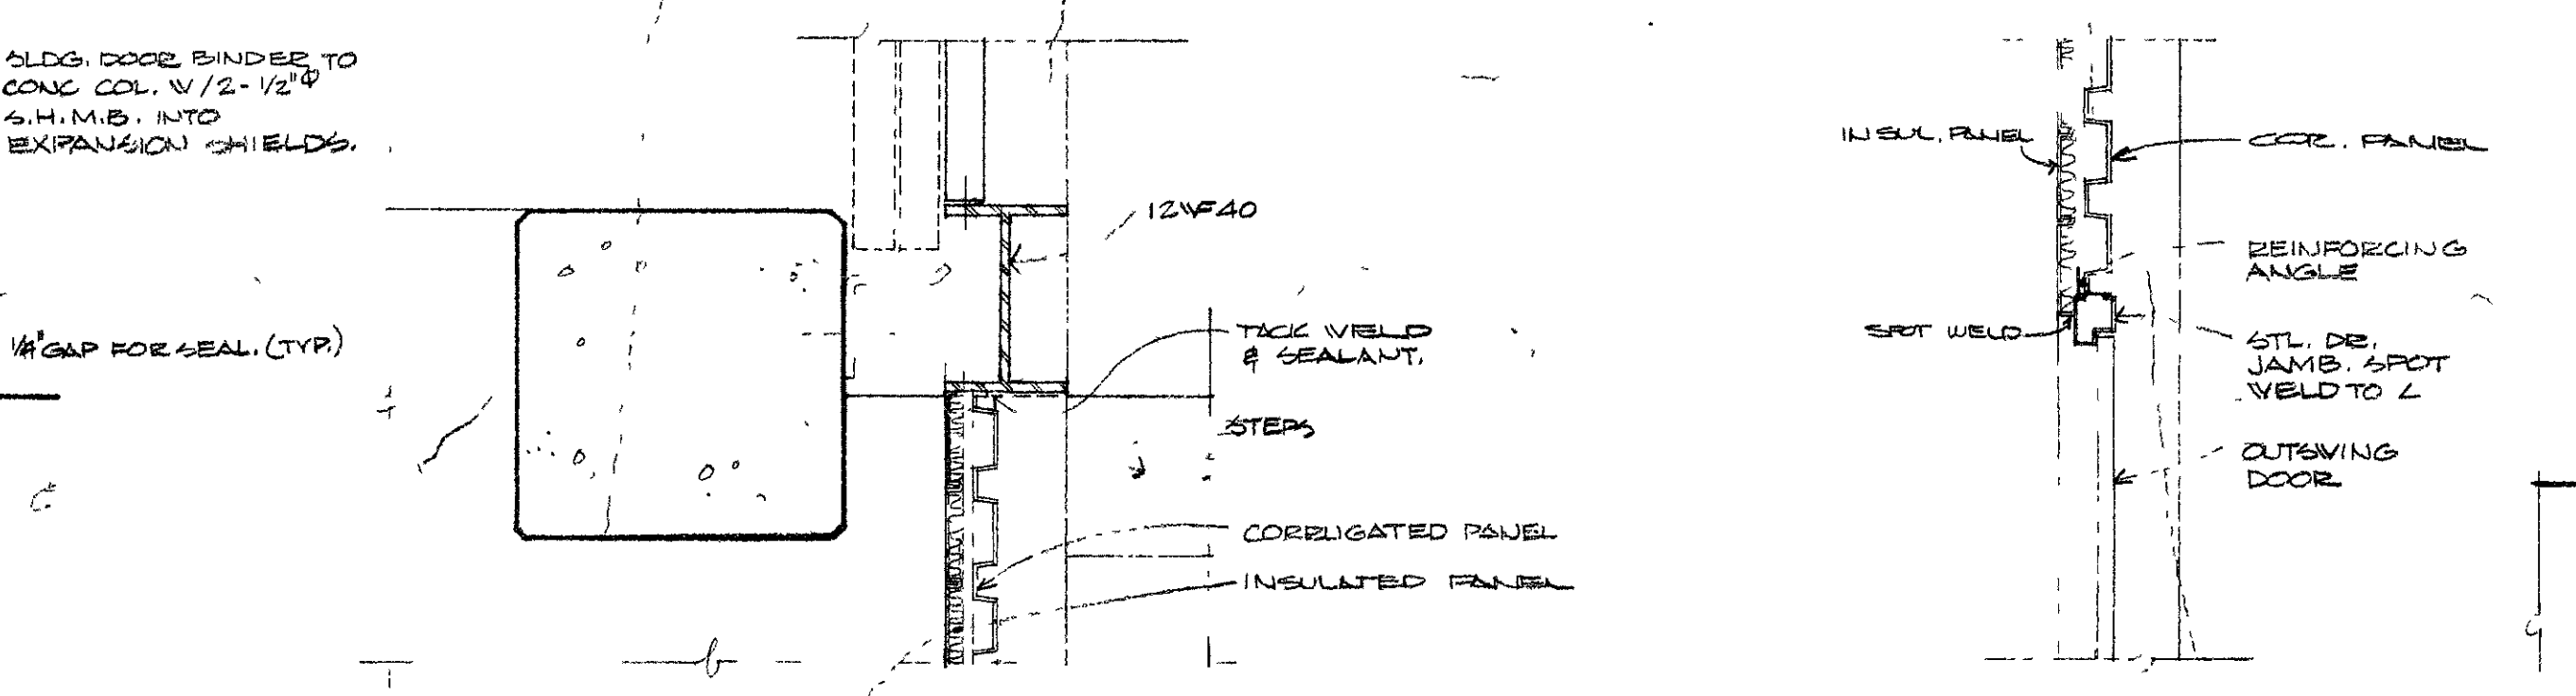
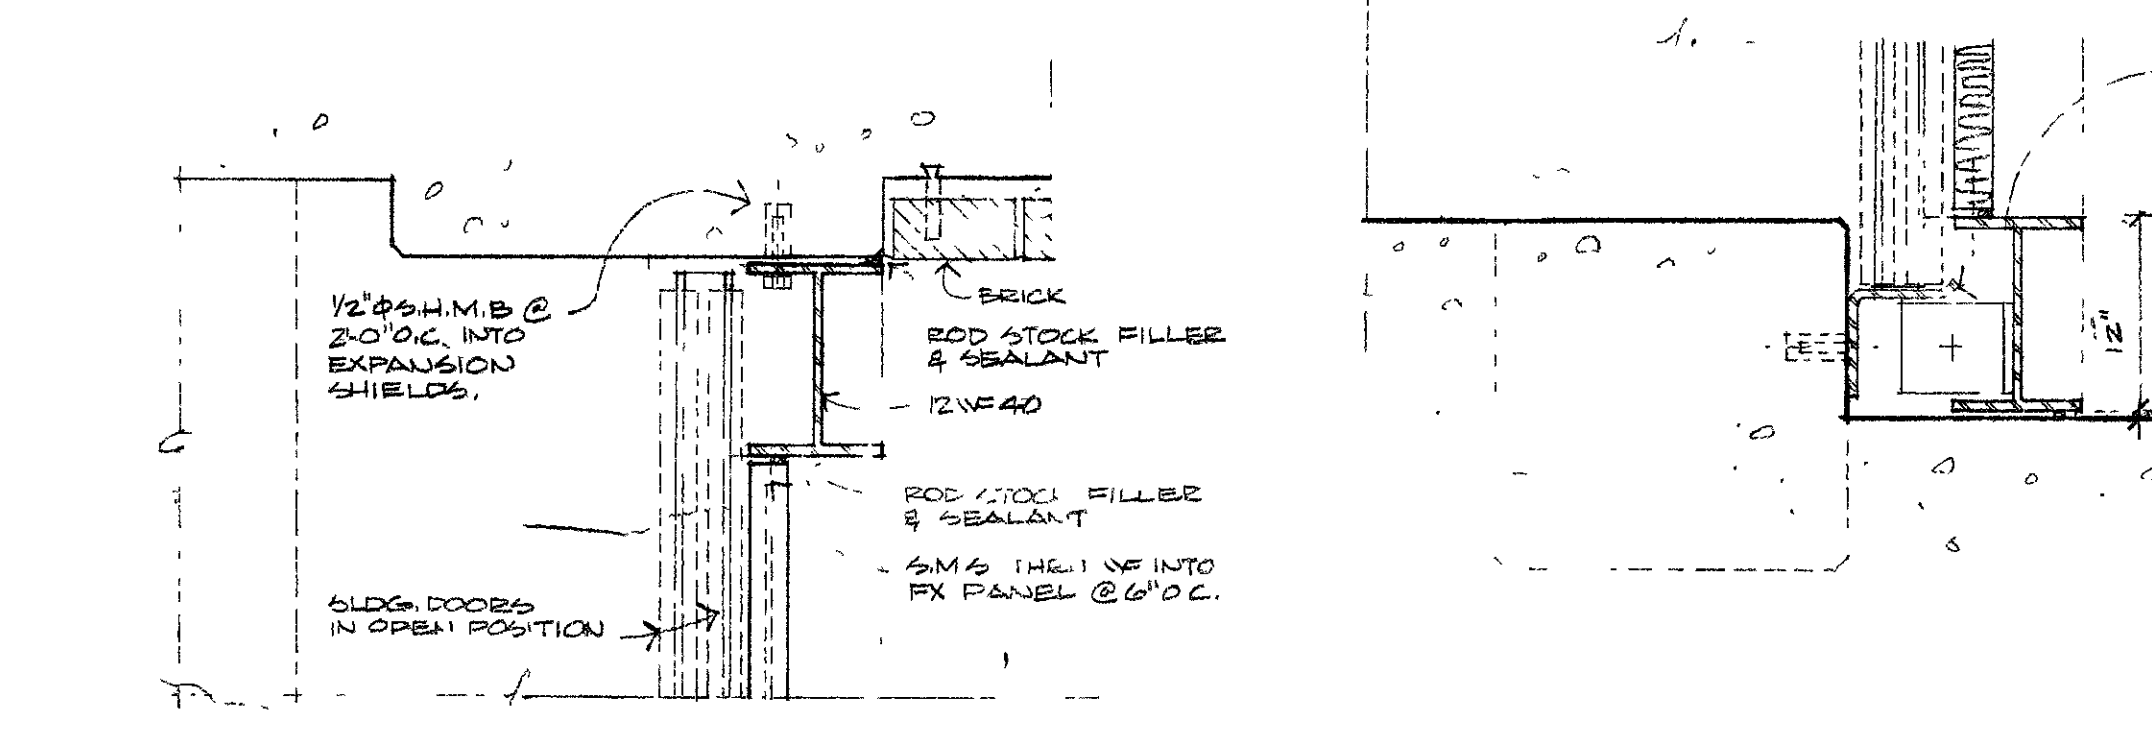
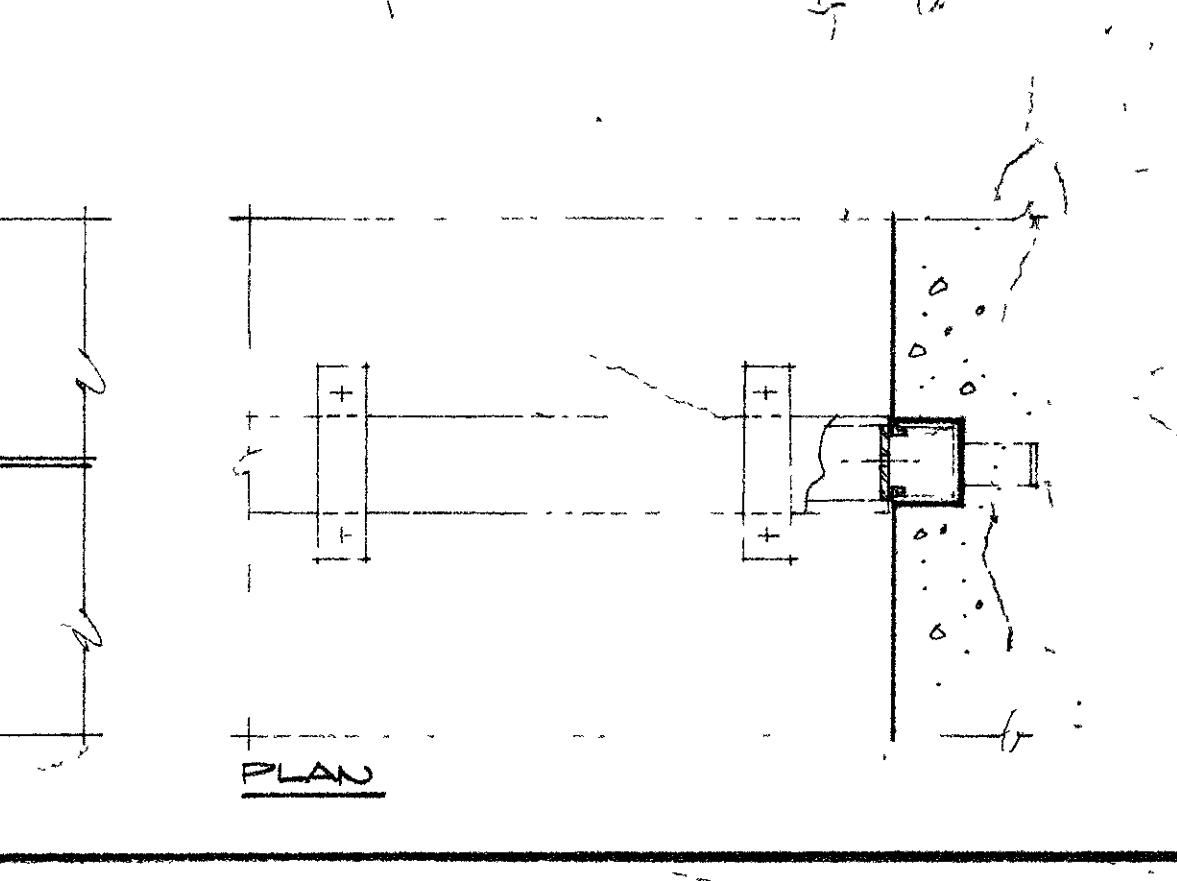
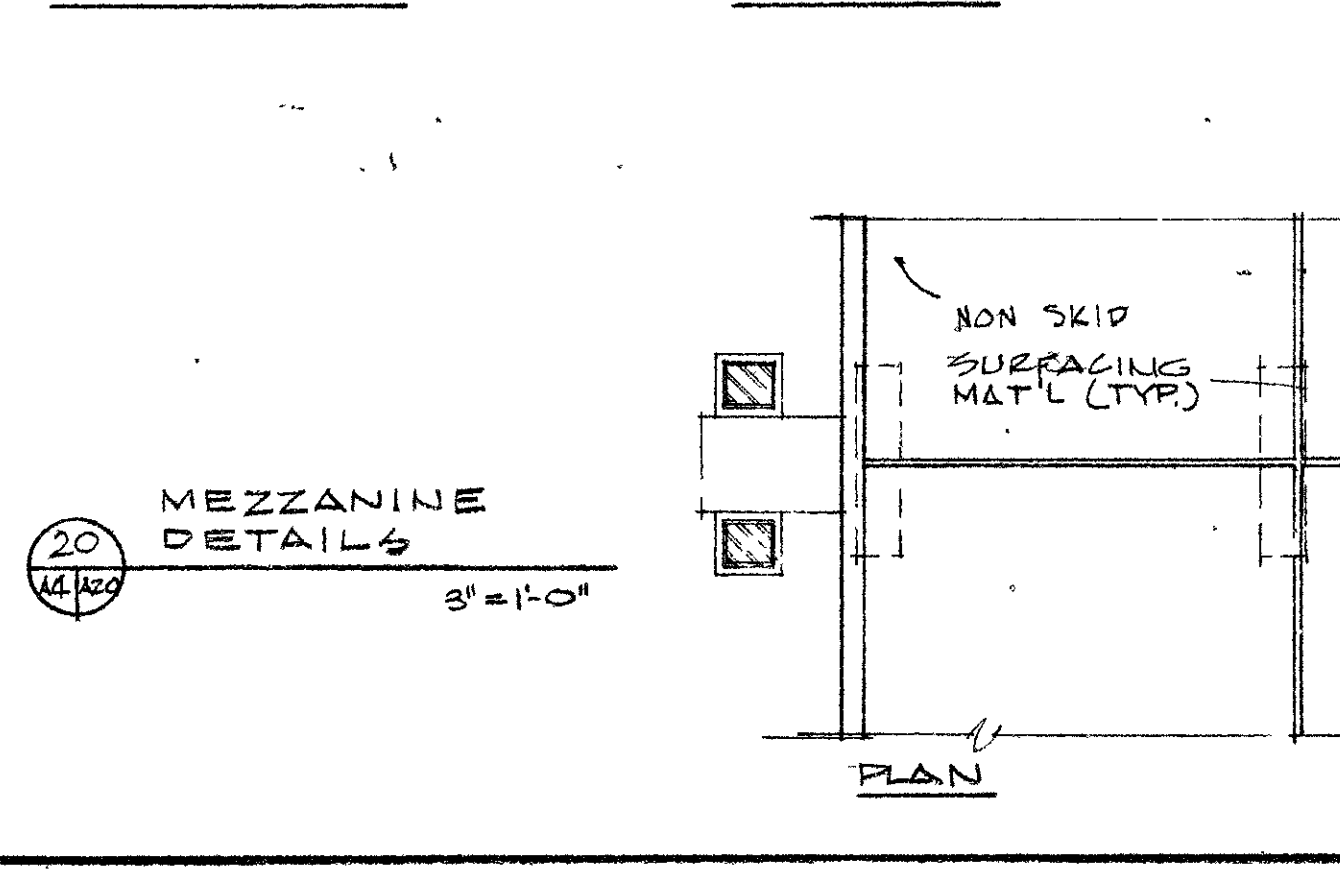
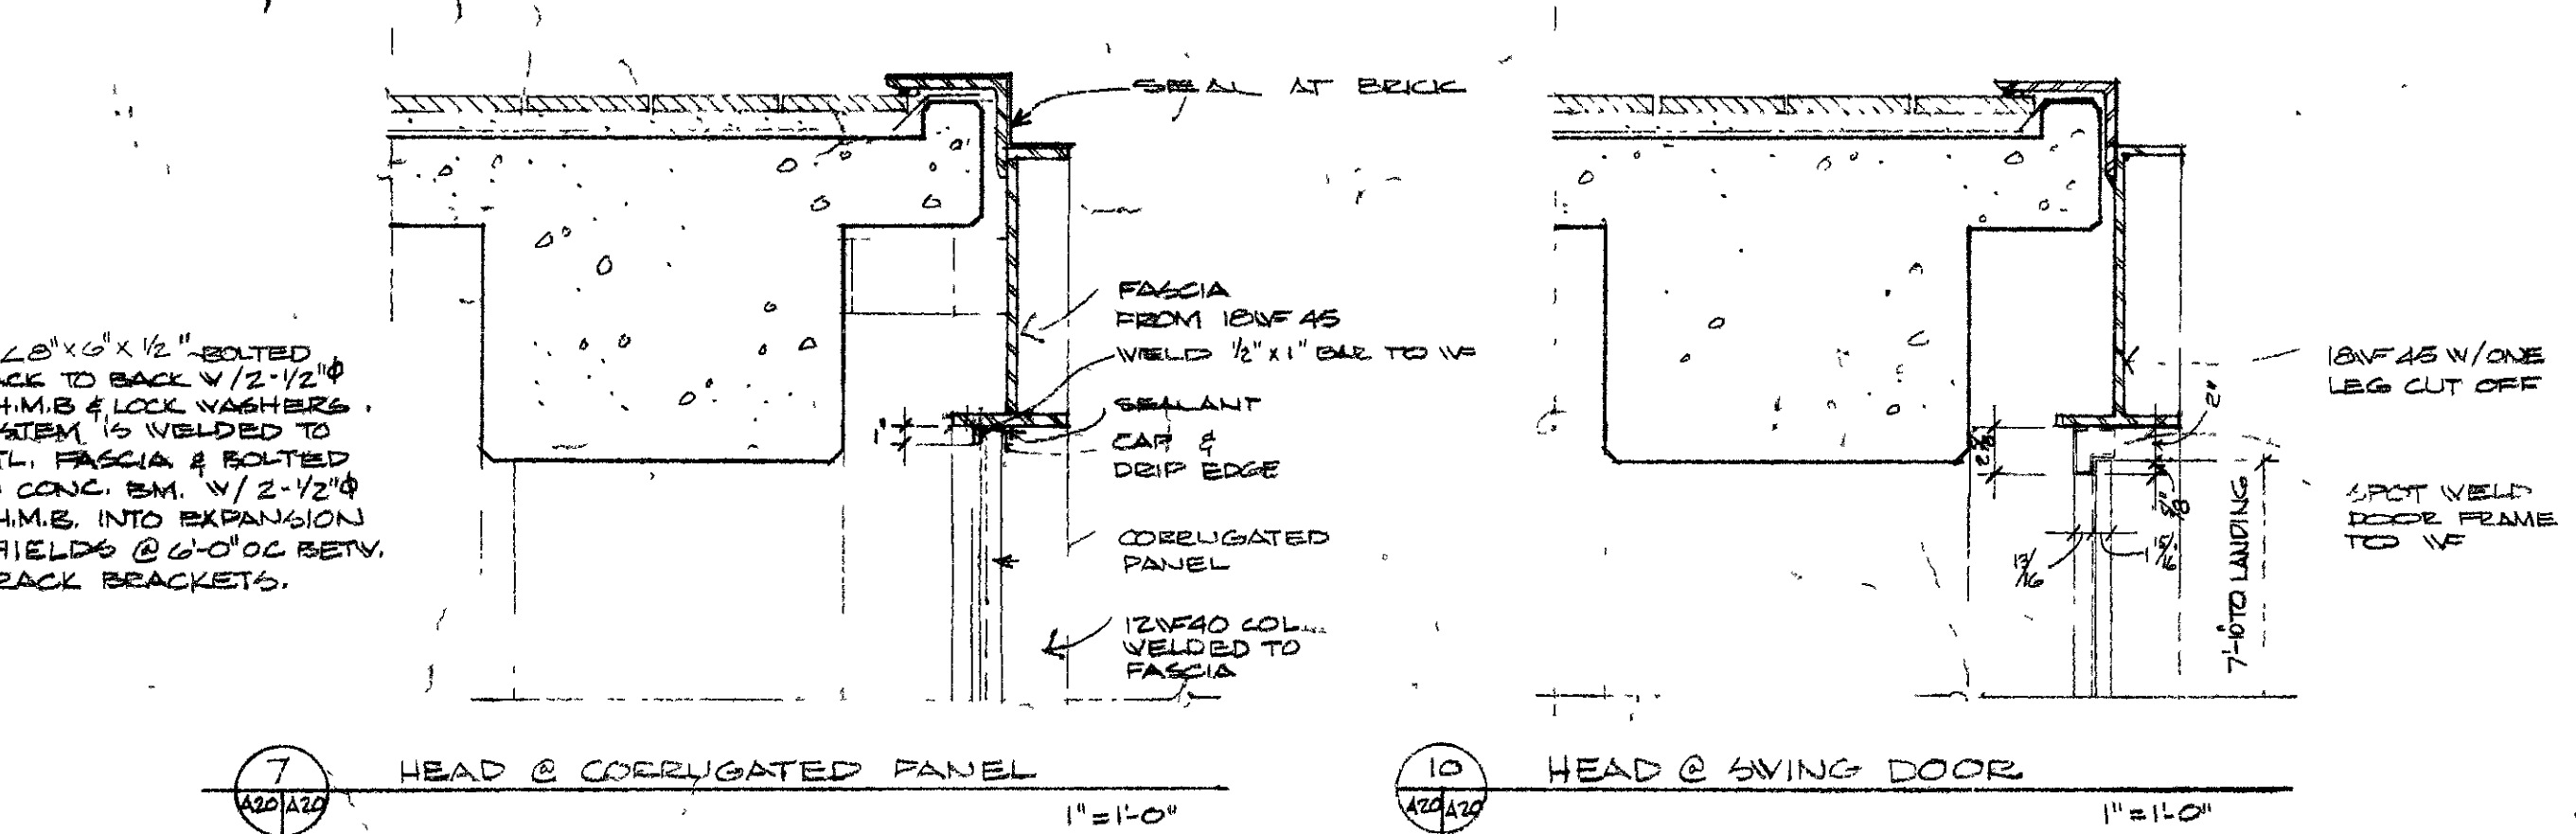
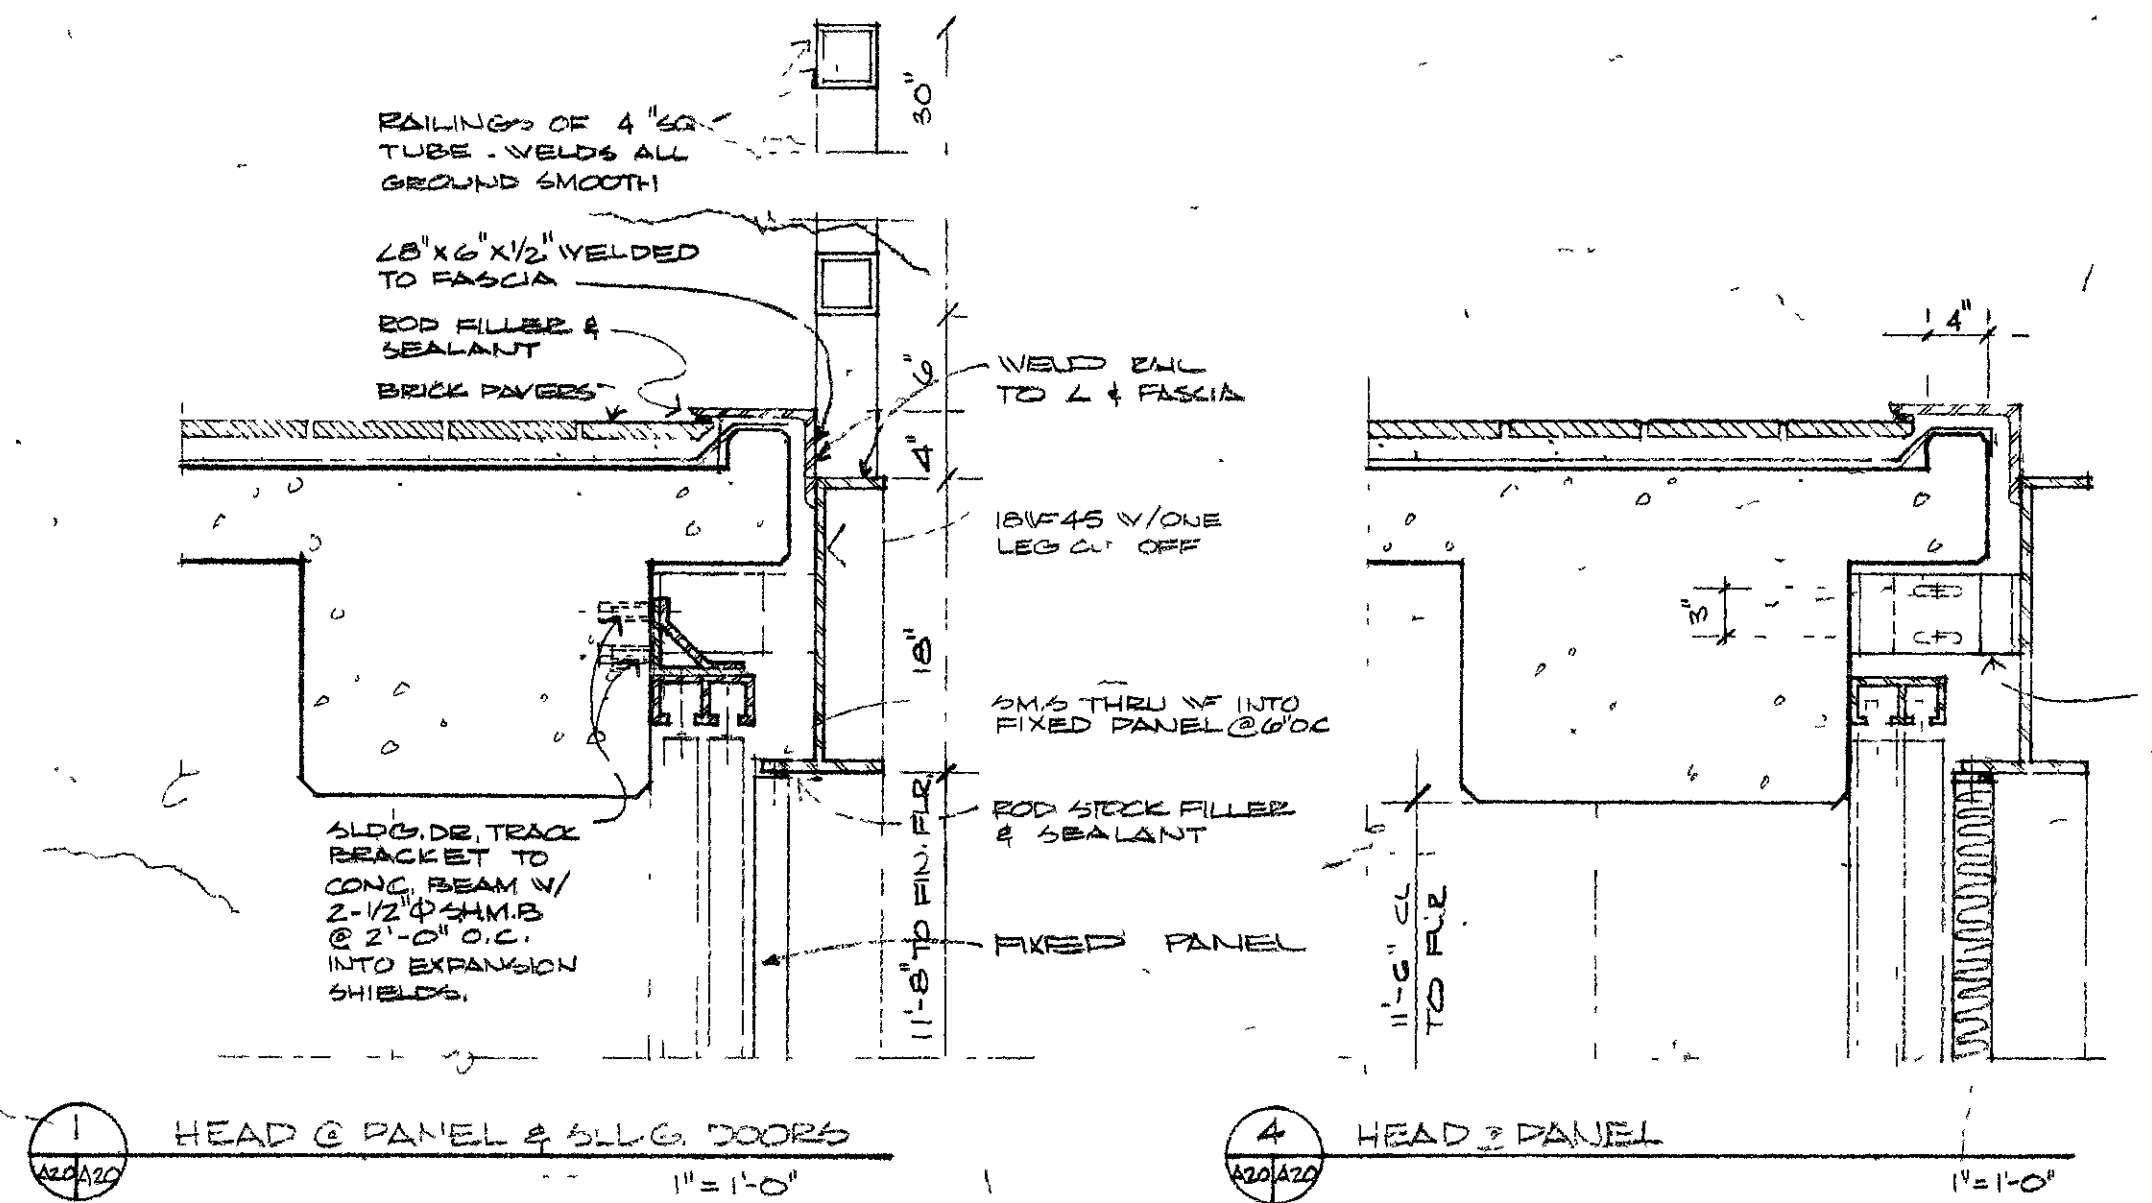
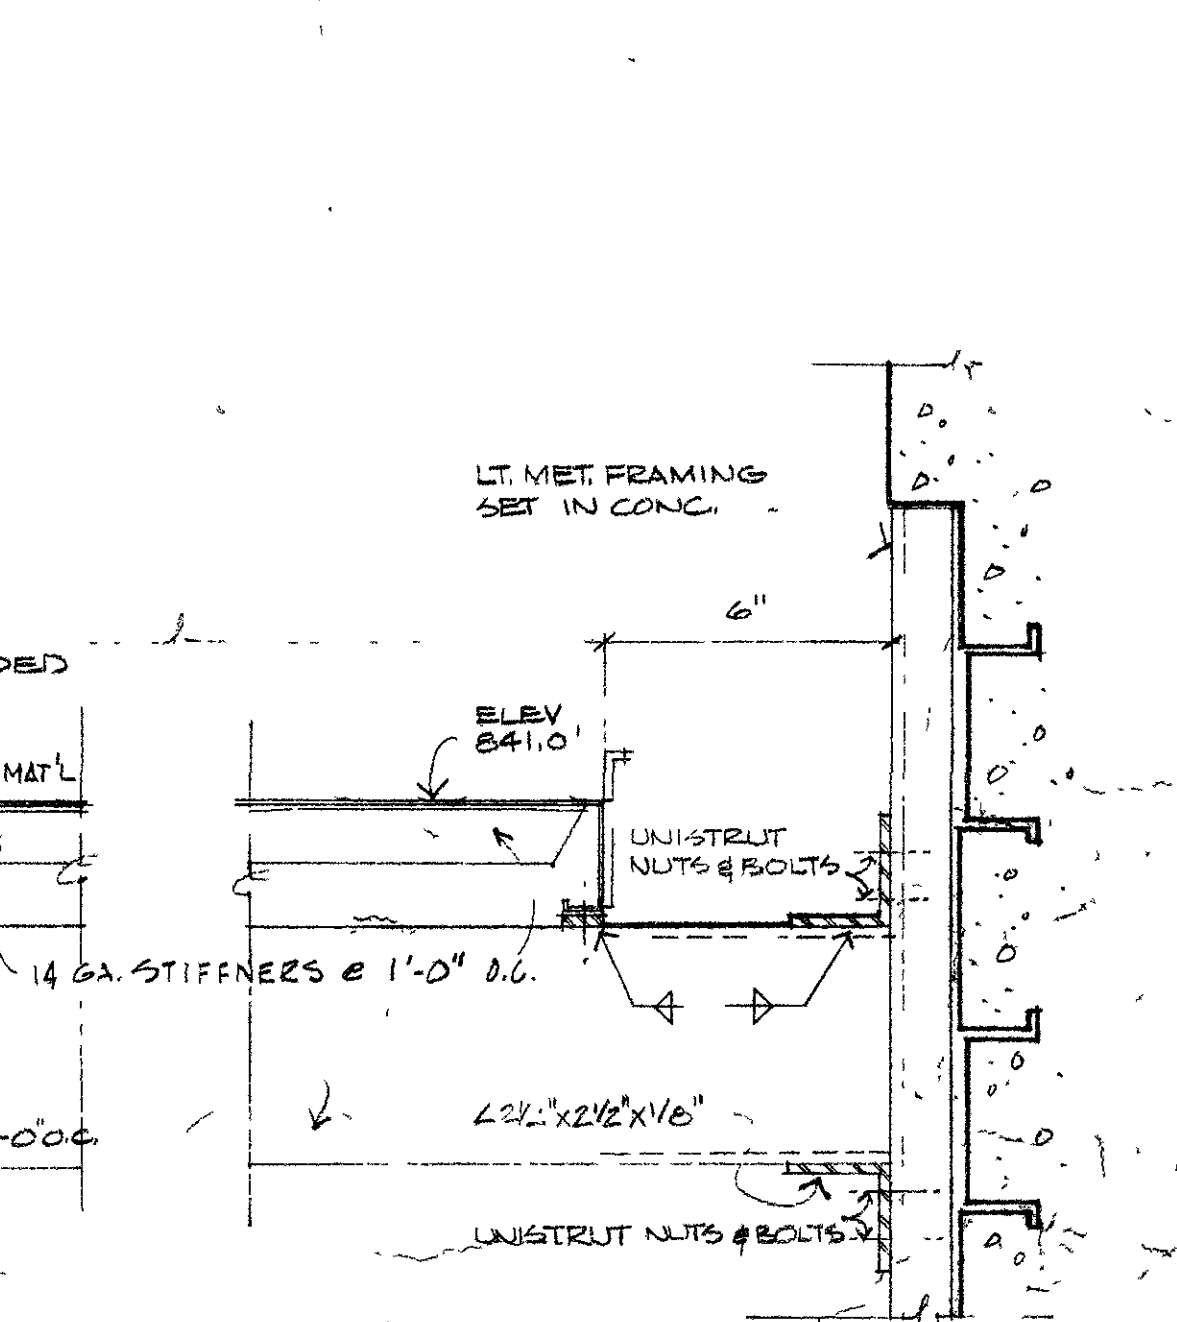
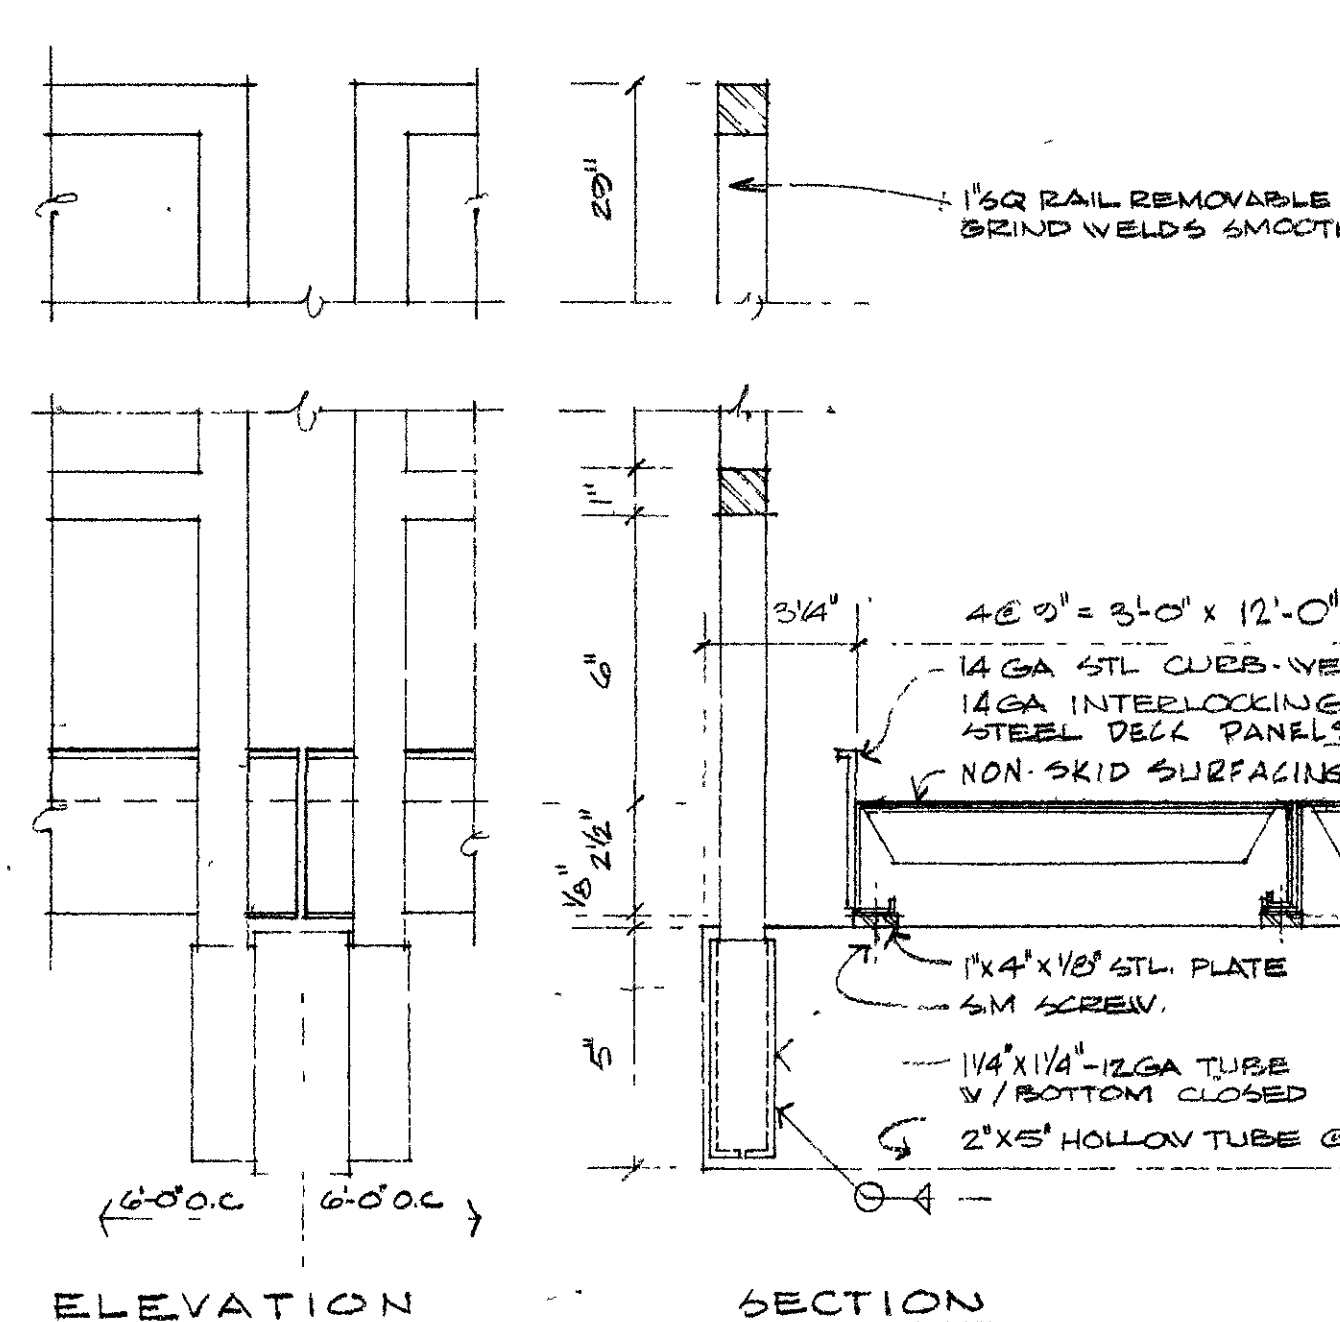
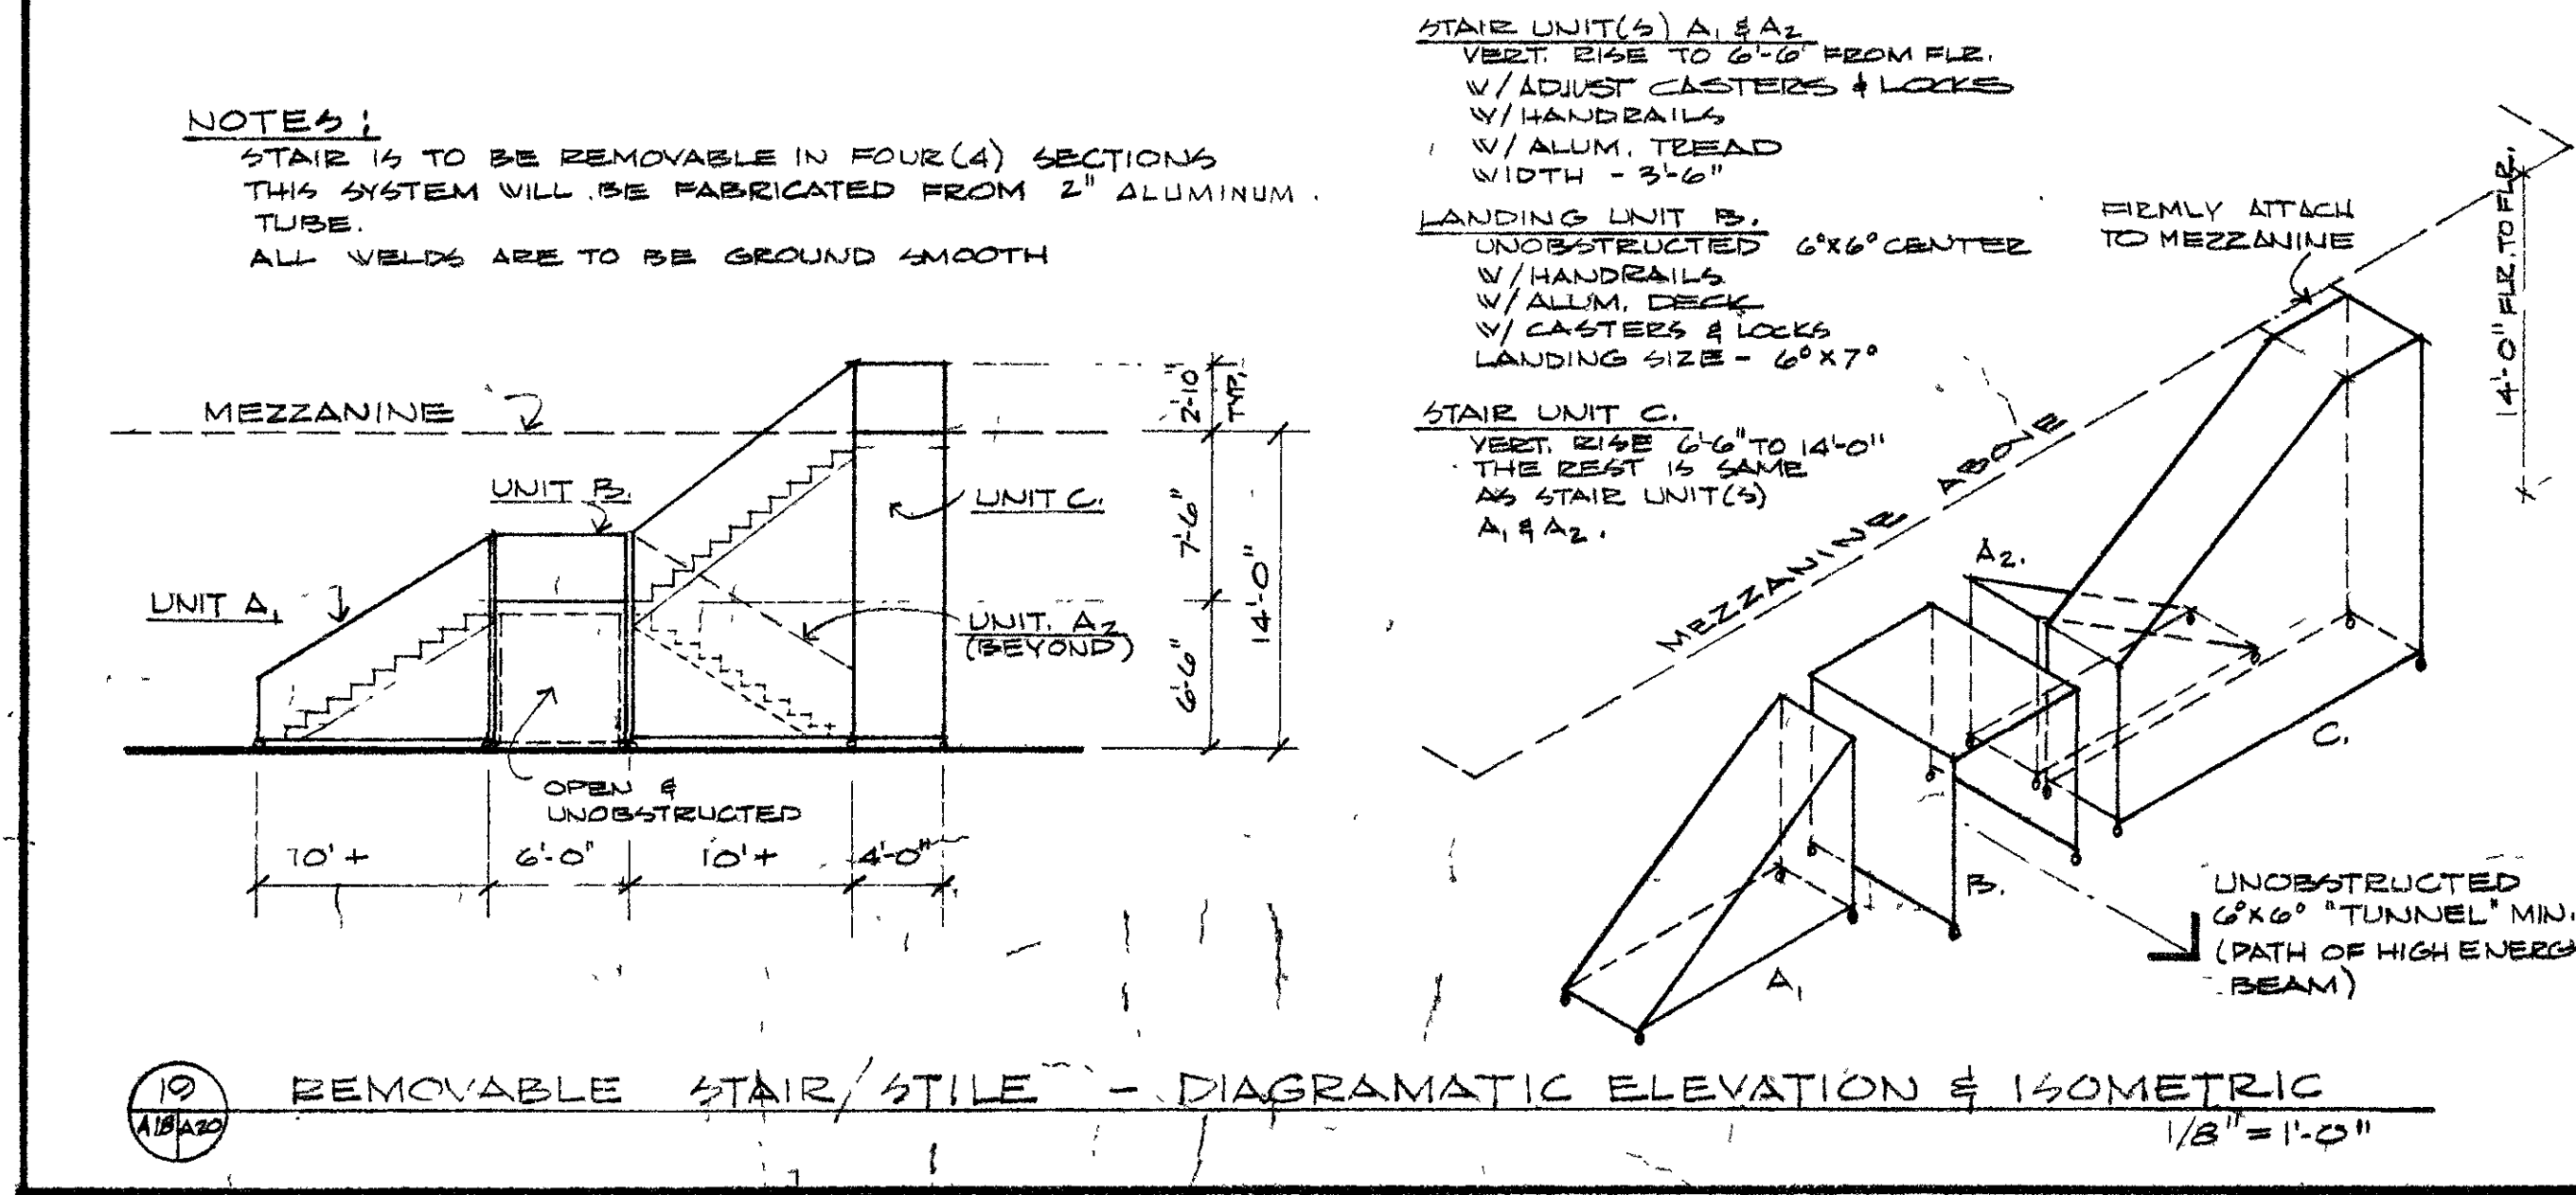
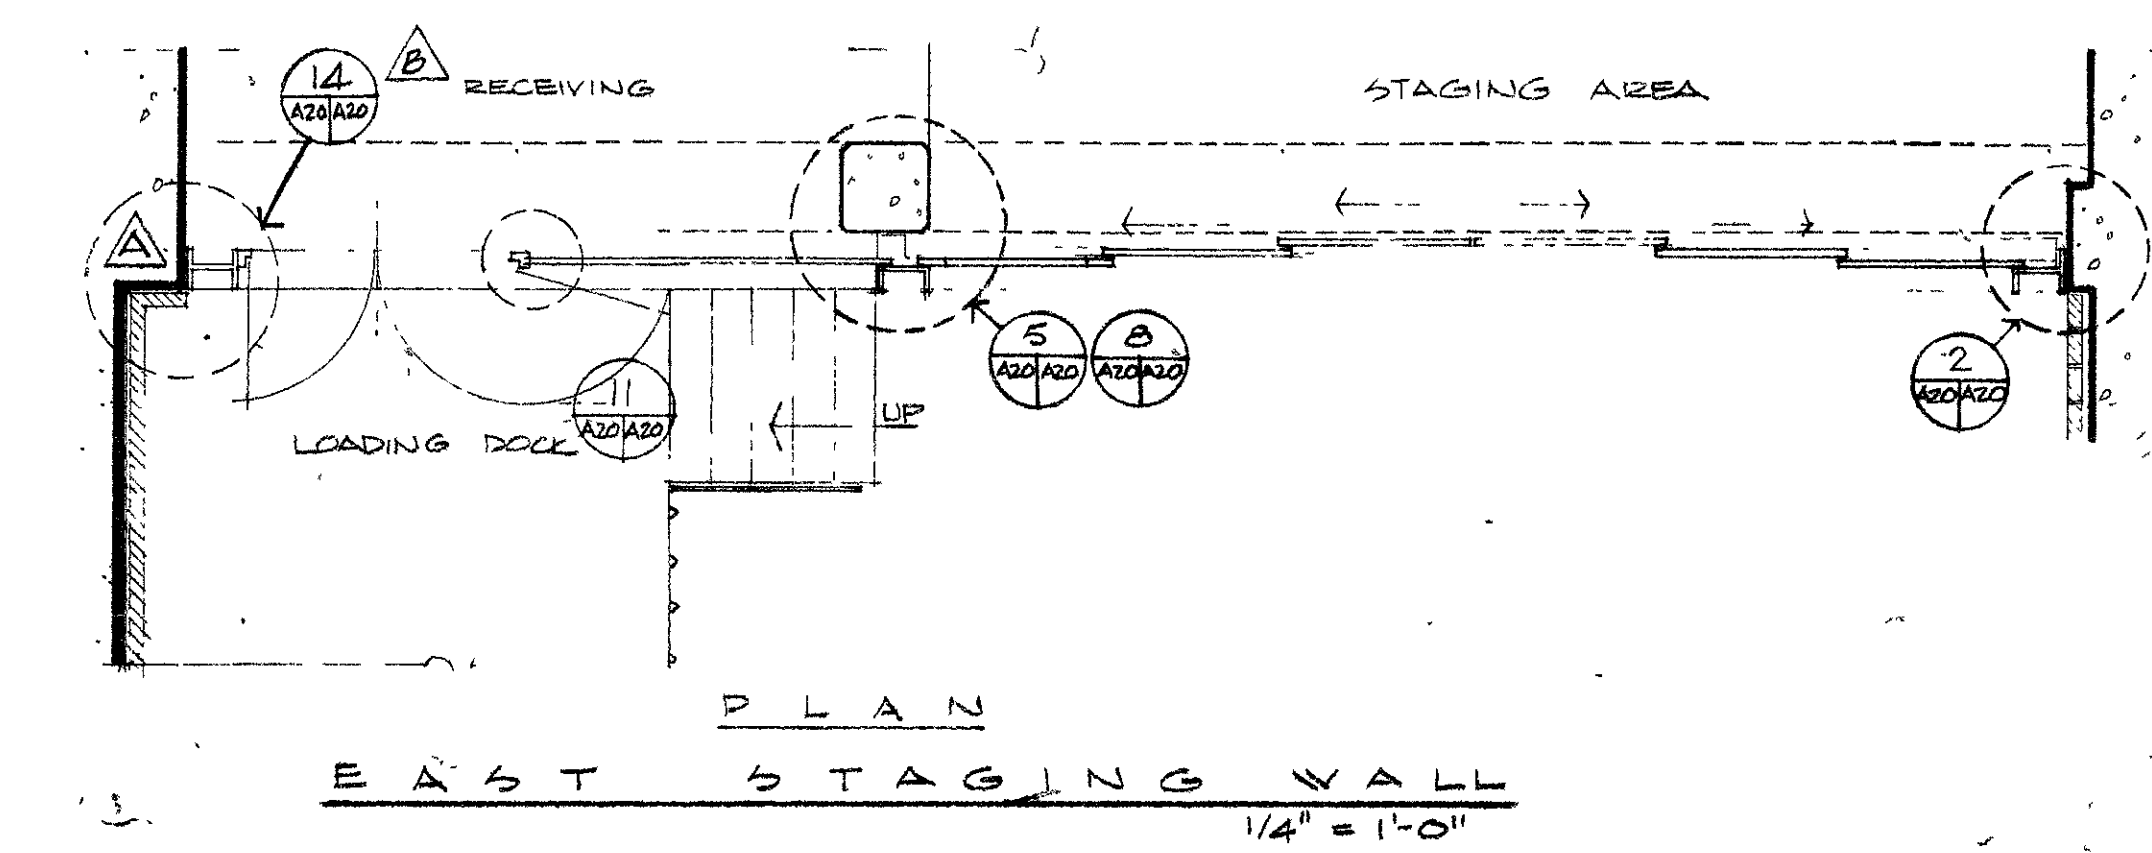
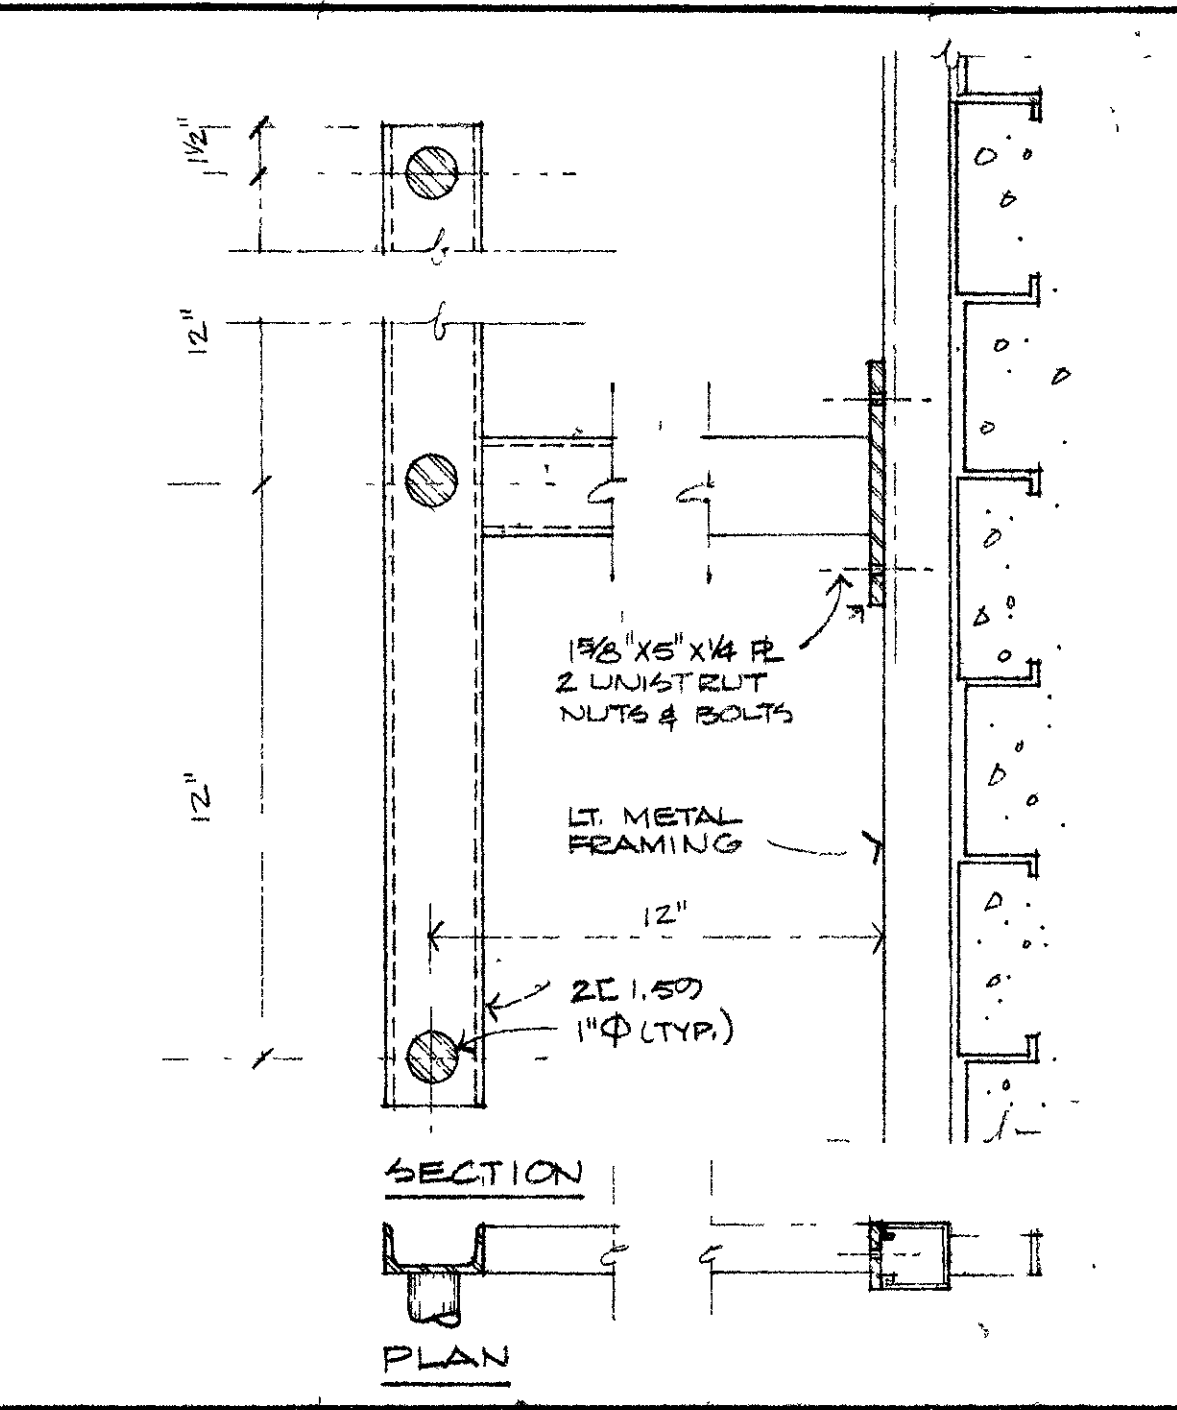
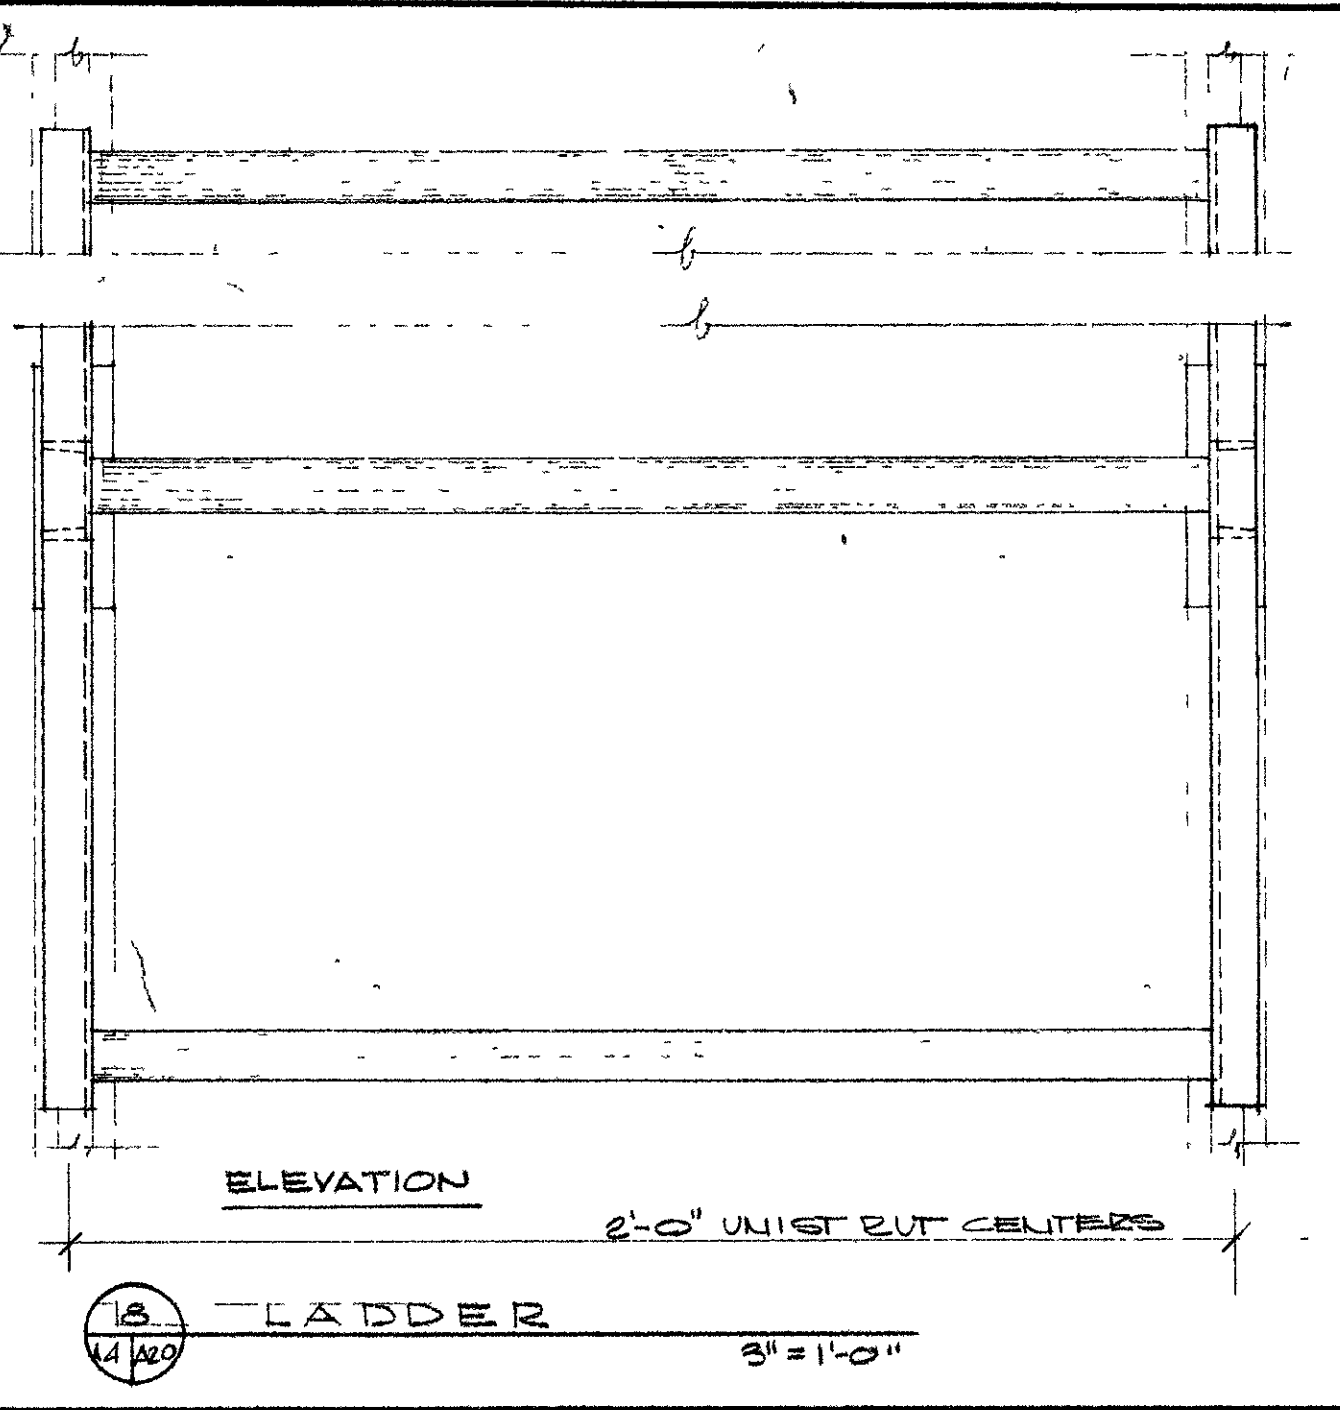
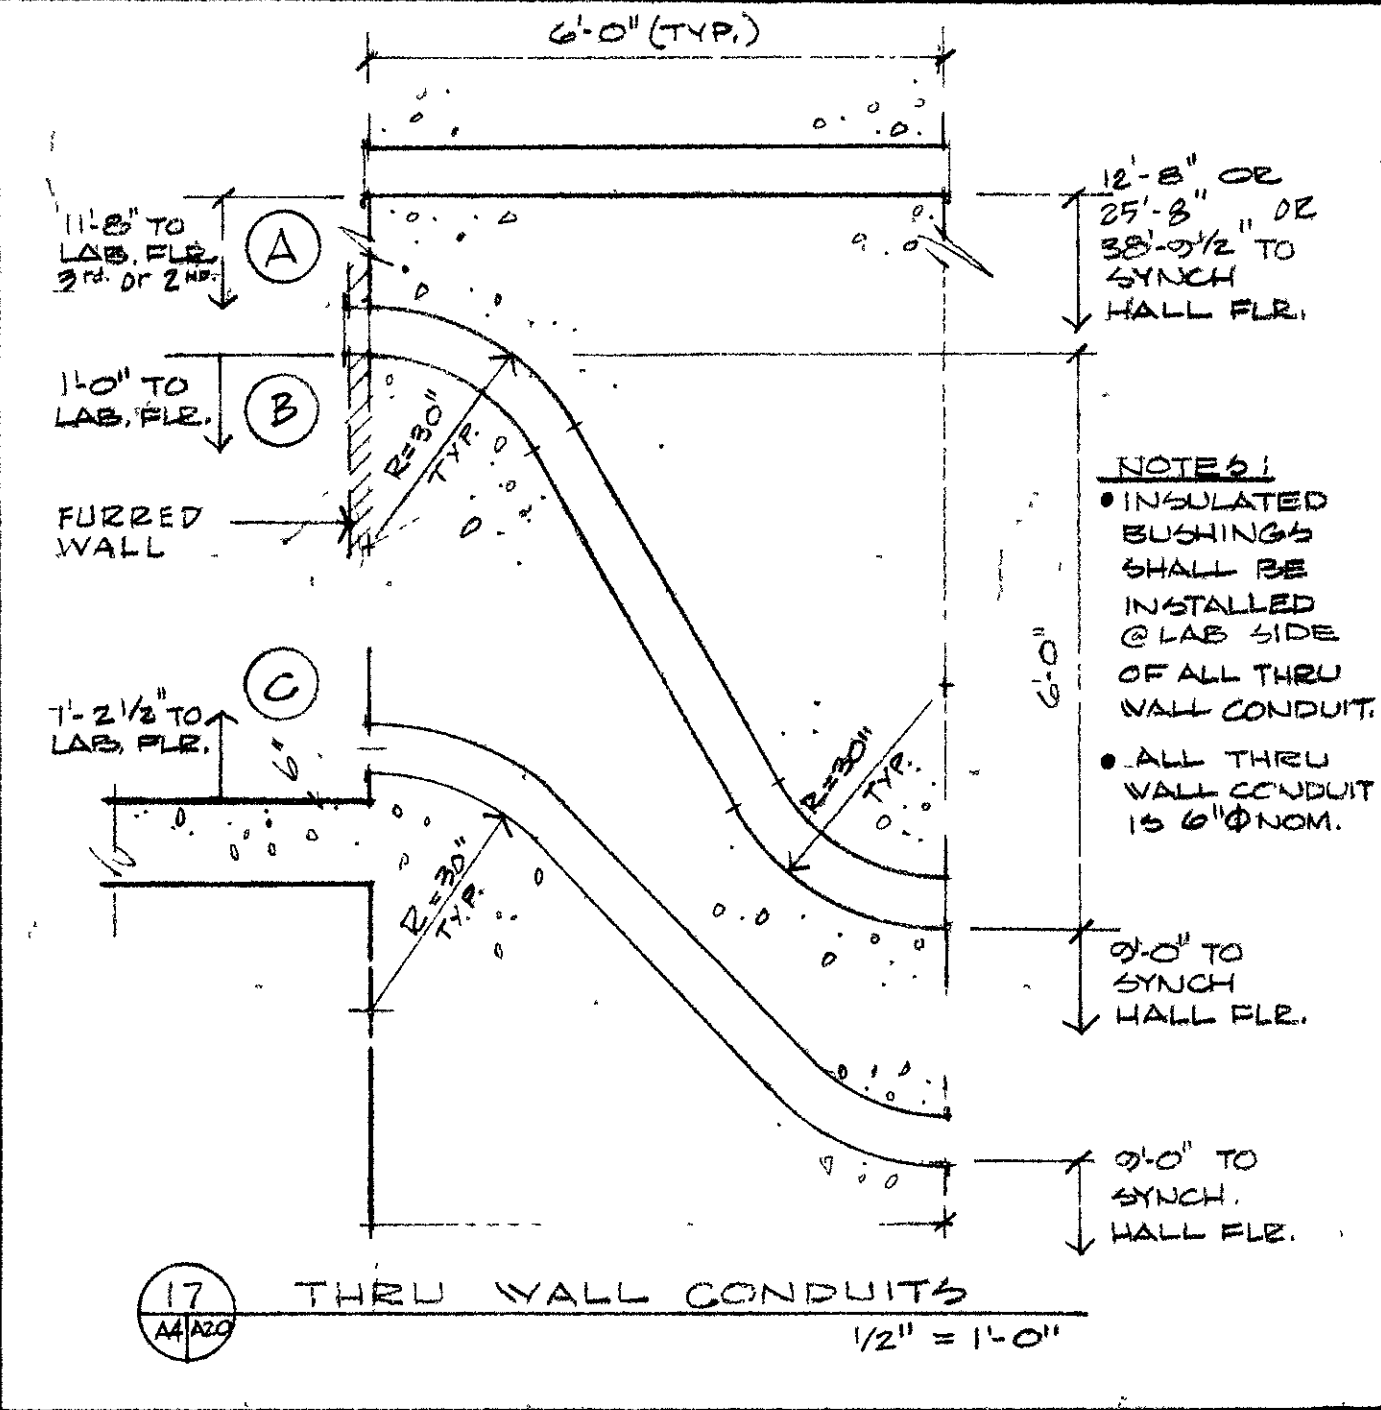
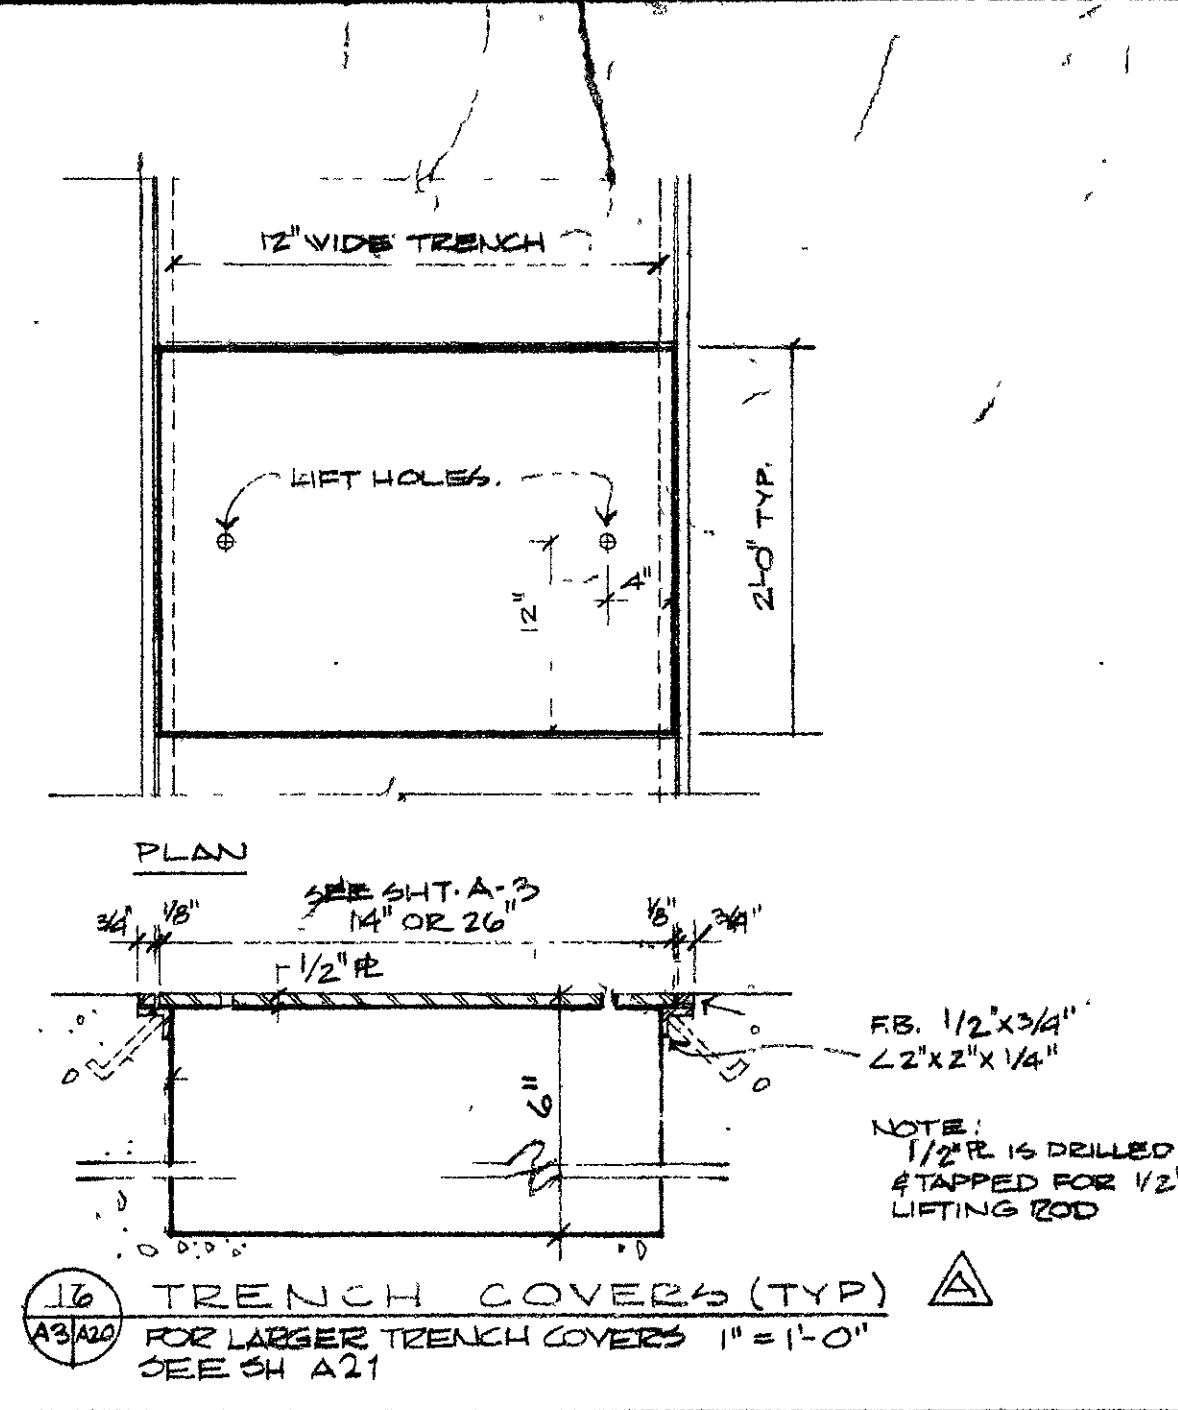
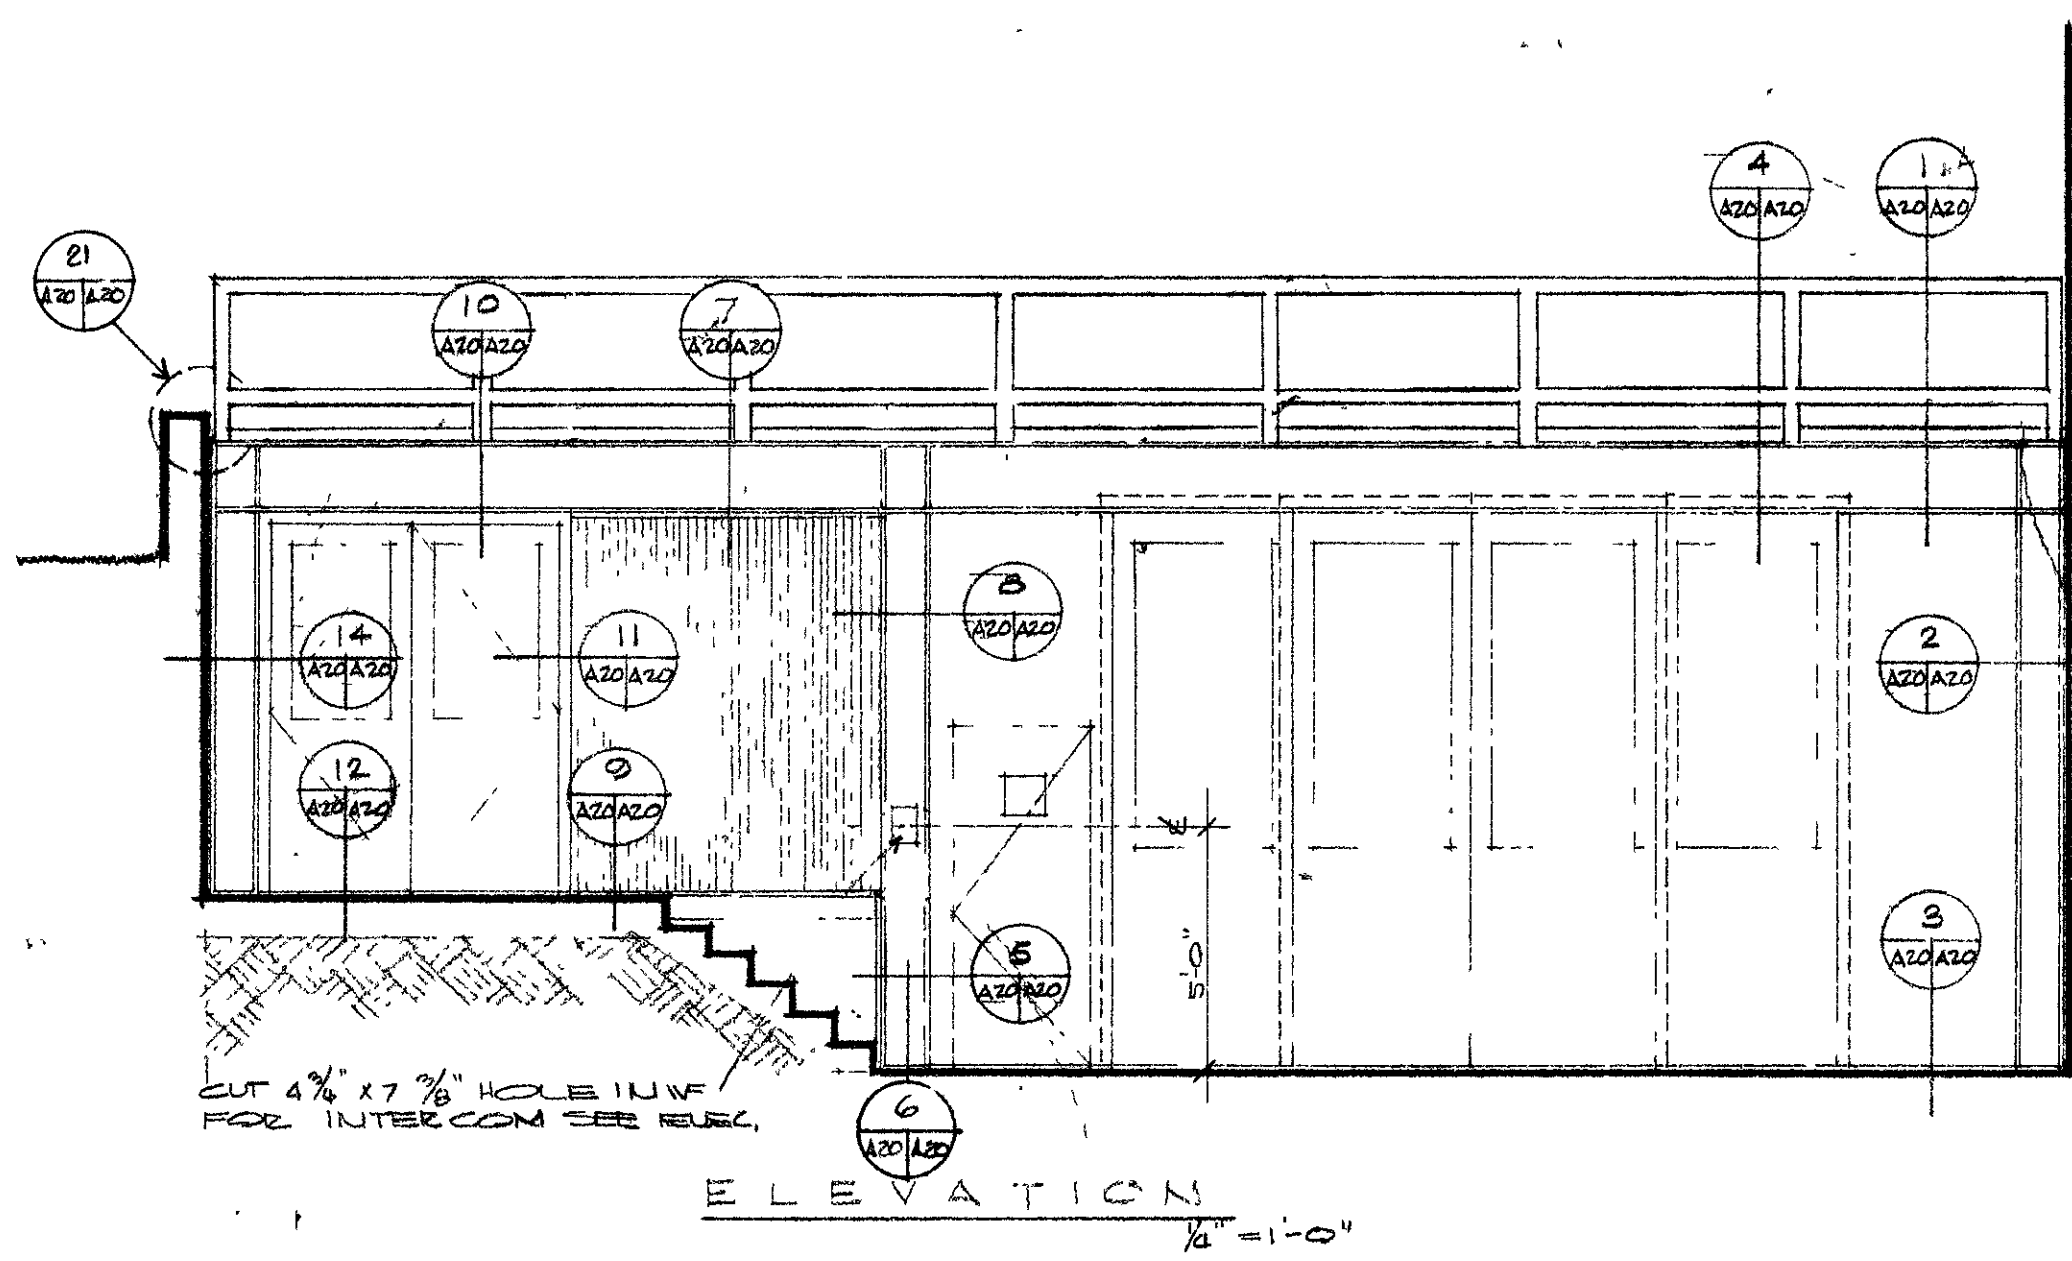


AS BUILT	4-16-68	4-22-68	J. G. T.	1/2"
BUBBLE CORRECTION PLAN	4-16-68	4-22-68	J. G. T.	1/2"
SEE ADDENDUM NO. 1	4-16-68	4-22-68	J. G. T.	1/2"
LTR	REVISIONS	DATE	CHKD	APPD
IO GEV CORNELL SYNCHROTRON LABORATORY CORNELL UNIVERSITY ITHACA, NEW YORK				
MISCELLANEOUS DETAILS				
WILLIAM M. BROBECK AND ASSOCIATES IAN MACKINLAY, AIA PREGNOFF & MATHEU JACOBS ASSOCIATES 950 GILMAN ST. TELEPHONE				
ARCHITECT STRUCTURAL ENGR. CONSTRUCTION ENGR. BERKELEY, CALIF. 94710 415 - 824 - 8664				
DR. BD.	CHK.	SUPV.	SCALE	
RELEASED	APPROVED		AS NOTED	
			SHEET 25 OF 102	
			DRAWING NO. A20	
			WMB & A. NO. 111-S	
2085-33-65-020 044 226 Cornell University B & P 1/8"				