

RM. NO.	ROOM	FLOOR	BASE	WALLS	CEILING	TRIM	REMARKS
		MAT'L.	FIN.	MAT'L.	FIN.	MAT'L.	FIN.
100	AIR LOCK	CONC.	DUST-PROOF	NONE	NONE	CONC. BLK	PAINT
101	CROSSCONNECTS	CONC.	DUST-PROOF	NONE	NONE	CONC.	PAINT
102	STAIR NO. 1	CONC.	DUST-PROOF	NONE	NONE	CONC.	PAINT
110	VEST FLARE	CONC.	DUST-PROOF	NONE	NONE	CONC.	PAINT
118	SYNCH. SUPPORT	CONC.	DUST-PROOF	NONE	NONE	CONC.	PAINT
120	TECH. AREA	CONC.	DUST-PROOF	NONE	NONE	CONC.	PAINT
128	TECH. OFFICE	CONC.	DUST-PROOF	NONE	NONE	CONC.	PAINT
130	MEN'S TOILET	CER. TILE	NONE	CER. TILE	NONE	GYR. BD.	PAINT
130A	LAVATORY	CER. TILE	NONE	CER. TILE	NONE	GYR. BD.	PAINT
132	JANITOR	CER. TILE	NONE	CER. TILE	NONE	GYR. BD.	PAINT
134	ELEV. EQUIP'T	CONC.	DUST-PROOF	NONE	NONE	CONC.	PAINT
135	SHOP AREA	CONC.	DUST-PROOF	NONE	NONE	CONC.	PAINT
136	ELEV. SHAFT	CONC.	DUST-PROOF	NONE	NONE	CONC.	PAINT
138	STAIR NO. 2	CONC.	DUST-PROOF	NONE	NONE	CONC.	PAINT
141	STAGING AREA	CONC.	DUST-PROOF	NONE	NONE	CONC.	PAINT
144	RECEIVING	CONC.	DUST-PROOF	NONE	NONE	CONC.	PAINT
150	SYNCH. HALL	CONC.	DUST-PROOF	NONE	NONE	CONC.	PAINT
152	LIAC HALL	CONC.	DUST-PROOF	NONE	NONE	CONC.	PAINT
153	EAST FLARE	CONC.	DUST-PROOF	NONE	NONE	CONC.	PAINT
154	STORAGE	CONC.	DUST-PROOF	NONE	NONE	CONC.	PAINT
155	DOCK	CONC.	DUST-PROOF	NONE	NONE	CONC.	PAINT


200	LOBBY	VIN. ASS. TILE	NONE	WOOD	STAIN	GYR. BD.	PAINT
200A	VESTIBULE	VIN. ASS. TILE	NONE	WOOD	STAIN	GYR. BD.	PAINT
201	CONTROL RM.	VIN. ASS. TILE	NONE	WOOD	STAIN	GYR. BD.	PAINT
202	MEN'S TOILET	CER. TILE	NONE	CER. TILE	NONE	GYR. BD.	PAINT
202A	JANITOR	CER. TILE	NONE	CER. TILE	NONE	GYR. BD.	PAINT
203	CORRIDOR	VIN. ASS. TILE	NONE	WOOD	STAIN	GYR. BD.	PAINT
204	LOCKERS	CER. TILE	NONE	CER. TILE	NONE	GYR. BD.	PAINT
204A	SHOWER	CER. TILE	NONE	CER. TILE	NONE	GYR. BD.	PAINT
206	CREW ROOM	VIN. ASS. TILE	NONE	WOOD	STAIN	GYR. BD.	PAINT
207	COUNTING RM.	VIN. ASS. TILE	NONE	WOOD	STAIN	GYR. BD.	PAINT
208	DARK ROOM	VIN. ASS. TILE	NONE	RUBBER	NONE	GYR. BD.	PAINT
210	COMPUTER RM.	VIN. ASS. TILE	NONE	WOOD	STAIN	GYR. BD.	PAINT
214	OFFICE	VIN. ASS. TILE	NONE	WOOD	STAIN	GYR. BD.	PAINT
215	LABORATORY	VIN. ASS. TILE	NONE	WOOD	STAIN	GYR. BD.	PAINT
216	OFFICE	VIN. ASS. TILE	NONE	WOOD	STAIN	GYR. BD.	PAINT
220	ELECTRONIC SHOP	VIN. ASS. TILE	NONE	WOOD	STAIN	GYR. BD.	PAINT
221	STU. FACULTY SHOP	VIN. ASS. TILE	NONE	WOOD	STAIN	GYR. BD.	PAINT
222	LABORATORY	VIN. ASS. TILE	NONE	WOOD	STAIN	GYR. BD.	PAINT
230	LABORATORY	VIN. ASS. TILE	NONE	WOOD	STAIN	GYR. BD.	PAINT
231	STOCK ROOM	VIN. ASS. TILE	NONE	WOOD	STAIN	GYR. BD.	PAINT
233	SOLVENT STD.	CONC.	DUST-PROOF	NONE	NONE	CONC.	PAINT
234	VESTIBULE	VIN. ASS. TILE	NONE	WOOD	STAIN	GYR. BD.	PAINT
235	POWER SUPPLY	CONC.	DUST-PROOF	NONE	NONE	CONC.	PAINT

300	LOBBY	VIN. ASS. TILE	NONE	WOOD	STAIN	GYR. BD.	PAINT
300A	VESTIBULE	VIN. ASS. TILE	NONE	WOOD	STAIN	GYR. BD.	PAINT
301	CONFERENCE	VIN. ASS. TILE	NONE	WOOD	STAIN	GYR. BD.	PAINT
303	CORRIDOR	VIN. ASS. TILE	NONE	WOOD	STAIN	GYR. BD.	PAINT
304	ASSOC. DIRECTOR	VIN. ASS. TILE	NONE	WOOD	STAIN	GYR. BD.	PAINT
305	SECRETARIES	VIN. ASS. TILE	NONE	WOOD	STAIN	GYR. BD.	PAINT
305A	STORAGE	VIN. ASS. TILE	NONE	WOOD	STAIN	GYR. BD.	PAINT
307	ADMIN. ASS'T	VIN. ASS. TILE	NONE	WOOD	STAIN	GYR. BD.	PAINT
308	COMMONS	VIN. ASS. TILE	NONE	WOOD	STAIN	GYR. BD.	PAINT
309	LABORATORY	VIN. ASS. TILE	NONE	WOOD	STAIN	GYR. BD.	PAINT
310	GALLERY	VIN. ASS. TILE	NONE	RUBBER	NONE	GYR. BD.	PAINT
310A	STORAGE	VIN. ASS. TILE	NONE	WOOD	STAIN	GYR. BD.	PAINT
312	OFFICE	VIN. ASS. TILE	NONE	WOOD	STAIN	GYR. BD.	PAINT
313	LABORATORY	VIN. ASS. TILE	NONE	WOOD	STAIN	GYR. BD.	PAINT
314	OFFICE	VIN. ASS. TILE	NONE	WOOD	STAIN	GYR. BD.	PAINT
315	LABORATORY	VIN. ASS. TILE	NONE	WOOD	STAIN	GYR. BD.	PAINT
316	OFFICE	VIN. ASS. TILE	NONE	WOOD	STAIN	GYR. BD.	PAINT
317	LABORATORY	VIN. ASS. TILE	NONE	WOOD	STAIN	GYR. BD.	PAINT
318	OFFICE	VIN. ASS. TILE	NONE	WOOD	STAIN	GYR. BD.	PAINT
320	OFFICE	VIN. ASS. TILE	NONE	WOOD	STAIN	GYR. BD.	PAINT
321	LABORATORY	VIN. ASS. TILE	NONE	WOOD	STAIN	GYR. BD.	PAINT
322	OFFICE	VIN. ASS. TILE	NONE	WOOD	STAIN	GYR. BD.	PAINT
326	LABORATORY	VIN. ASS. TILE	NONE	WOOD	STAIN	GYR. BD.	PAINT
330	WOMEN'S TOILET	CER. TILE	NONE	CER. TILE	NONE	GYR. BD.	PAINT
332	LOUNGE	VIN. ASS. TILE	NONE	WOOD	STAIN	GYR. BD.	PAINT
334	JANITOR	CER. TILE	NONE	CER. TILE	NONE	GYR. BD.	PAINT
335	LABORATORY	VIN. ASS. TILE	NONE	WOOD	STAIN	GYR. BD.	PAINT
336	ELEC. EQUIP'T	CONC.	DUST-PROOF	NONE	NONE	CONC.	PAINT
337	VESTIBULE	CONC.	DUST-PROOF	NONE	NONE	CONC.	PAINT

400	LOBBY	CONC.	DUST-PROOF	NONE	NONE	VARIES	PAINT
401	STORAGE	CONC.	DUST-PROOF	NONE	NONE	CONC.	PAINT
402	PUMP GALLERY	CONC.	DUST-PROOF	NONE	NONE	CONC.	PAINT

RM. NO.	ROOM	FLOOR	BASE	WALLS	CEILING	TRIM	REMARKS
		MAT'L.	FIN.	MAT'L.	FIN.	MAT'L.	FIN.
500	LOBBY	BRICK	NONE	NONE	CONC.	PAINT	NONE
501	STORAGE	CONC.	DUST-PROOF	NONE	NONE	CONC.	PAINT
552	VESTIBULE	CONC.	DUST-PROOF	NONE	NONE	CONC.	PAINT
554	FAN ROOMS	CONC.	DUST-PROOF	NONE	NONE	CONC.	PAINT
600	ELEV. PENTHOUSE	CONC.	DUST-PROOF	NONE	NONE	CONC.	PAINT
652	MECH. ROOM II	CONC.	DUST-PROOF	NONE	NONE	CONC.	PAINT
654	COOLG. TOWER RM.	CONC.	DUST-PROOF	NONE	NONE	CONC.	PAINT
700	TOWERED ACCESS	CONC.	DUST-PROOF	NONE	NONE	CONC.	PAINT

NO.	TYPE	ORF. SIZE	MATERIAL	FIN.	HDW.	REMARKS	DATING
101				PAINT		ROLL-UP - SEE SPECS	
102				PAINT		STEEL SLIDG. FUSELAGE CASE	
103	B	3-0 x 7-0	S.C. MTL.	PAINT	1	INTERCOM DOOR OF R-SEE ELEC.	
104	J	6-0 x 7-0	S.C. MTL.	PAINT	2		
105	B	3-0 x 7-0	COMP. VD.	STAIN	3		
106	G	3-0 x 7-0	S.C. WOOD	STAIN	4		
107	A	3-0 x 7-0	COMP. VD.	STAIN	4A		
108	G	3-0 x 7-0	S.C. WOOD	STAIN	5		
109	E	3-0 x 7-0	S.C. WOOD	STAIN	6		
110	B	3-0 x 7-0	S.C. WOOD	STAIN	6		
111	C	3-0 x 7-0	S.C. WOOD	STAIN	7A		
112	A	3-0 x 7-0	S.C. MTL.	PAINT	8	ELEC. INTERLOCK	
113	A	3-8 x 7-0	S.C. MTL.	PAINT	9	ELEC. INTERLOCK	
114	B	3-0 x 7-0	COMP. VD.	STAIN	9		
115	C	6-0 x 7-0	S.C. WOOD	STAIN	10	WEATHERSTRIP	
116	C	6-0 x 7-0	S.C. WOOD	STAIN	10	RELIEF VENT - SEE BEL.	
201						WATER SWING BRONZE - SEE DET.	
202	A	3-0 x 7-0	MTL.	PAINT	4	ALUM. INTERLOCK THRESHOLD	
203	B	3-0 x 7-0	COMP. VD.	STAIN	5		
203A	B	3-0 x 7-0	COMP. VD.	STAIN	5		
204	H	5-6 x 7-0	S.C. WOOD	STAIN	13		
205	B	3-0 x 7-0	S.C. WOOD	STAIN	6		
206	B	3-0 x 7-0	S.C. WOOD	STAIN	6		
207	D	6-0 x 7-0	S.C. WOOD	STAIN	7		
208	B	3-0 x 7-0	S.C. WOOD	STAIN	6		
209	B	3-0 x 7-0	S.C. WOOD	STAIN	6		
210	C	5-0 x 7-0	S.C. WOOD	STAIN	7		
211	B	3-0 x 7-0	S.C. WOOD	STAIN	6		
212	B	3-0 x 7-0	S.C. WOOD	STAIN	6		
213	C	6-0 x 7-0	S.C. WOOD	STAIN	7		
214	C	6-0 x 7-0	S.C. WOOD	STAIN	7		
215	B	3-0 x 7-0	S.C. WOOD	STAIN	6		
216	A	2-6 x 7-0	S.C. MTL.	PAINT	8	ELEC. INTERLOCK	
217	B	3-0 x 7-0	S.C. WOOD	STAIN	6		
218	C	6-0 x 7-0	S.C. WOOD	STAIN	7		
219	B	3-0 x 7-0	S.C. WOOD	STAIN	6		
220	B	3-0 x 7-0	S.C. WOOD	STAIN	6		
221	B	3-0 x 7-0	S.C. WOOD	STAIN	6		
222	B	3-0 x 7-0	S.C. WOOD	STAIN	6		
223	A	3-0 x 7-0	S.C. WOOD	STAIN	6	WEATHERSTRIP	
224	A	3-0 x 7-0	S.C. WOOD	STAIN	12	WEATHERSTRIP	
225	B	3-0 x 7-0	S.C. WOOD	STAIN	6		
226	B	3-0 x 7-0	S.C. WOOD	STAIN	6		
227	A	3-0 x 7-0	S.C. WOOD	STAIN	5		
228						TEMP. GLASS ALUM. FRAME - SEE SPECS	
229	G	3-0 x 7-0	S.C. WOOD	STAIN	5		
230	G	3-0 x 7-0	S.C. WOOD	STAIN	4		
231	E	3-0 x 7-0	S.C. WOOD	STAIN	6		
232	B	3-0 x 7-0	COMP. WOOD	STAIN	3		
233	B	3-0 x 7-0	S.C. MTL.	PAINT	3	WEATHERSTRIP	
234	A	3-0 x 7-0	S.C. MTL.	PAINT	11	WEATHERSTRIP	
235	A	3-8 x 7-0	S.C. MTL.	PAINT	9	ELEC. INTERLOCK	
301	B	3-0 x 7-0	COMP. VD.	STAIN	3		
302	C	5-0 x 7-0	S.C. WOOD	STAIN	7		
303	G	3-0 x 7-0	S.C. WOOD	STAIN	4		
304	G	3-0 x 7-0	S.C. WOOD	STAIN	5		
305	C	5-0 x 7-0	S.C. WOOD	STAIN	7		
306	C	5-0 x 7-0	S.C. WOOD	STAIN	7		
307	B	3-0 x 7-0	S.C. WOOD	STAIN	6		
308	B	3-0 x 7-0	S.C. WOOD	STAIN	6		
601	A	3-0 x 7-0	COMP. WOOD	STAIN	3		
602	B	3-0 x 7-0	S.C. WOOD	STAIN	3		
701	G	3-0 x 7-0	S.C. METAL	PAINT	BA	16" x 14" LOUVER (1/2" HR. RATING) FUSIBLE LINK 135°	
702						EXISTING	

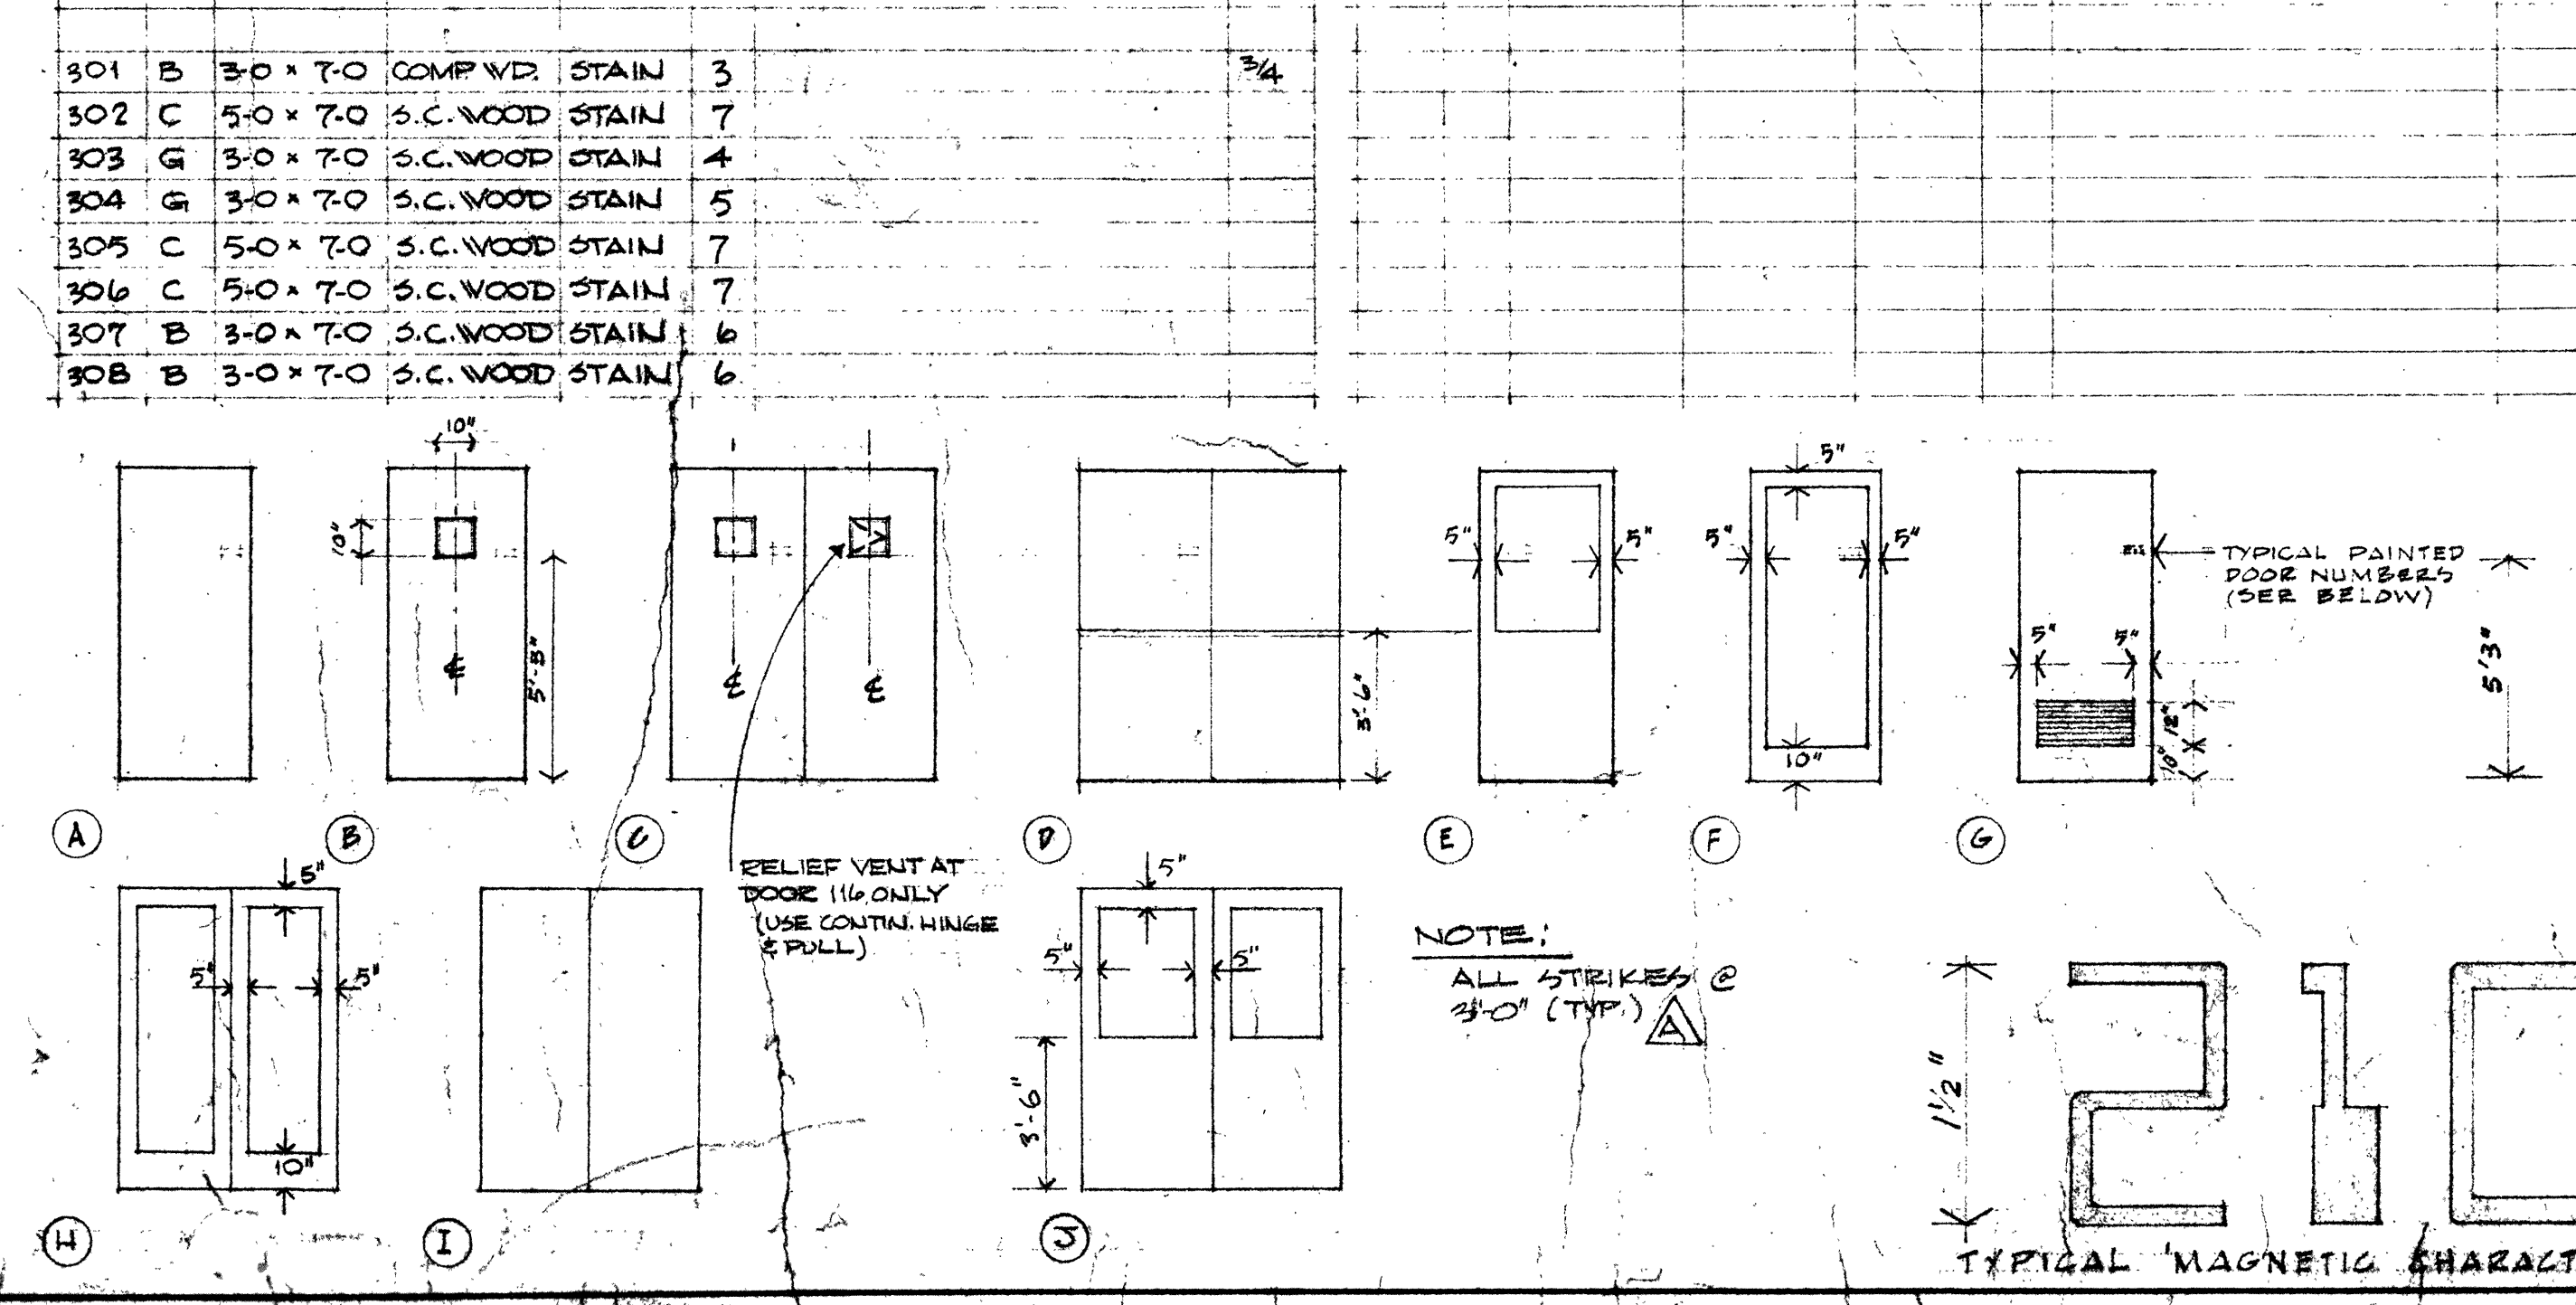

AS BUILT
4-16-69
4-22-69

1. MATERIAL CHANGE RM 155
2. DELETE OPS. WIDE MAT. FIN. W/STAIN
3. WEATHERSTRIP RM 115
4. WALL MATERIAL RM 102
5. MATERIAL THRESHOLD 135°
6. OPENING SIZE, SEE 11, 225
SEE ADDENDUM NO. 1

LTR
REVISIONS
DATE
BY
CHKD
APP'D

IO GEV CORNELL
SYNCHROTRON LABORATORY
CORNELL
ITHACA

CORNELL
UNIVERSITY
NEW YORK

FINISH SCHEDULES

WILLIAM M. BROBECK AND ASSOCIATES
IAN MACKINLAY, AIA
PREGNOFF & MATHEU
JACOBS ASSOCIATES
950 GILMAN ST.
TELEPHONE

ARCHITECT
STRUCTURAL ENGR.
CONSTRUCTION ENGR.
BERKELEY, CALIF. 94710
415 - 824 - 8644

DR. ENR
CHK
SUPV.
SCALE
N/A

RELEASED
APPROVED
LAB NUCLEAR STUDIES
SHEET
28
OF
102

DATE
11/1/68
DATE
JAN 15/1966
Y.P. BUSINESS
WMB & NO. 111-5

2085-33-65-023
044
229 Cornell University B. & P.