
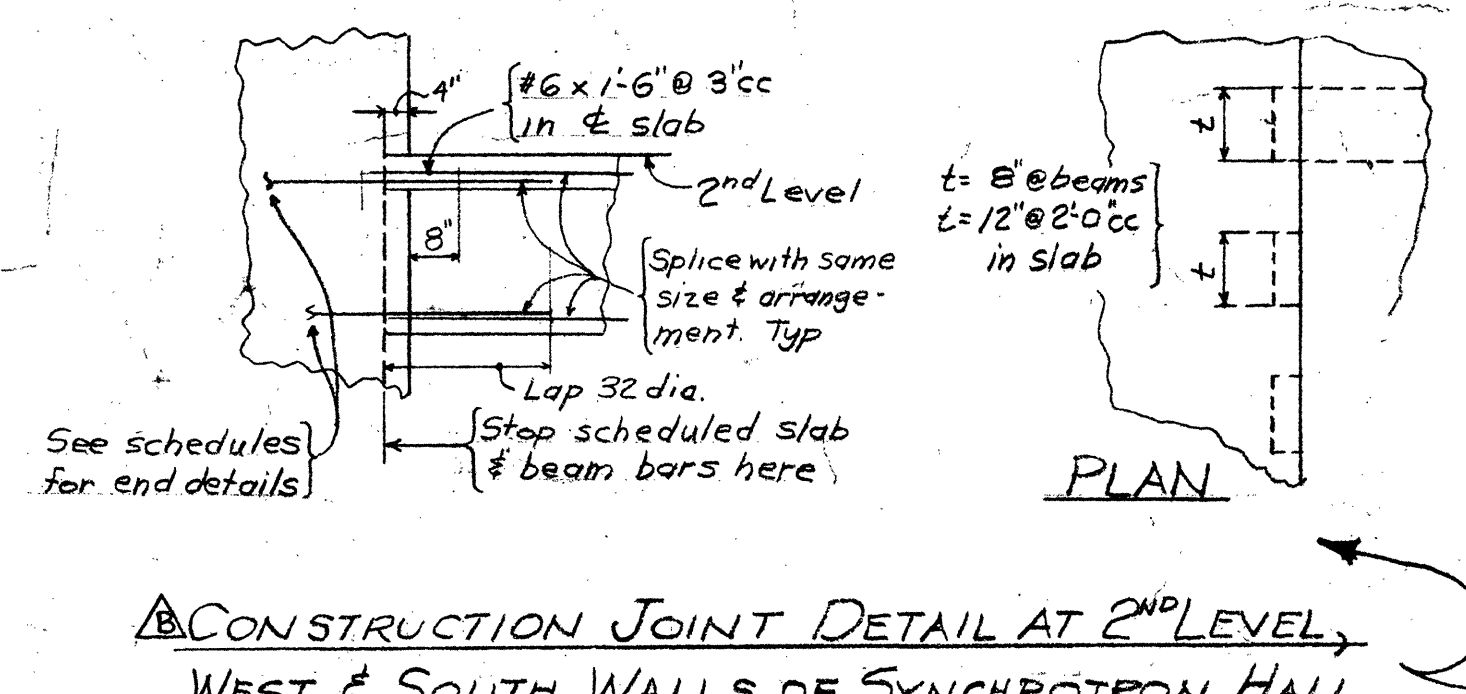
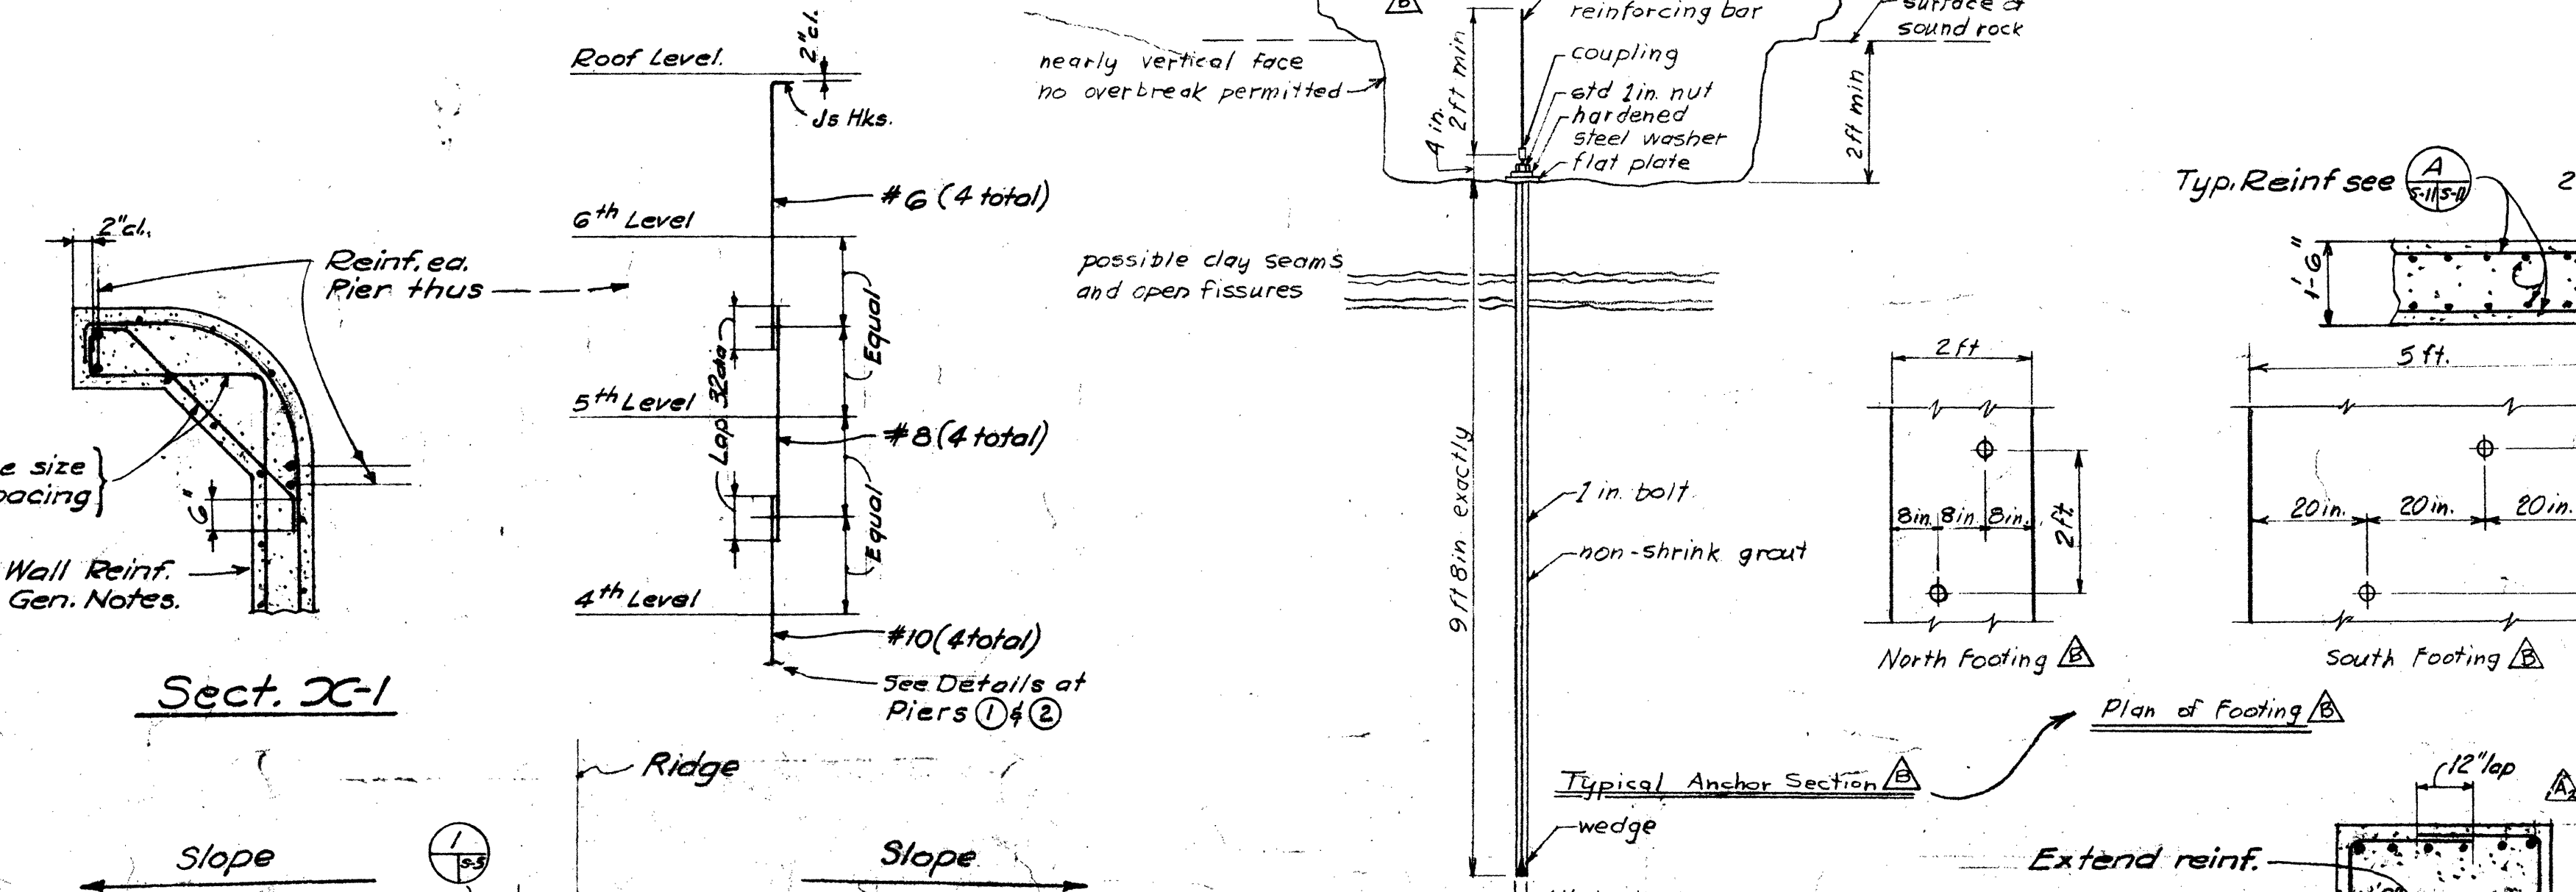
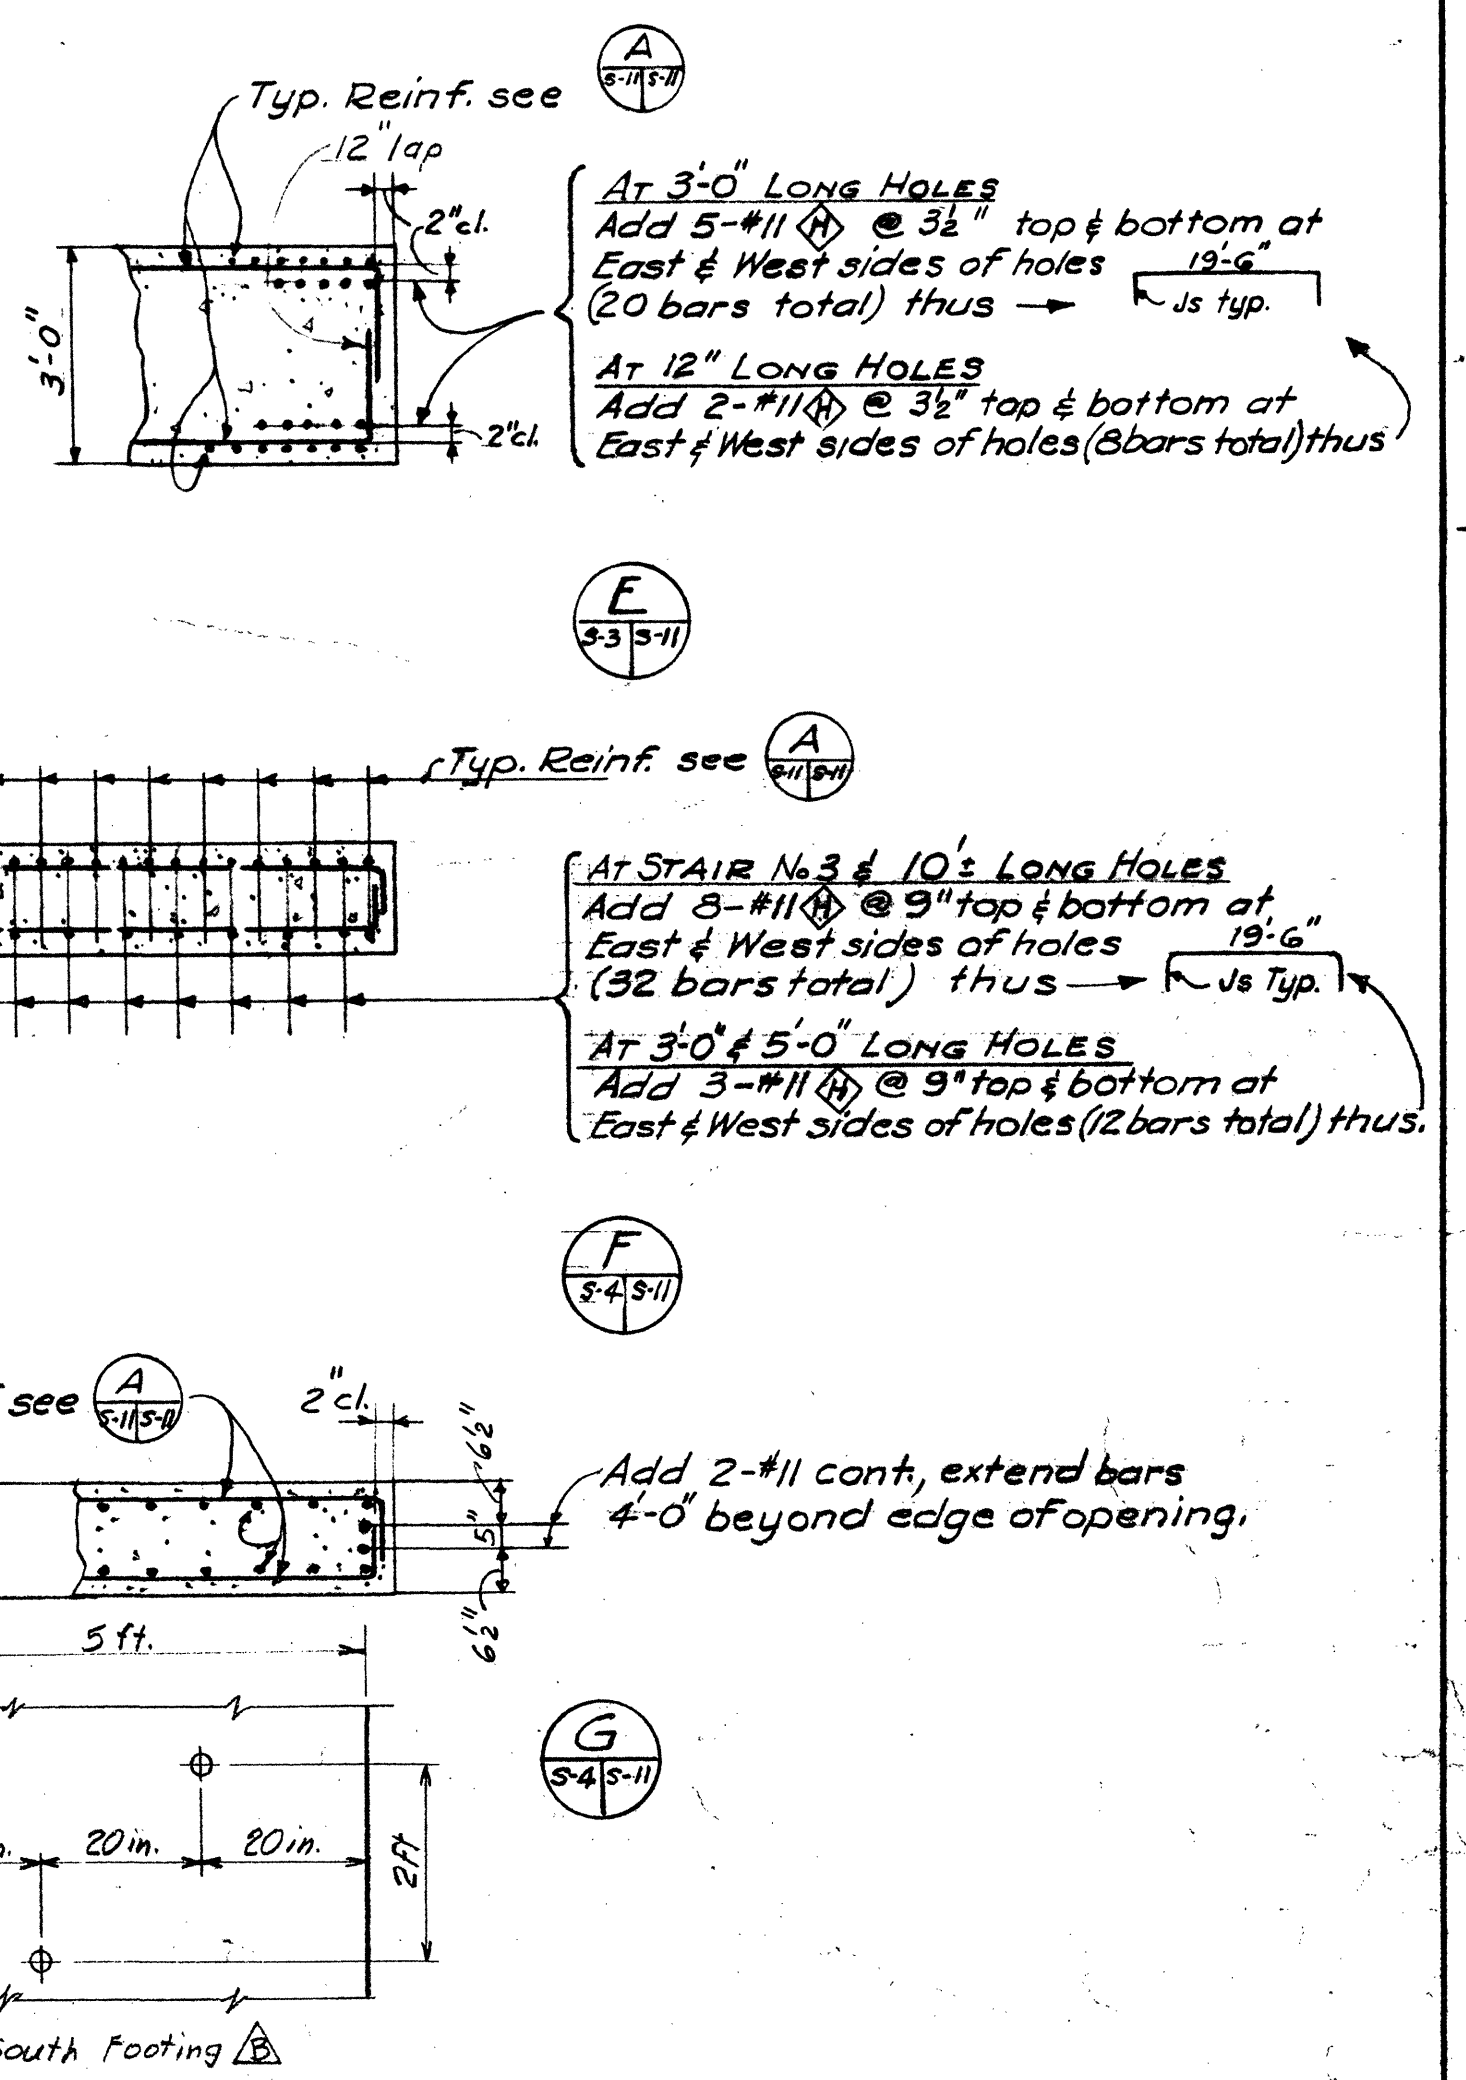


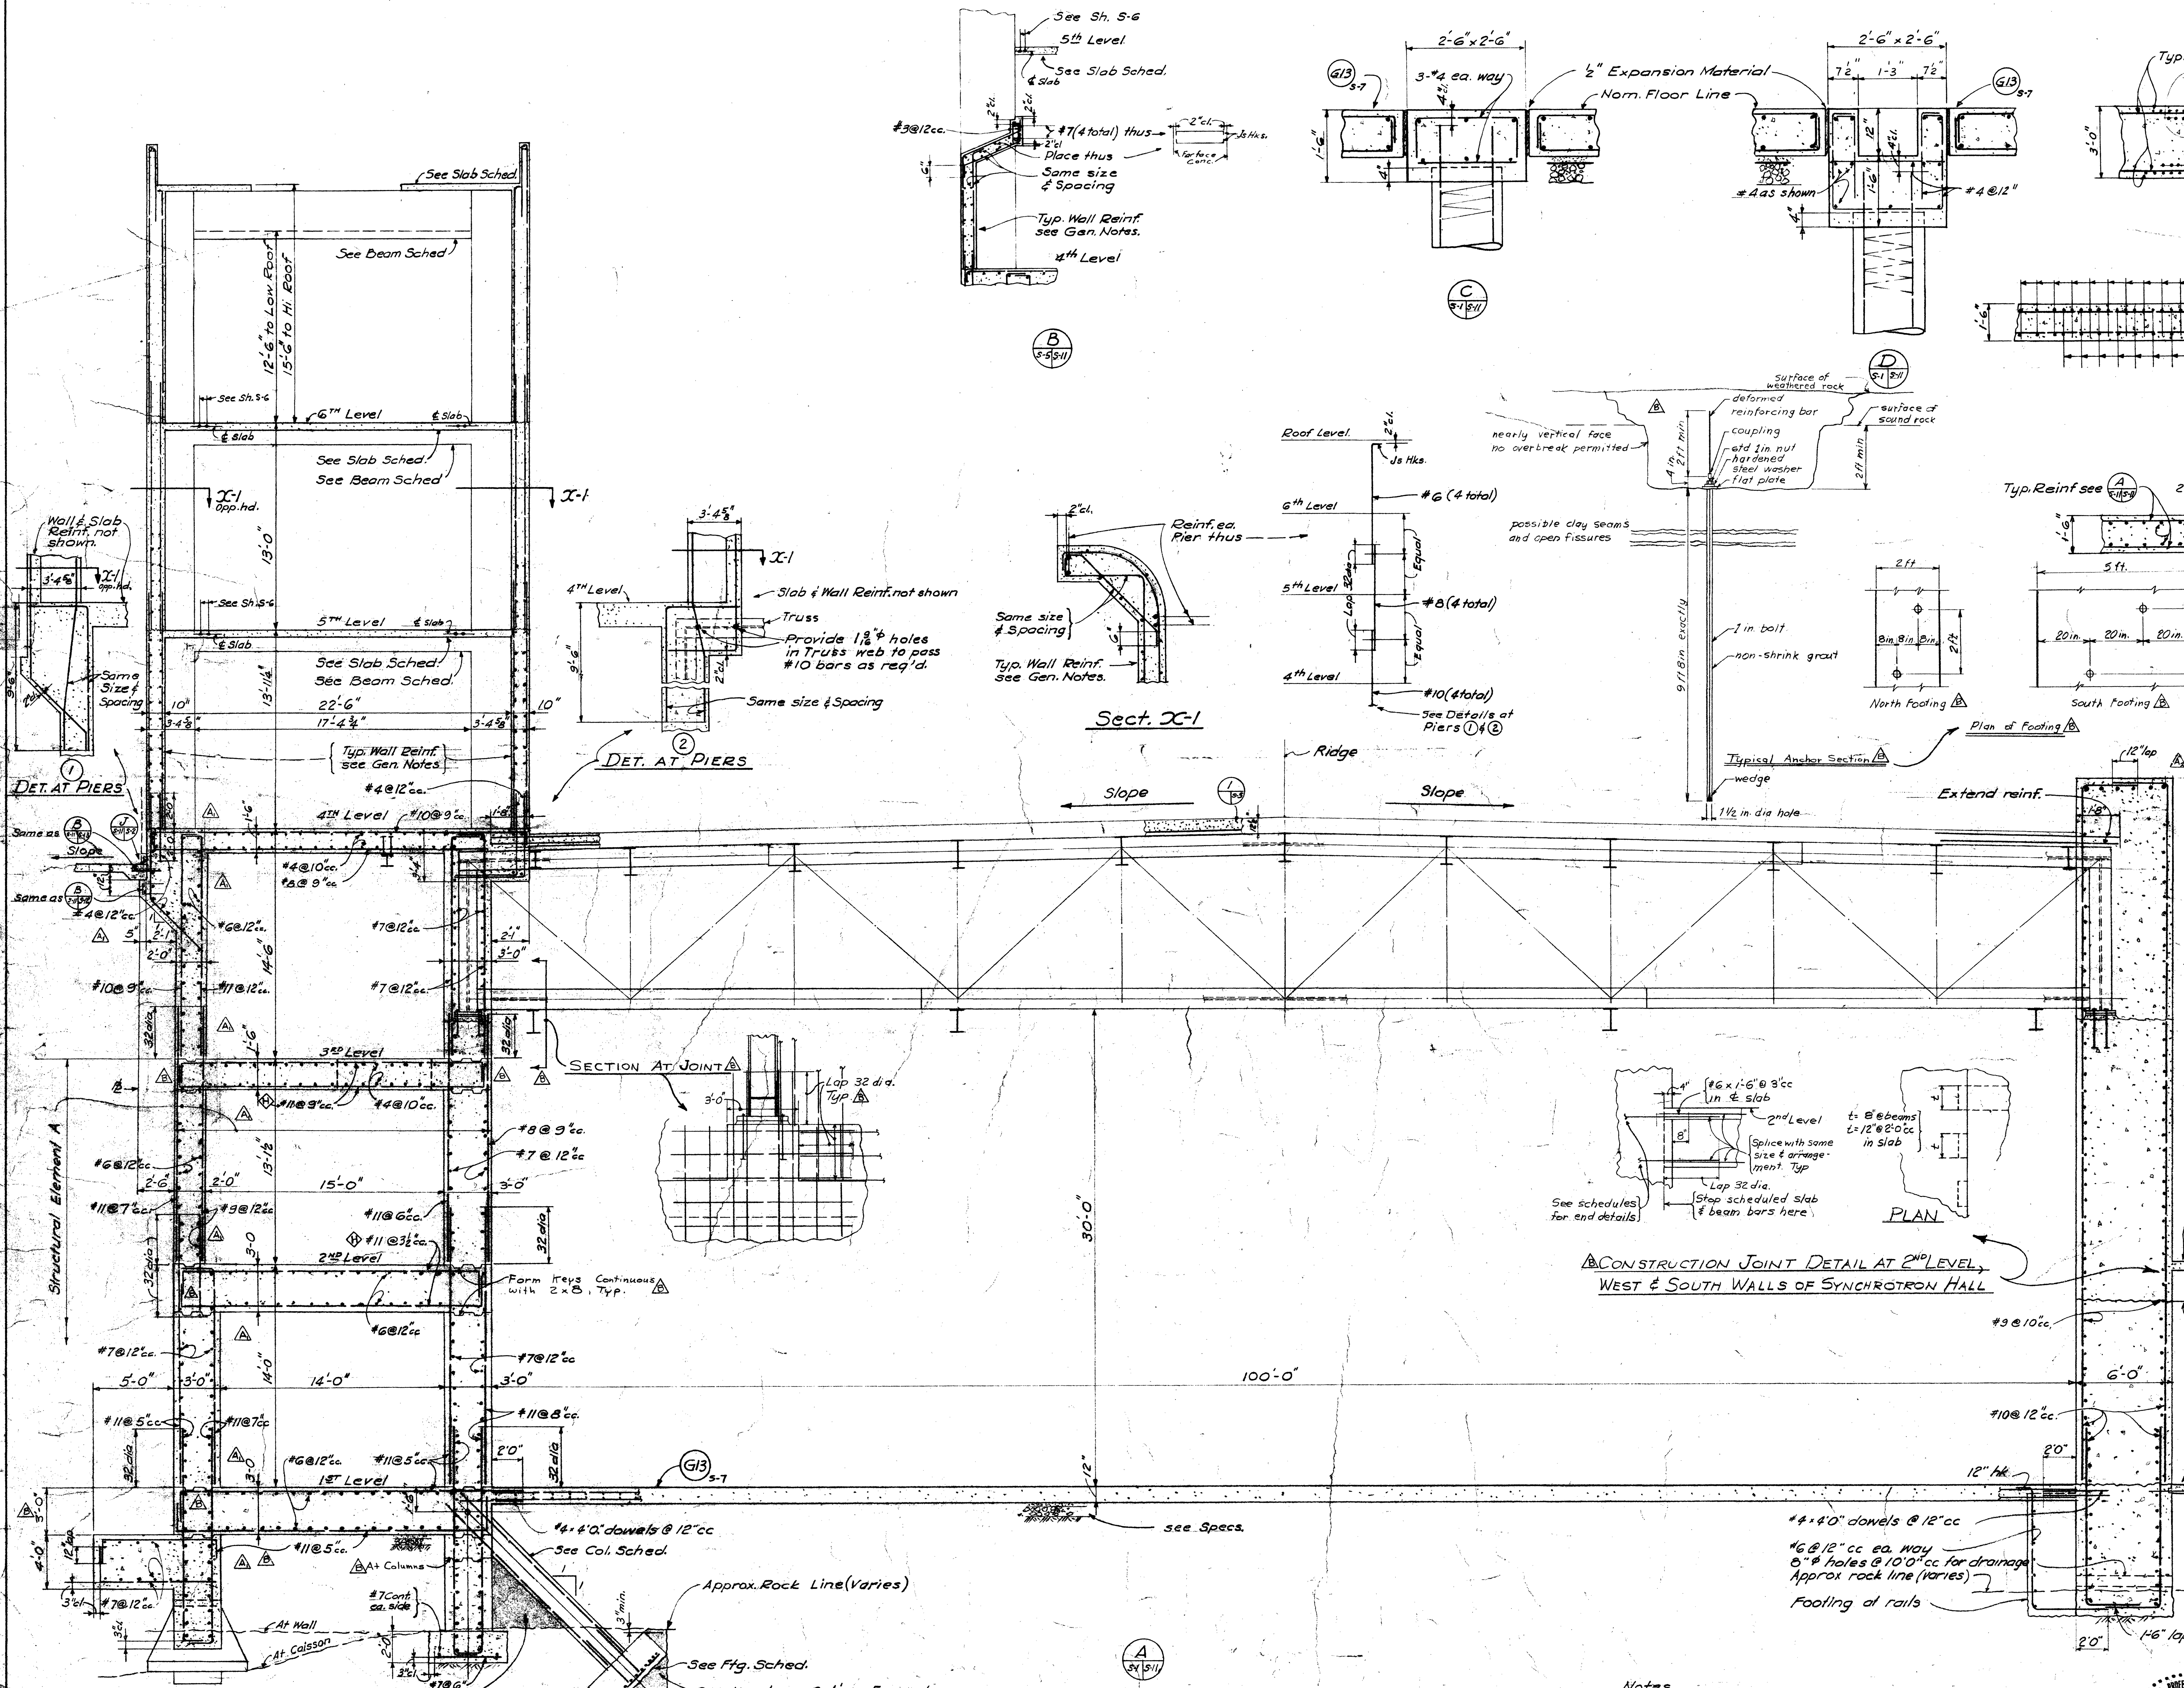

- Notes**
- See General Notes Sh. S-7.
 - The details on this sheet show structural features only. For details & dimensions not shown refer to Arch. and/or Mech. Dwg.
 - Fill indications are symbolic. All fill shall meet specs. requirements.
 - ASTM A 432 Steel.

AS BUILT CORRECTIONS	DATE	BY
2. Added Typ. Marginal Steel Top of South Wall	15 Jan 1964	WMB
1. Deleted Bar Clearances 1964	15 Jan 1964	WMB
Levels 1, 2, 3, 4		

**IO GEV CORNELL
SYNCHROTRON LABORATORY**
CORNELL UNIVERSITY
ITHACA NEW YORK

STRUCTURAL DETAILS

WILLIAM M. BROBECK AND ASSOCIATES
IAN MACKINLAY, AIA
PREGNOFF & MATHEU
JACOBS ASSOCIATES
990 GILMAN ST.
TELEPHONE 415-524-8664

DR.	CHK.	J.N.	SUPV.	SCALE
RELEASED	APPROVED			
LAB NUCLEAR STUDIES				
DATE NOV 15, 1963	DATE JAN 15, 1964			
2085-33-65-111	044 240 Cornell University B. & P.			