
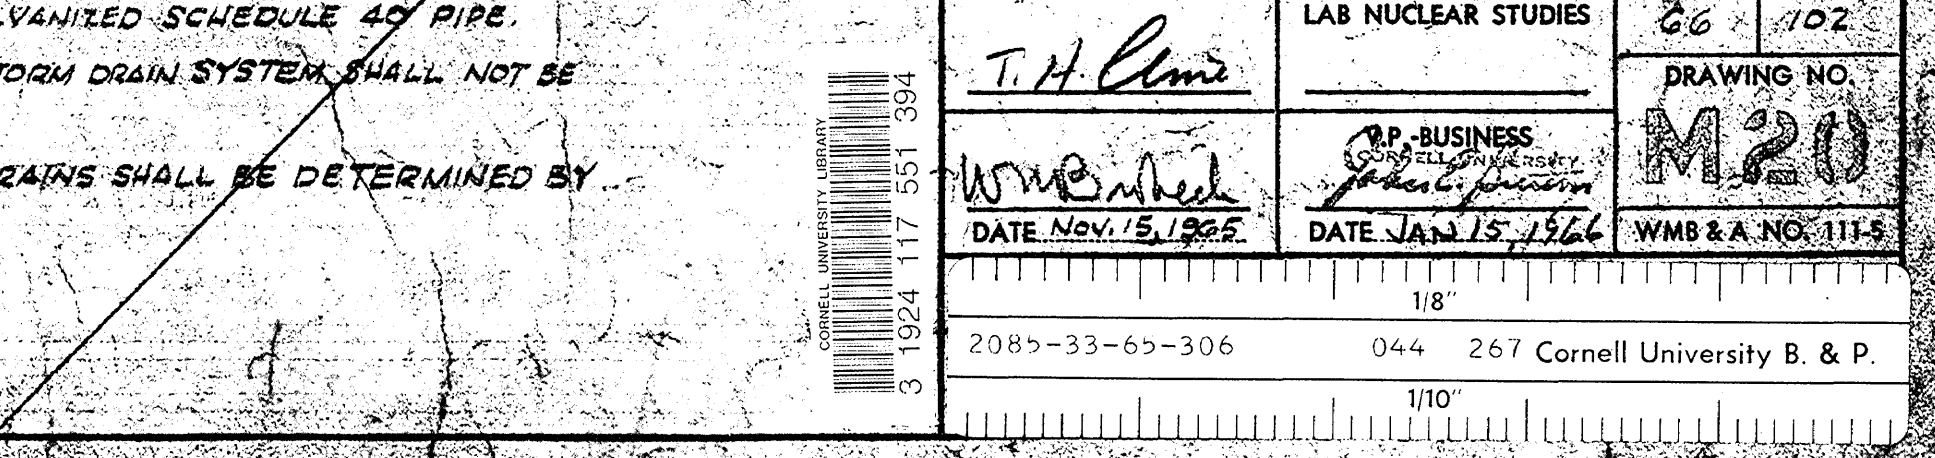
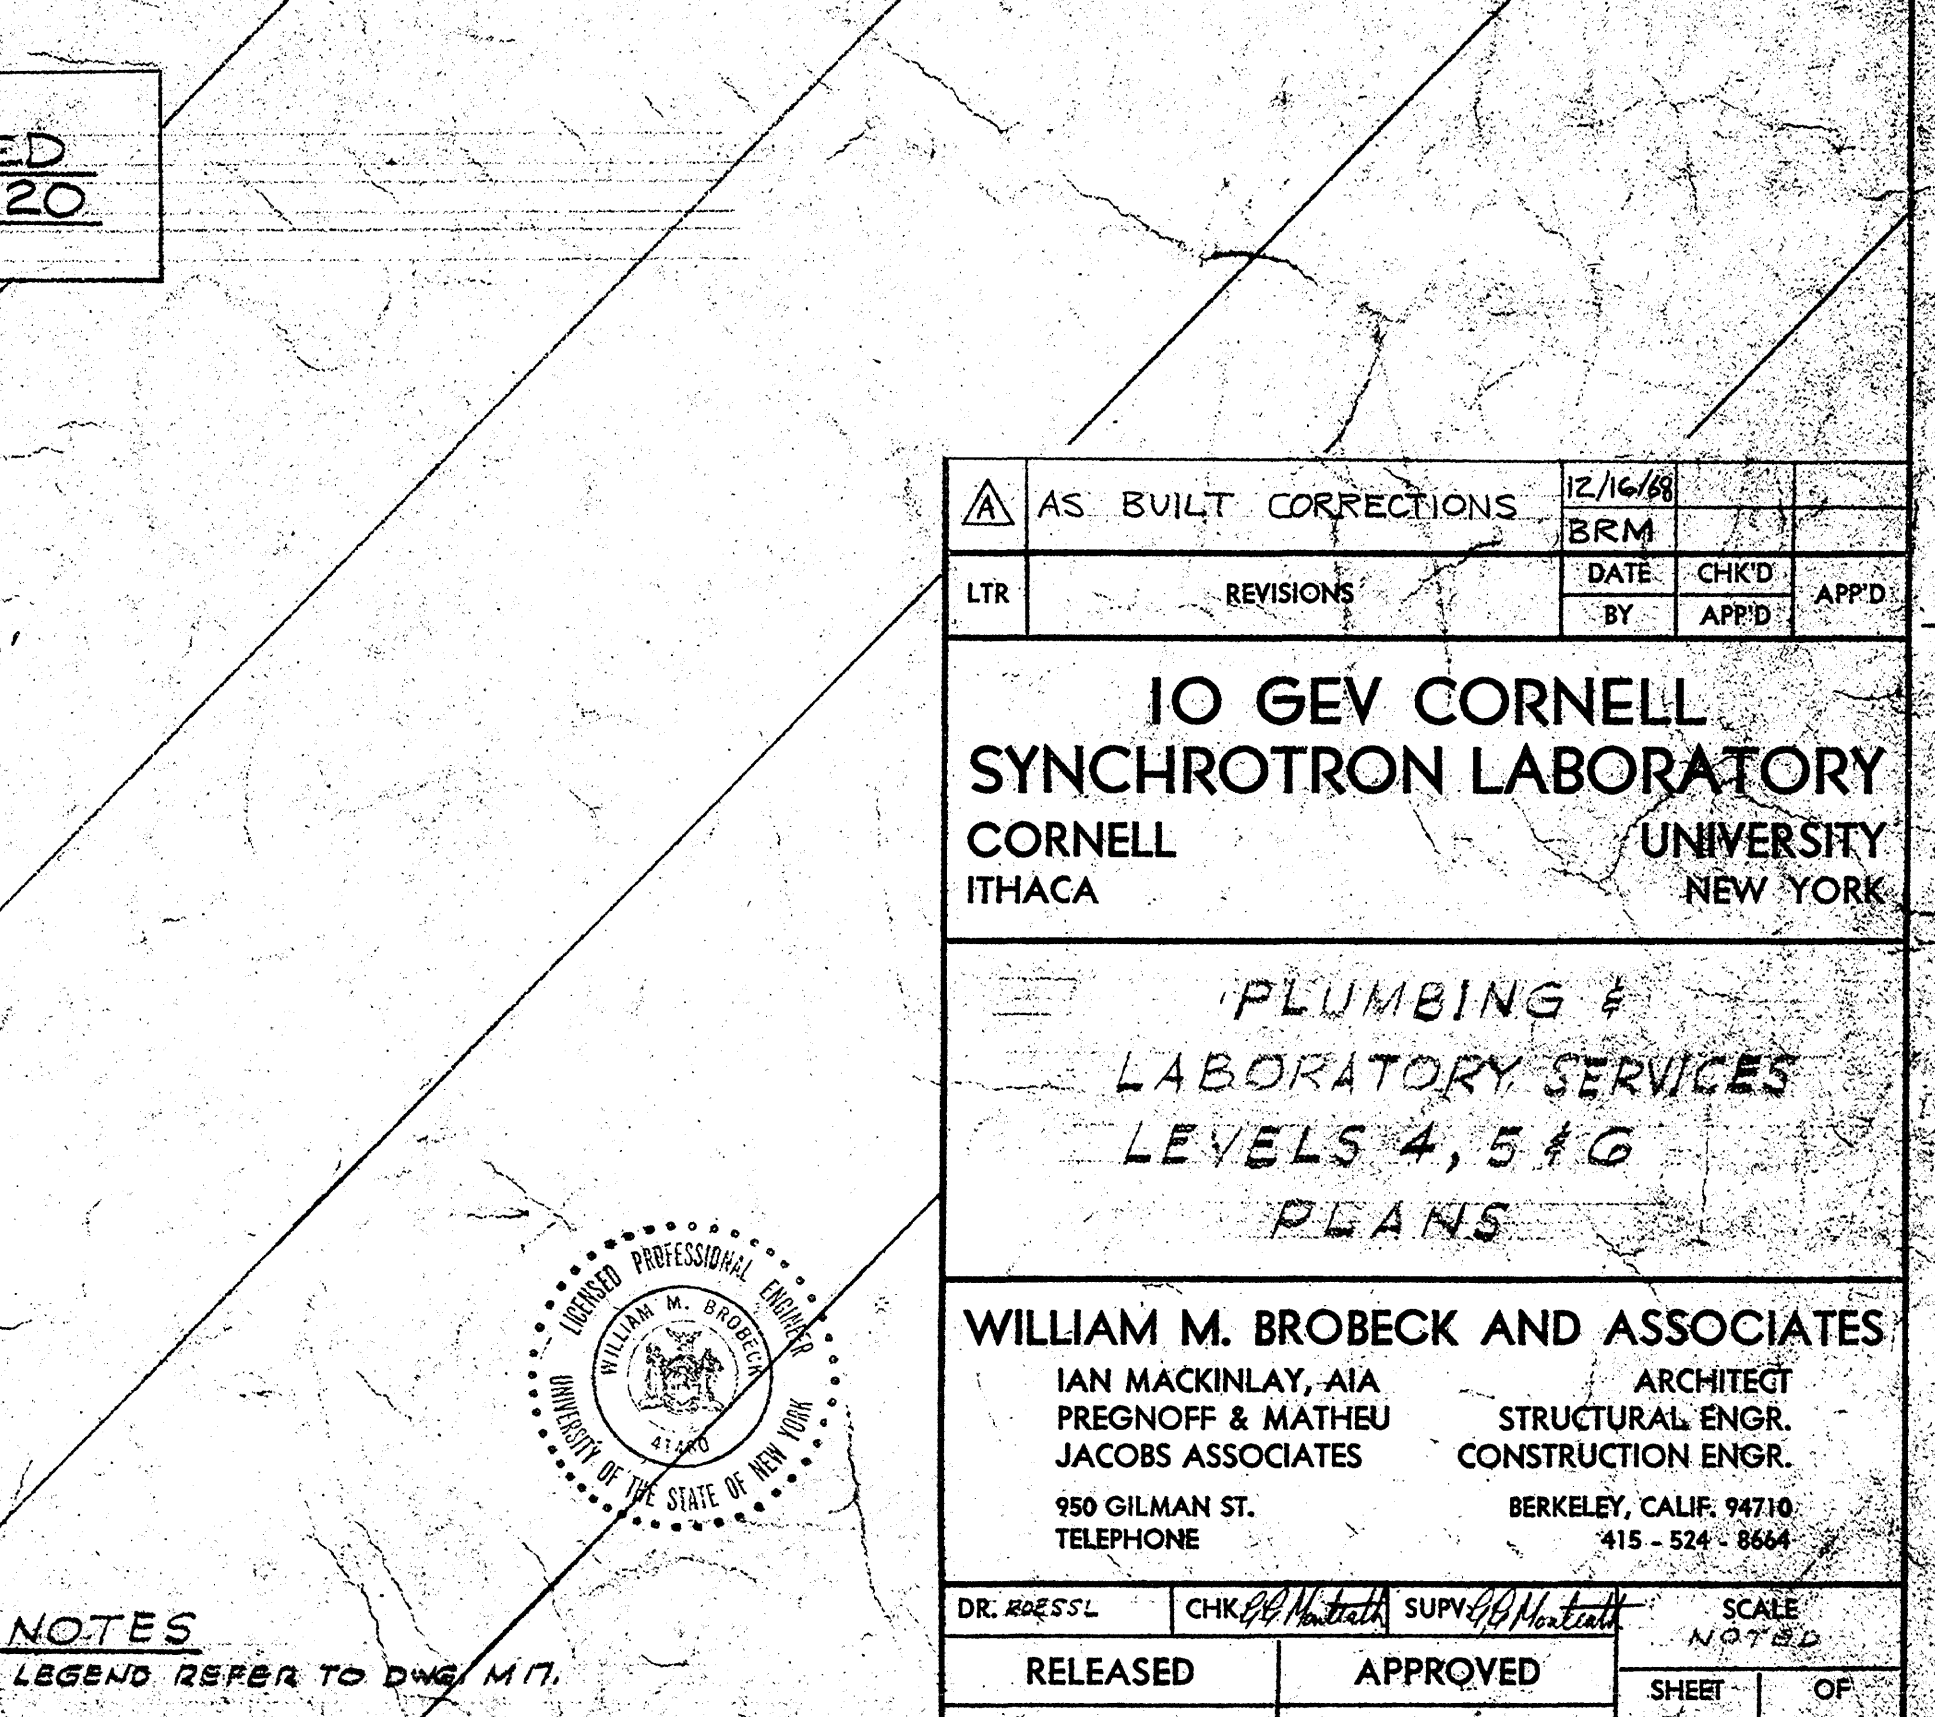
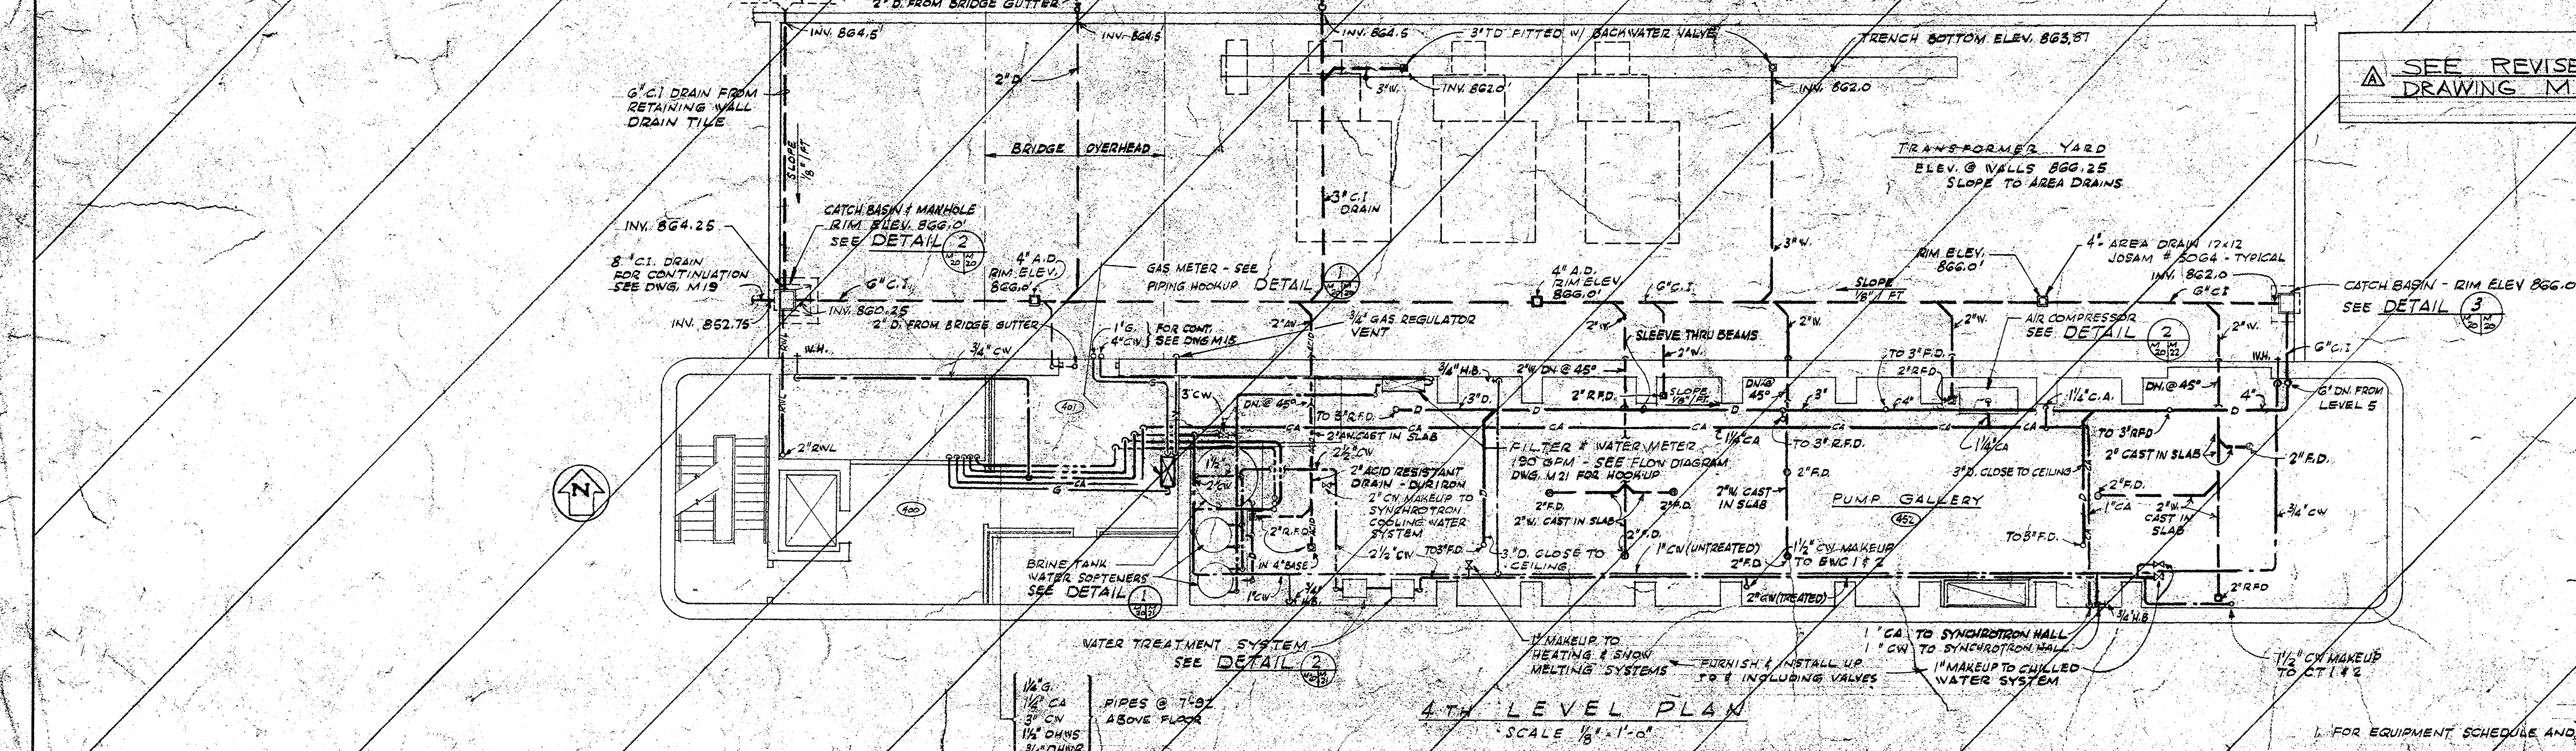
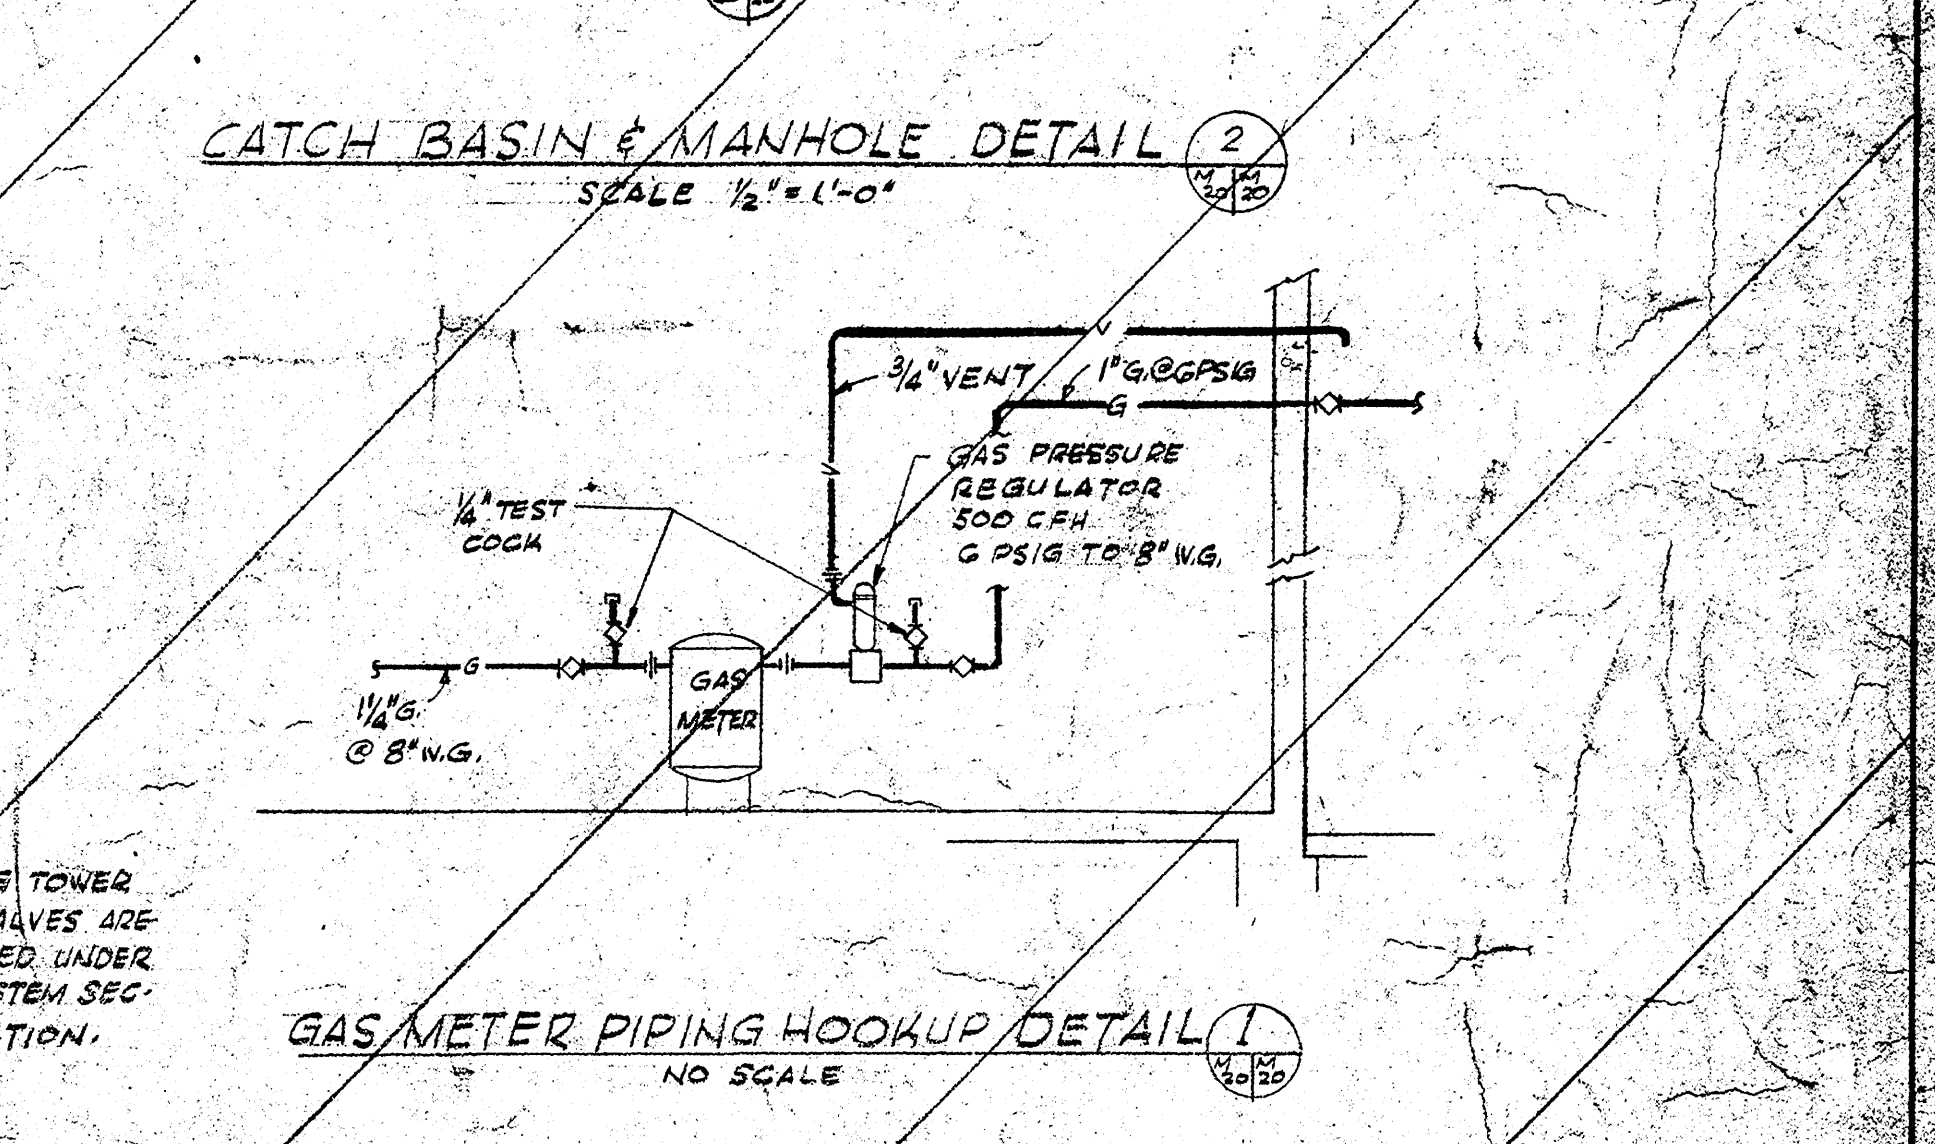
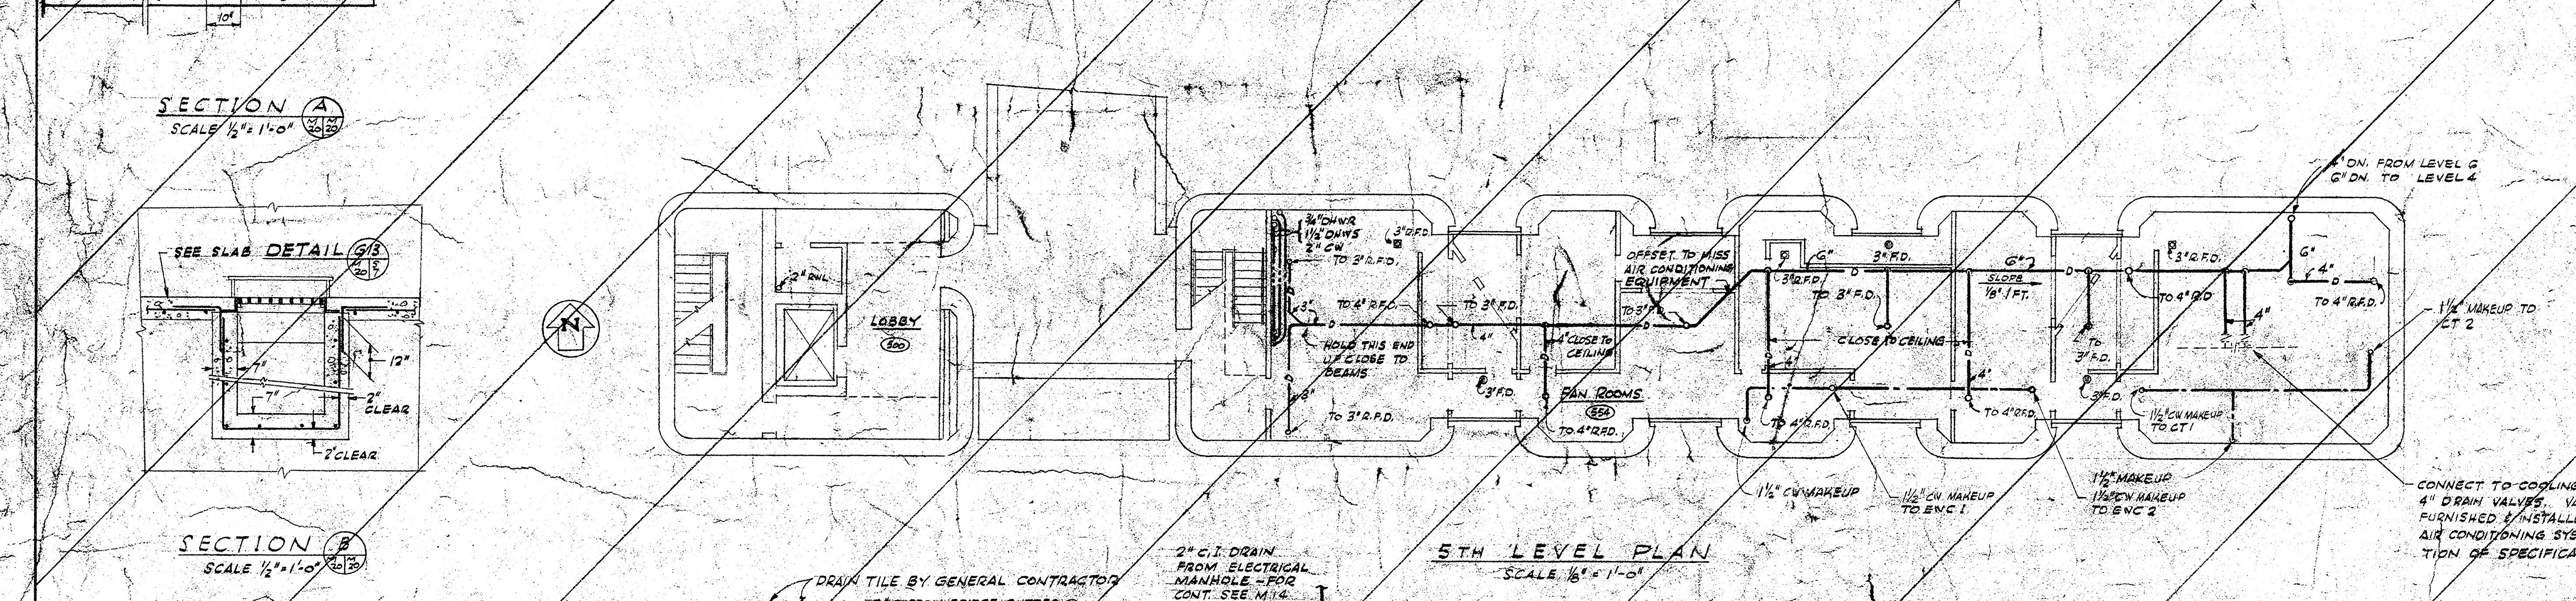
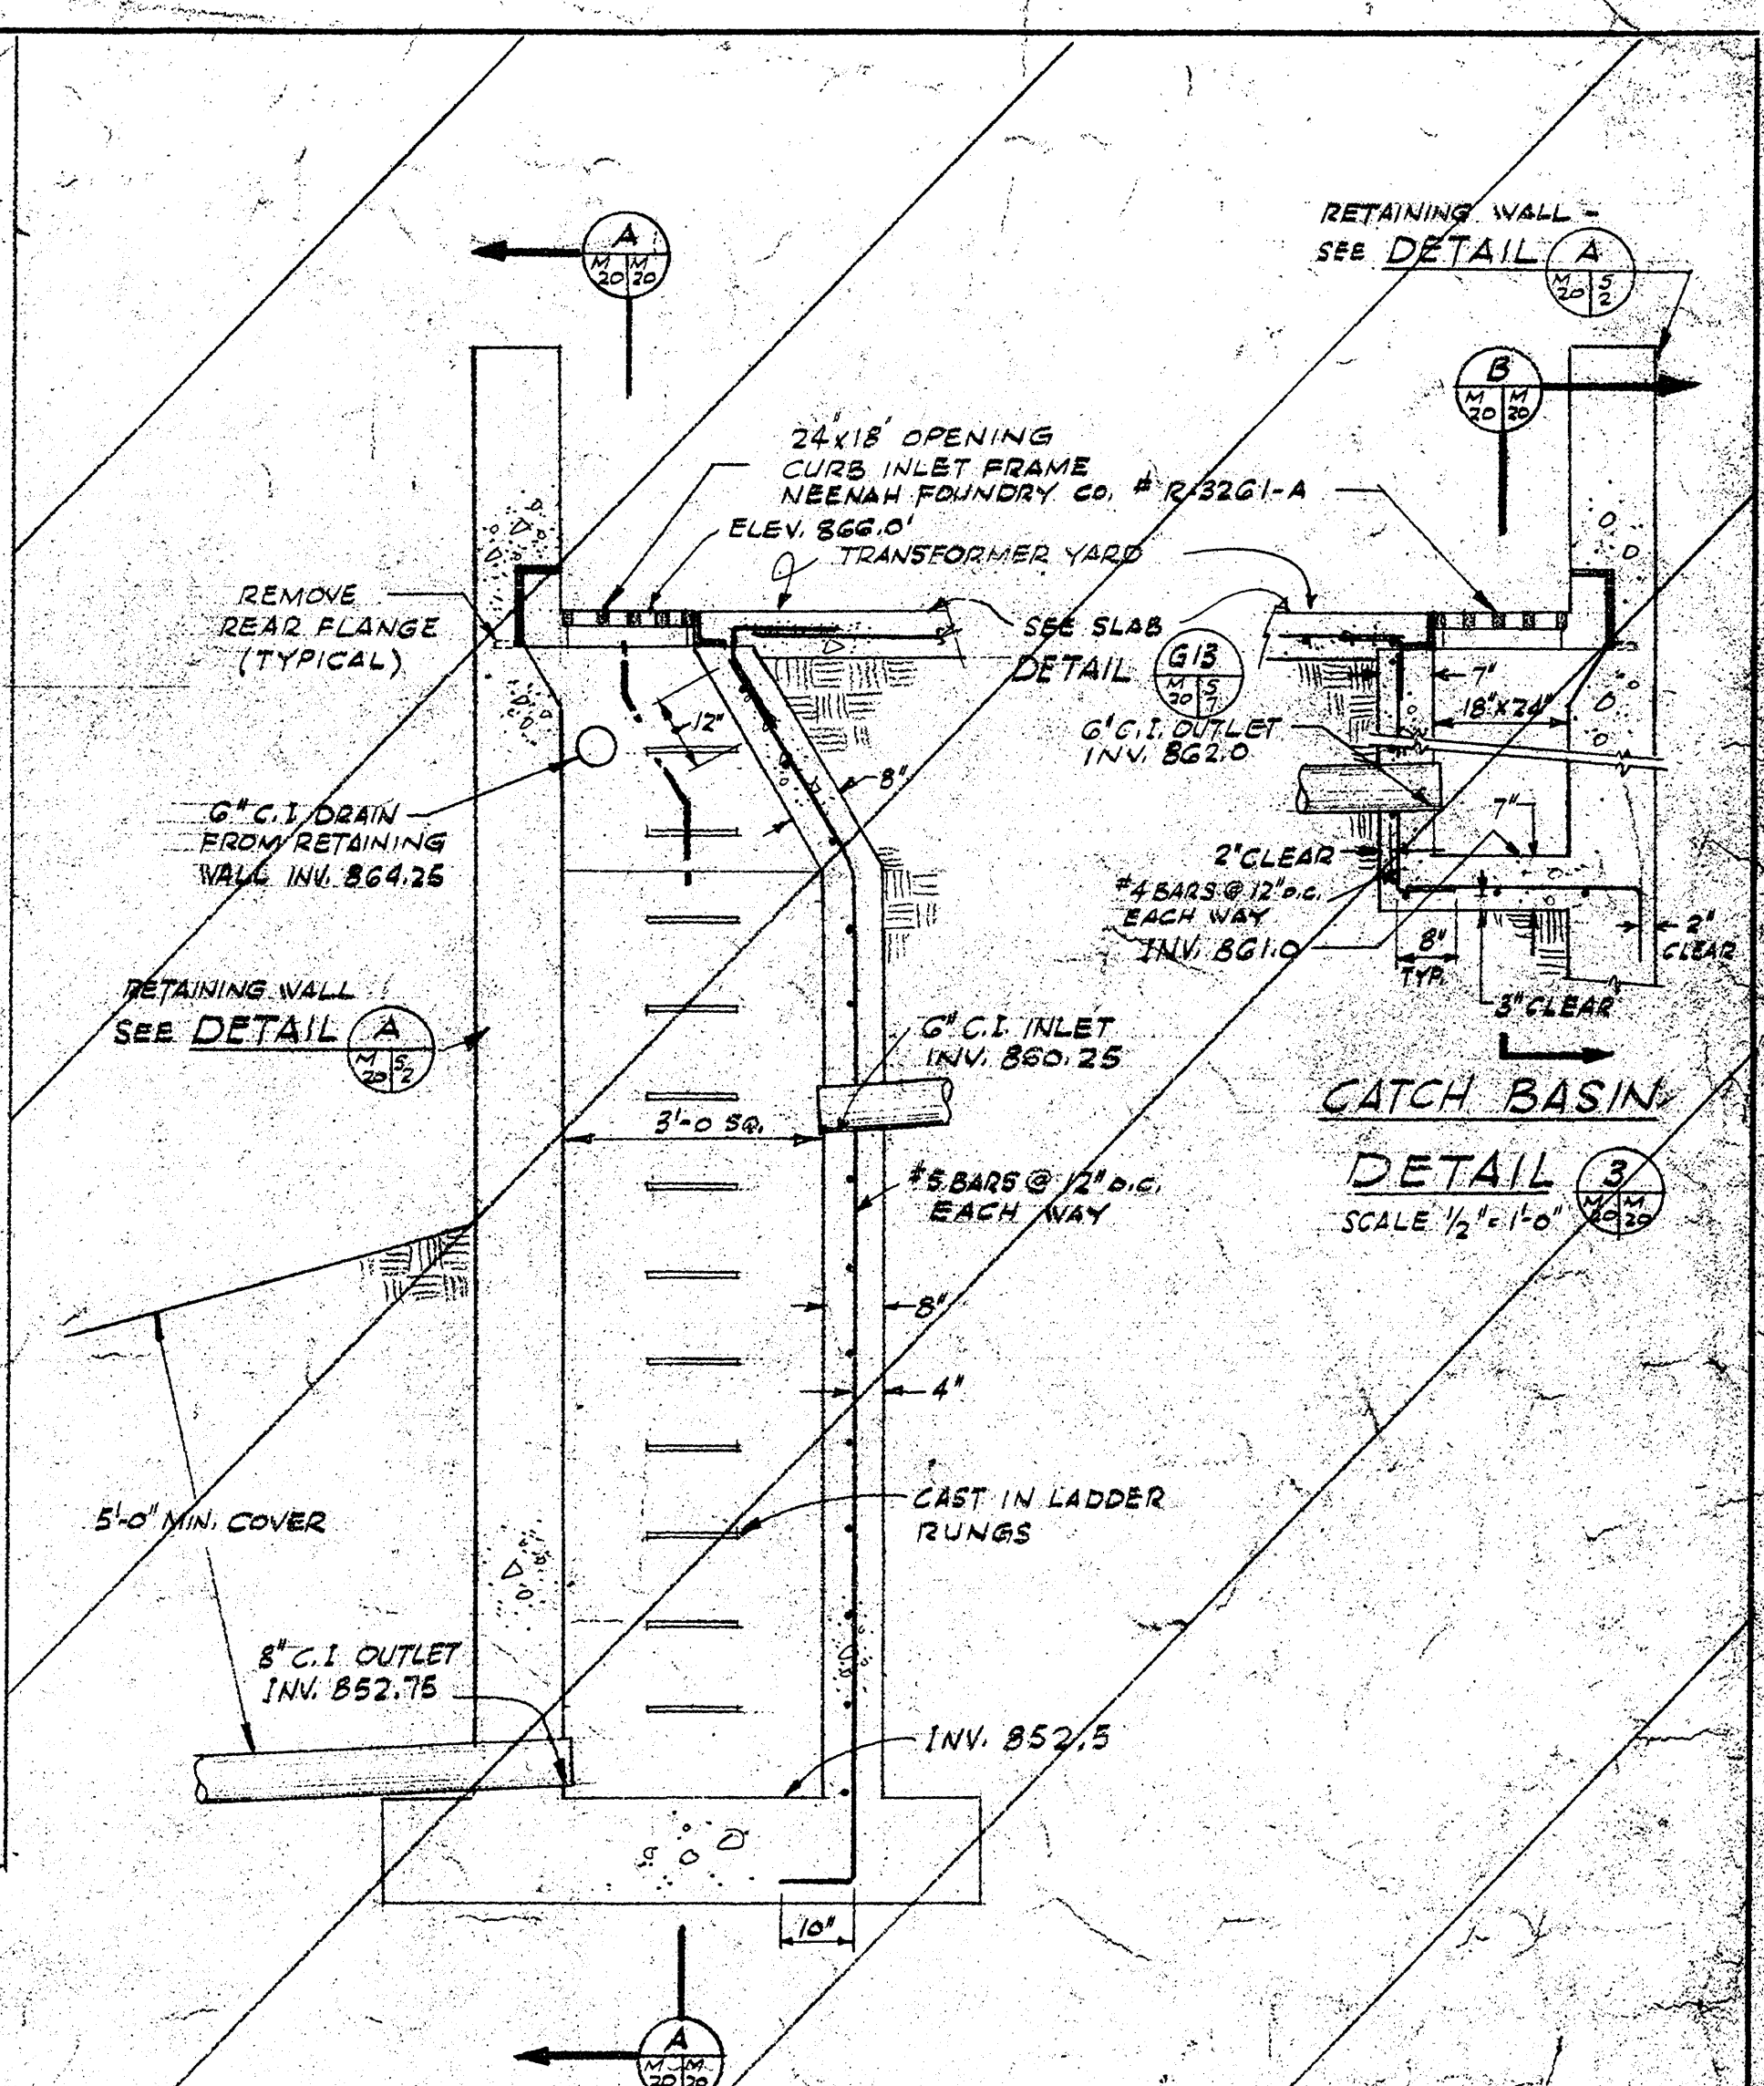


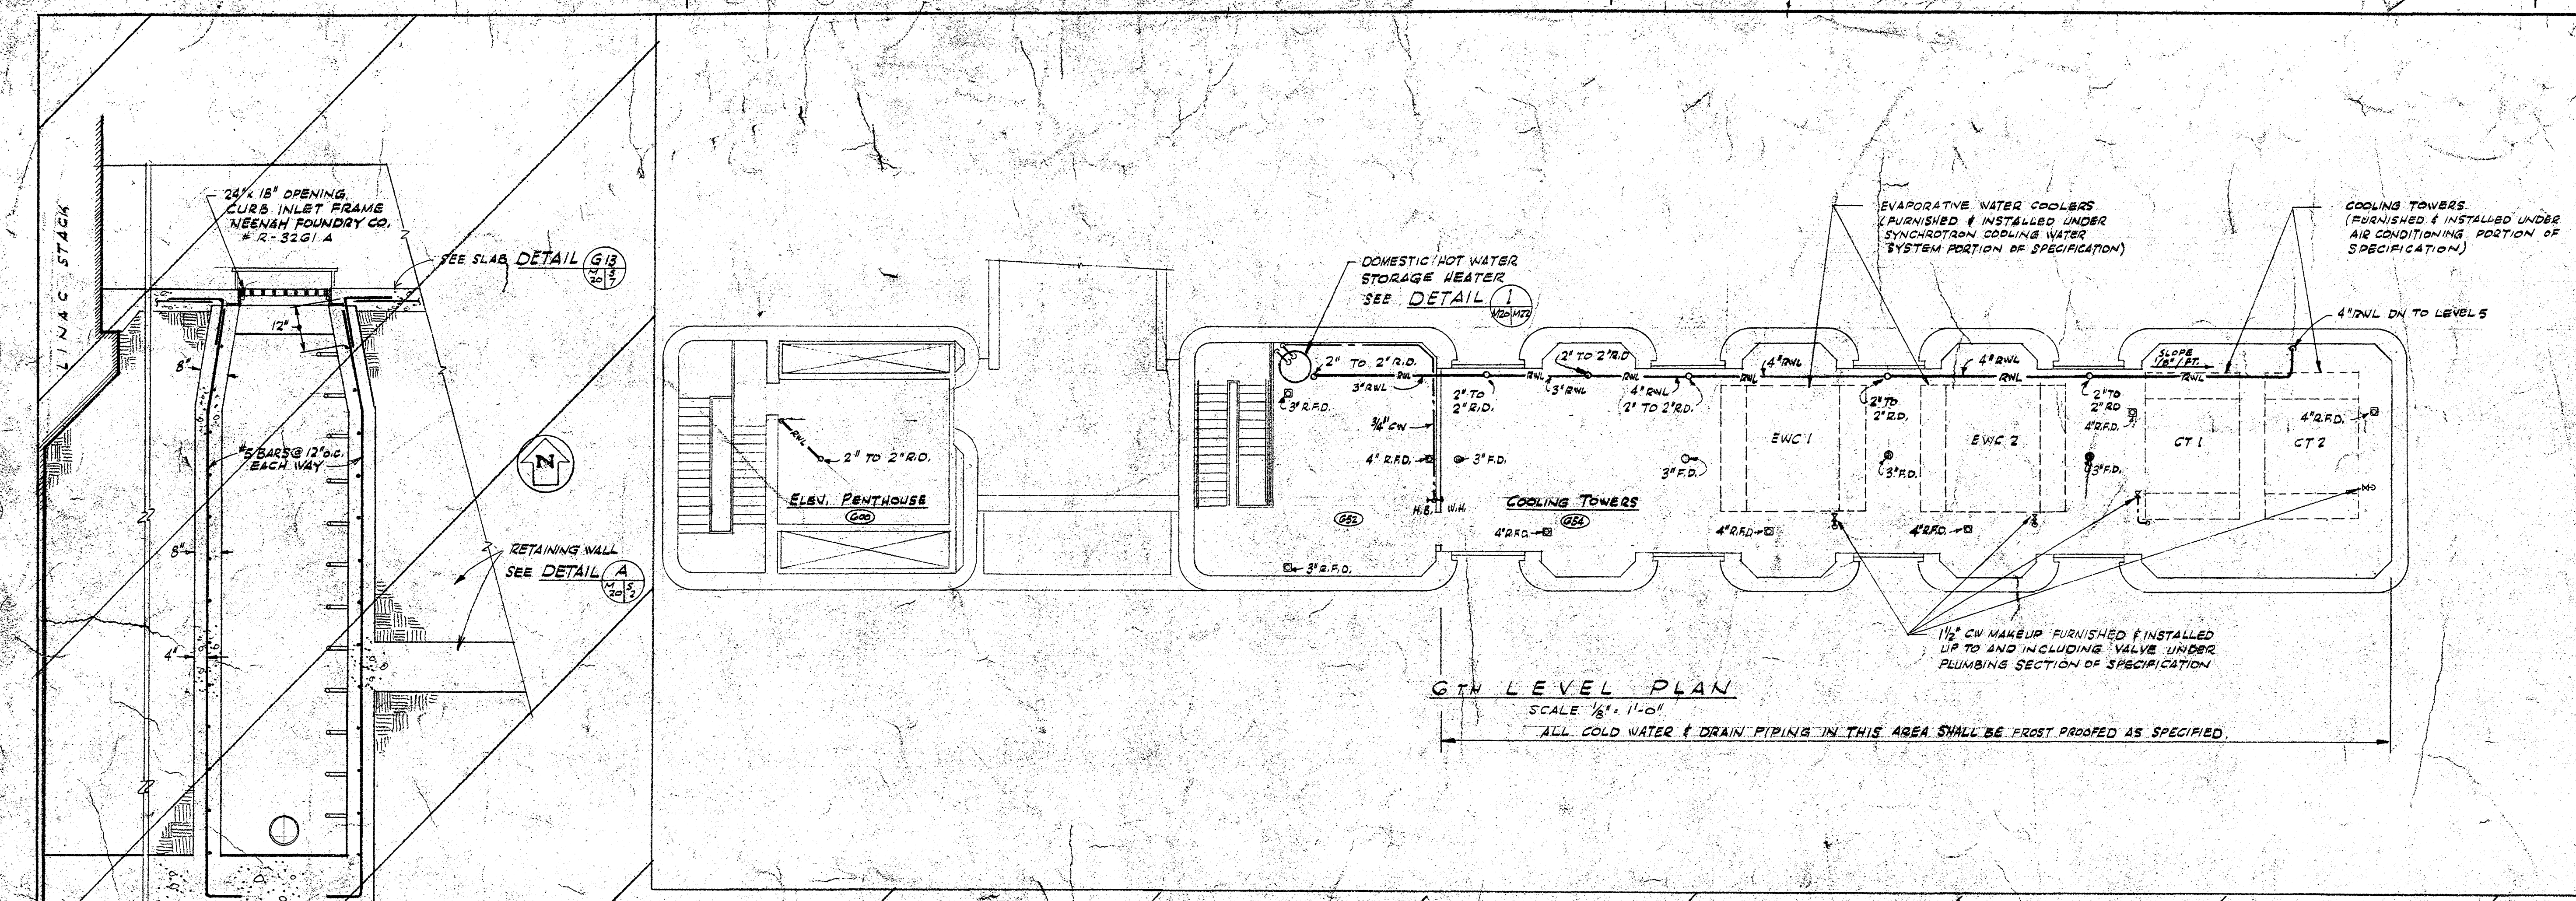

AS BUILT CORRECTIONS		12/16/98		
LTR	REVISIONS	DATE	CHKD	APPD
IO GEV CORNELL SYNCHROTRON LABORATORY CORNELL UNIVERSITY ITHACA, NEW YORK				
PLUMBING & LABORATORY SERVICES LEVELS 4, 5 & 6 PLANS				
WILLIAM M. BROBECK AND ASSOCIATES IAN MACKINLAY, AIA ARCHITECT PREGNOFF & MATHEU STRUCTURAL ENGR. JACOBS ASSOCIATES CONSTRUCTION ENGR. 980 GILMAN ST. BERKELEY, CALIF. 94710 TELEPHONE 415-524-8864				
DR. DESIGNED	CHKD	SUPD	SCALE	NOTED
RELEASED	APPROVED		SHEET	OF
	LAB NUCLEAR STUDIES		66	102
T.H. Lewis DATE NOV. 15, 1998		WMB DATE JAN. 15, 1999 WMB & A NO. 111-5		
2085-33-69-306 044 267 Cornell University B. & P.				