

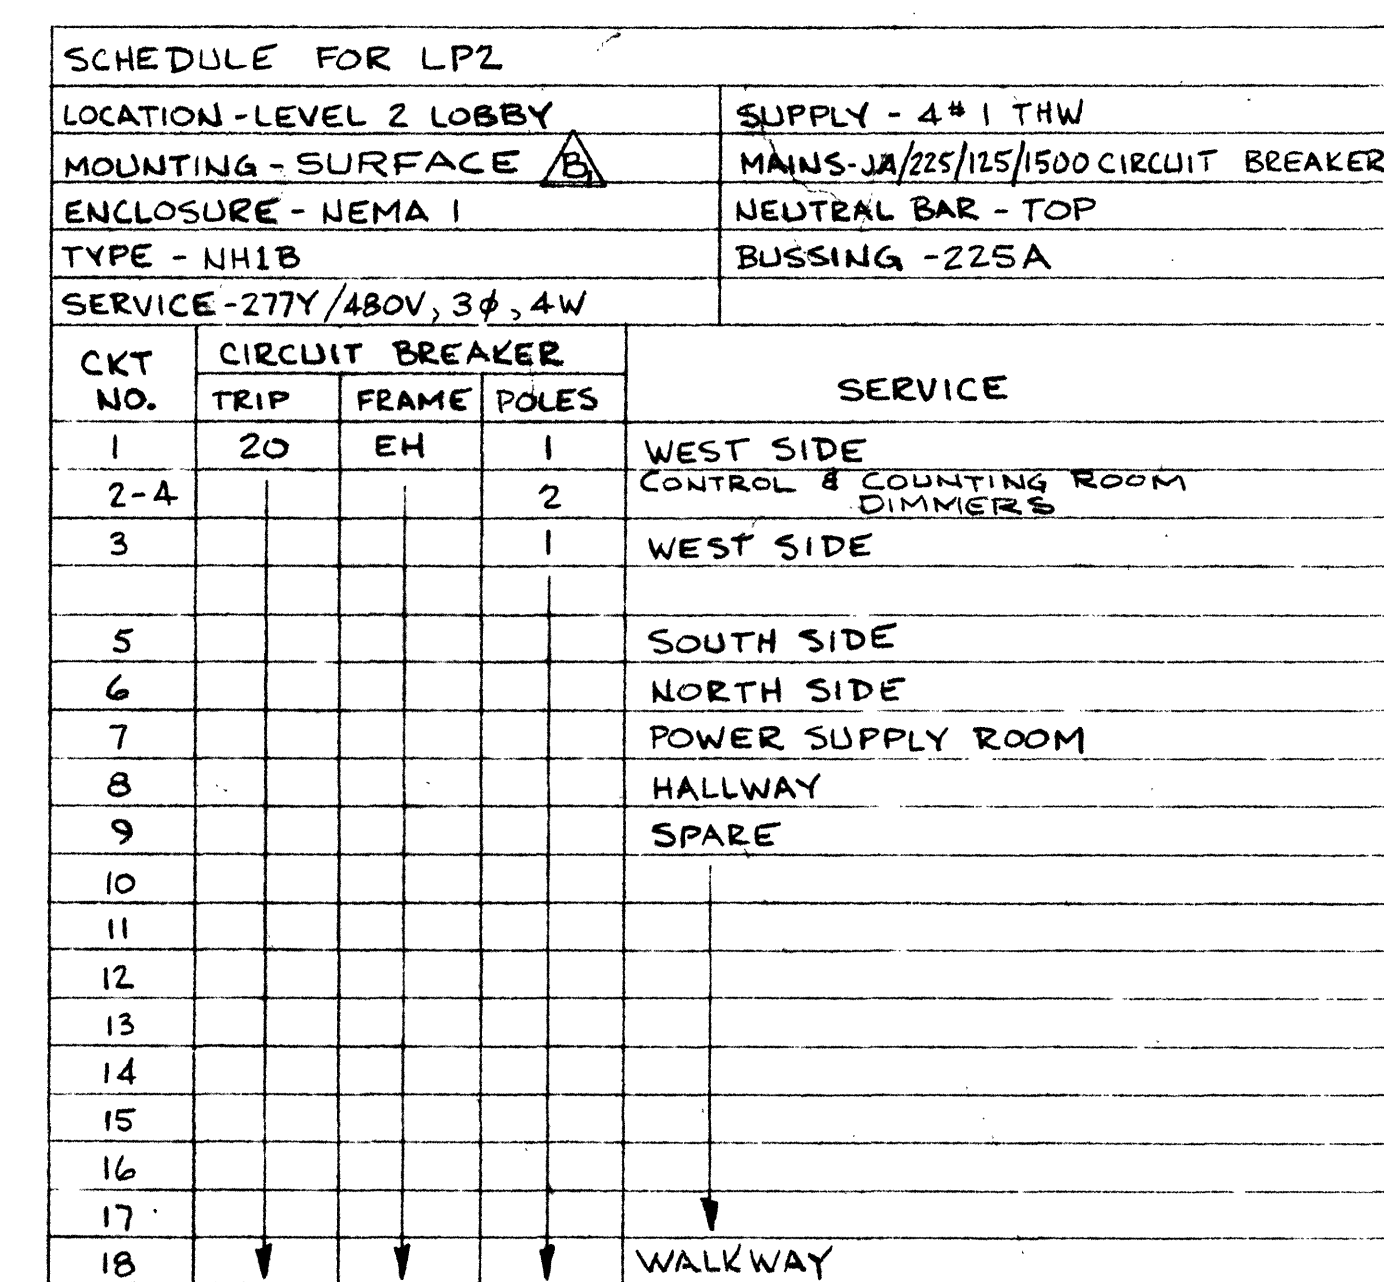



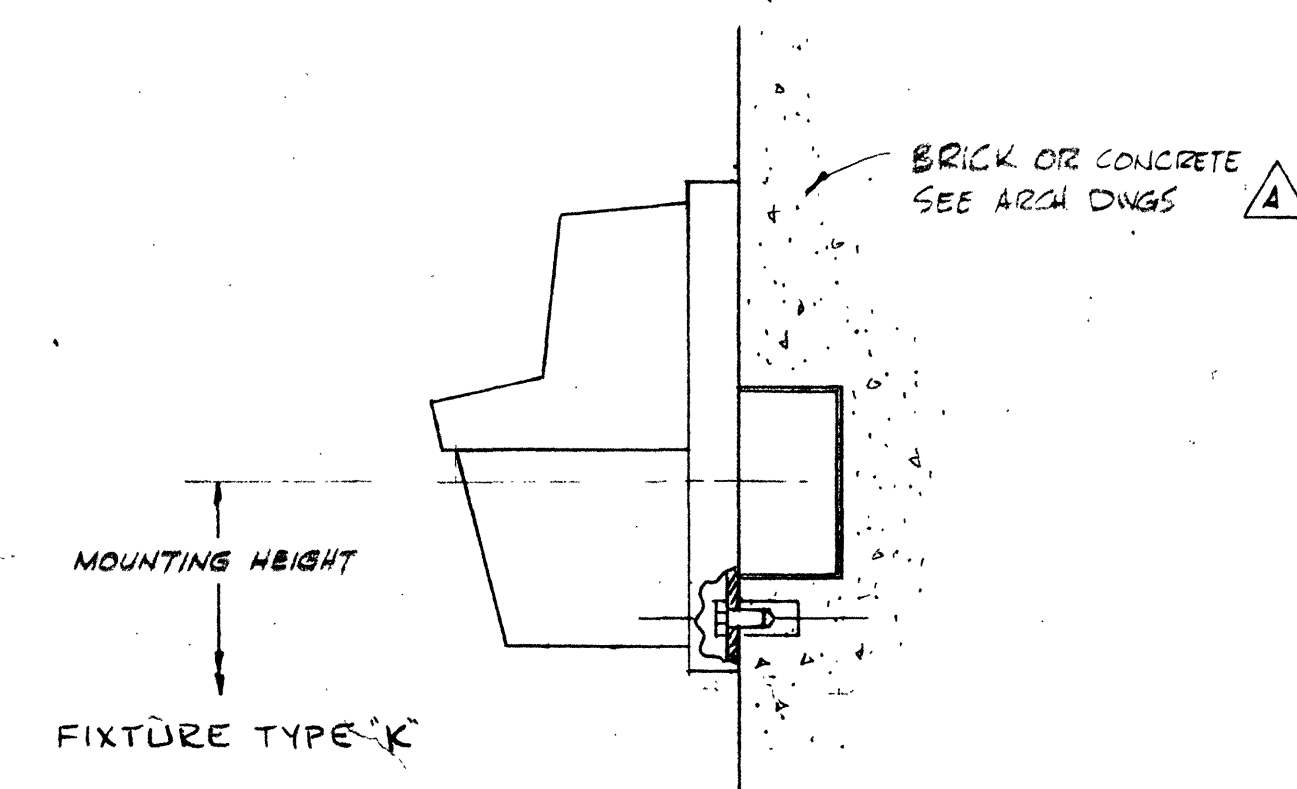


LIGHTING FIXTURE MOUNTING HEIGHT SCHEDULE		
ROOM NAME & NUMBER	FIXTURE TYPE	MOUNTING HEIGHT FROM FIN. FLOOR
(200)	TYPE "E"	9'-0"
WEN. TOILET (201)	TYPE "H"	9'-0"
LOCKERS (202)	TYPE "I"	9'-0"
JANITOR (203)	TYPE "J"	9'-0"
CLEAN ROOM (204)	TYPE "F"	9'-0"
(205)	TYPE "I"	9'-0"
DADA ROOM (206)	TYPE "F"	9'-0"
COMPUTER C.D. (207)	TYPE "F"	9'-0"
OFFICE (208)	TYPE "F"	9'-0"
OFFICE (209)	TYPE "F"	9'-0"
ELECTRONIC SHOP (210)	TYPE "F"	9'-0"
LABORATORY (211)	TYPE "F"	9'-0"
LABORATORY (212)	TYPE "F"	9'-0"
CONTROL (213)	TYPE "F"	9'-0"
COUNTING (214)	TYPE "F"	9'-0"
LABORATORY (215)	TYPE "F"	9'-0"
STU. FACULTY SHOP (216)	TYPE "D"	11'-0"
STOCK ROOM (217)	—	—
SOLV. WASH. TND. (218)	TYPE "G"	12'-0"
POWER SUPPLY RM. (219)	TYPE "B"	11'-7 1/2"


- NOTES:
1. ALL CONDUCTORS ARE #10 THW, EXCEPT AS SHOWN OTHERWISE.
 2. ALL RACEWAYS ARE UNISTRUT, EXCEPT AS SHOWN OTHERWISE.
 3. STUB UP INTO SUSPENDED CEILING AREA FROM PANEL LP2; 4'-1" EMPTY CONDUITS FOR FUTURE USE.
 4. DARK ROOM FIXTURE "B" ON
B. WHEN DARKROOM OVERHEAD LIGHTS ARE OFF

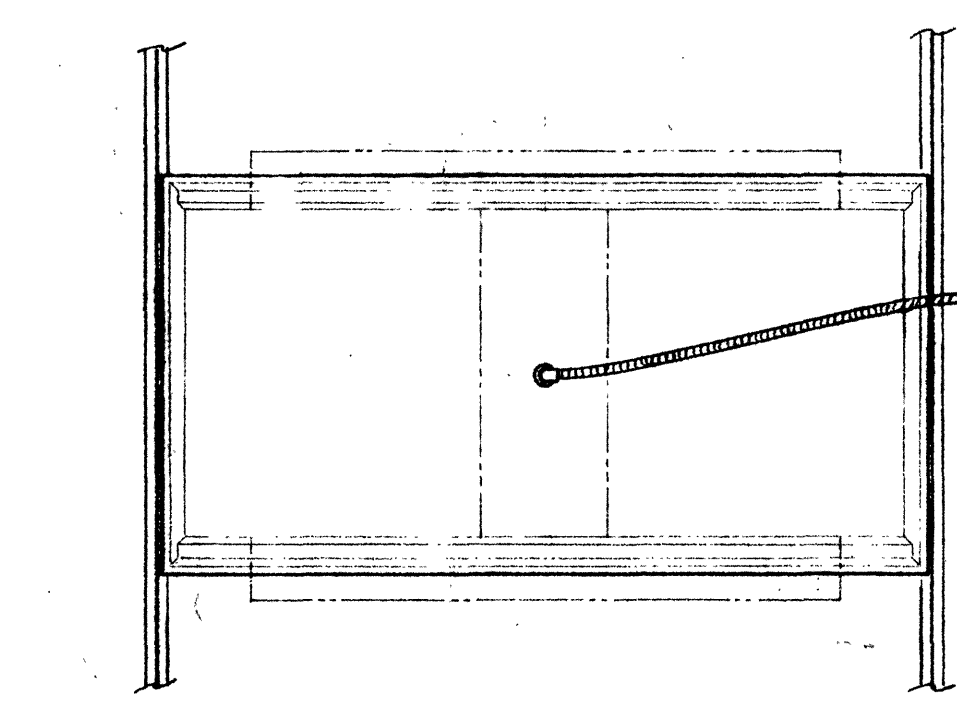


DETAIL 
SCALE: 3"=1'-0"

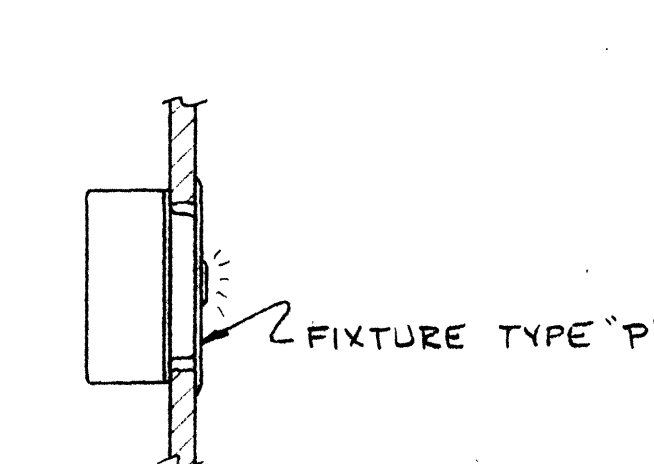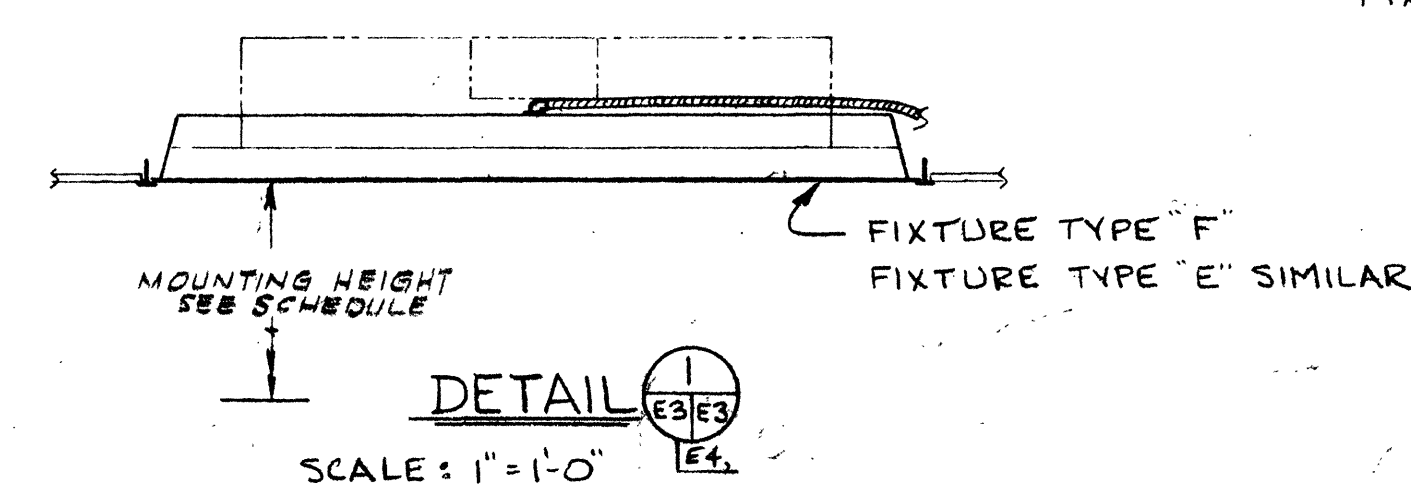


DETAIL 2
E3E3
SCALE: 3"=1'-0"

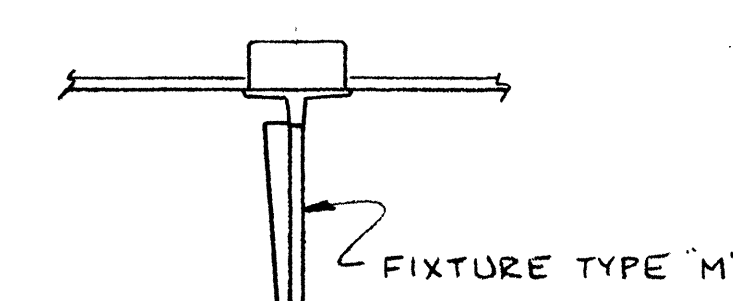


DETAIL 
SCALE: $1\frac{1}{2}'' = 1'-0''$

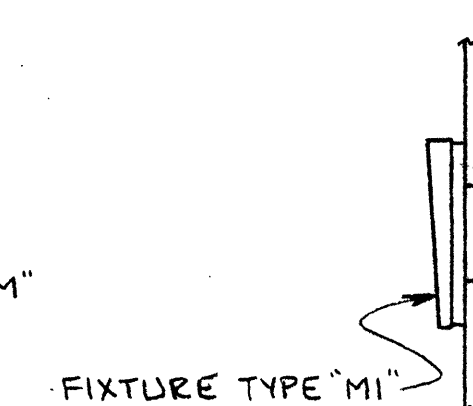


DETAIL 
SCALE: $1\frac{1}{2}'' = 1'-0''$

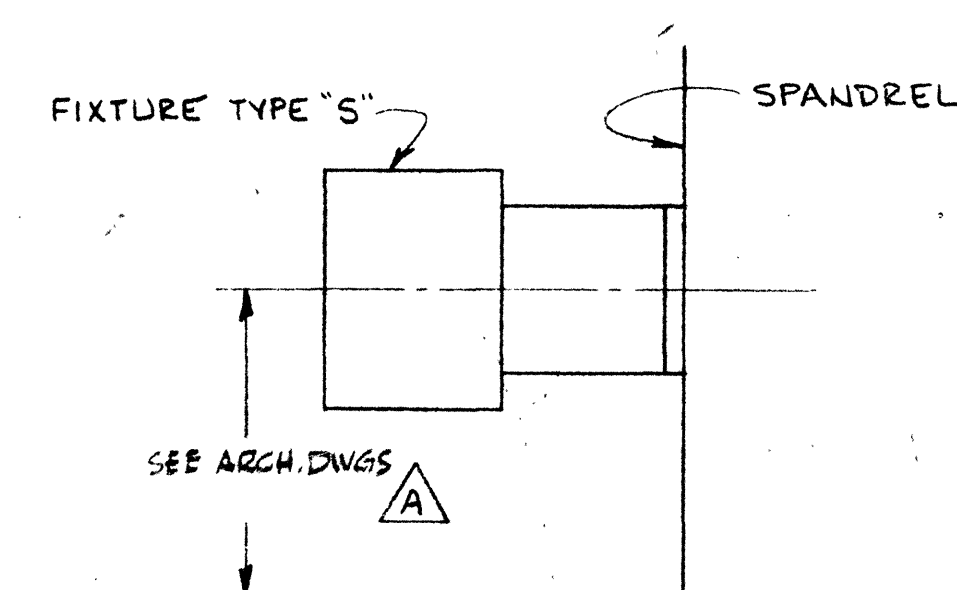

DETAIL 
SCALE: $\frac{1}{2}" = 1'-0"$

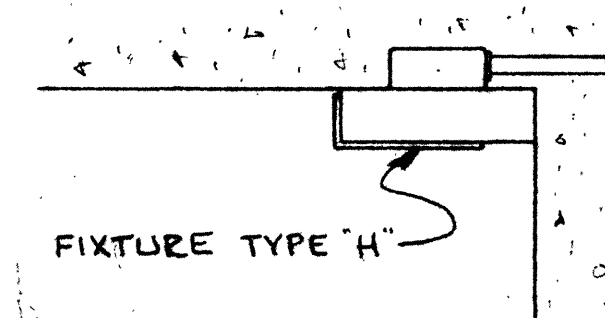

DETAIL 
SCALE: $1\frac{1}{2}'' = 1'-0''$ 

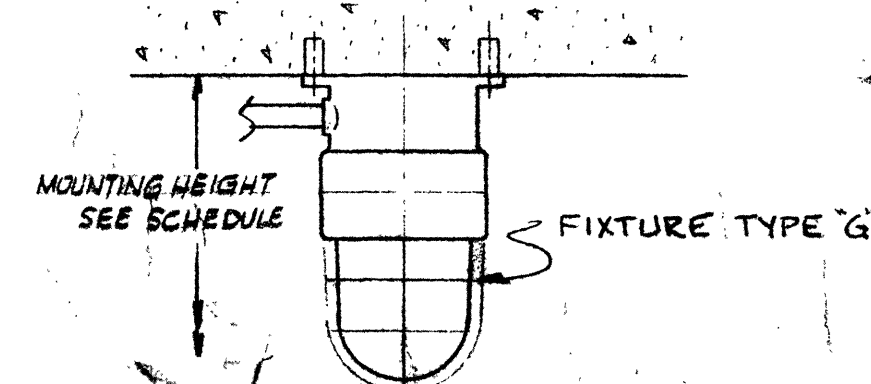

DETAIL 
SCALE: $1\frac{1}{2}'' = 1'-0''$

A	AS BUILT CORRECTIONS	11-19-68		
		RPZ		
B	1) CHG LP2 FROM MTG FLUSH-2 JH FRAME			
	2) RELOCATED RP2 & LP2 RM. 200			
B	3) REVISED COND. COUNT			
	4) RELOCATED LIGHTING FIXTURES RM. 226			
B	5) CHG. FIXTURE DESIG. FROM IN. EAST ENTRY			
	6) ADDED NOTE #4			
A	7) ADDED LIGHT IN SOUTH STAIR WELL			
	8) ADDED CORRIDORE LIGHTING SW RM 200	5-23-66	JFF	
A	SEE ADDENDUM I	GMS	WJMS	
		11-19-66	TCM	
LTR	REVISIONS	DATE	CHKD	APPD
		JRY	APPD	

IO GEV CORNELL
SYNCHROTRON LABORATORY
CORNELL UNIVERSITY
ITHACA NEW YORK

LIGHTING
BUILDING LEVEL 2
PLAN - DETAILS

WILLIAM M. BROBECK AND ASSOCIATES

IAN MACKINLAY, AIA	ARCHITECT
PREGNOFF & MATHEU	STRUCTURAL ENGR.
JACOBS ASSOCIATES	CONSTRUCTION ENGR.
950 GILMAN ST.	BERKELEY, CALIF. 94710
TELEPHONE	415 - 524 - 8664

DR.	CHK. <i>R</i>	SUPV. <i>R</i>	SCALE
RELEASED	APPROVED		AS SHOWN
<i>T.H. Elms</i>	LAB NUCLEAR STUDIES		SHEET <i>77</i> OF <i>102</i>
<i>W.B. Bickel</i>	<i>V.P. - BUSINESS</i>		DRAWING NO.
DATE <i>MAY 5 1945</i>	DATE <i>JAN 15 1946</i>		E3
18"			WMB & N. 111-5
2085-33-65-403			0/40
179 Cornell University B. & P.			27"