
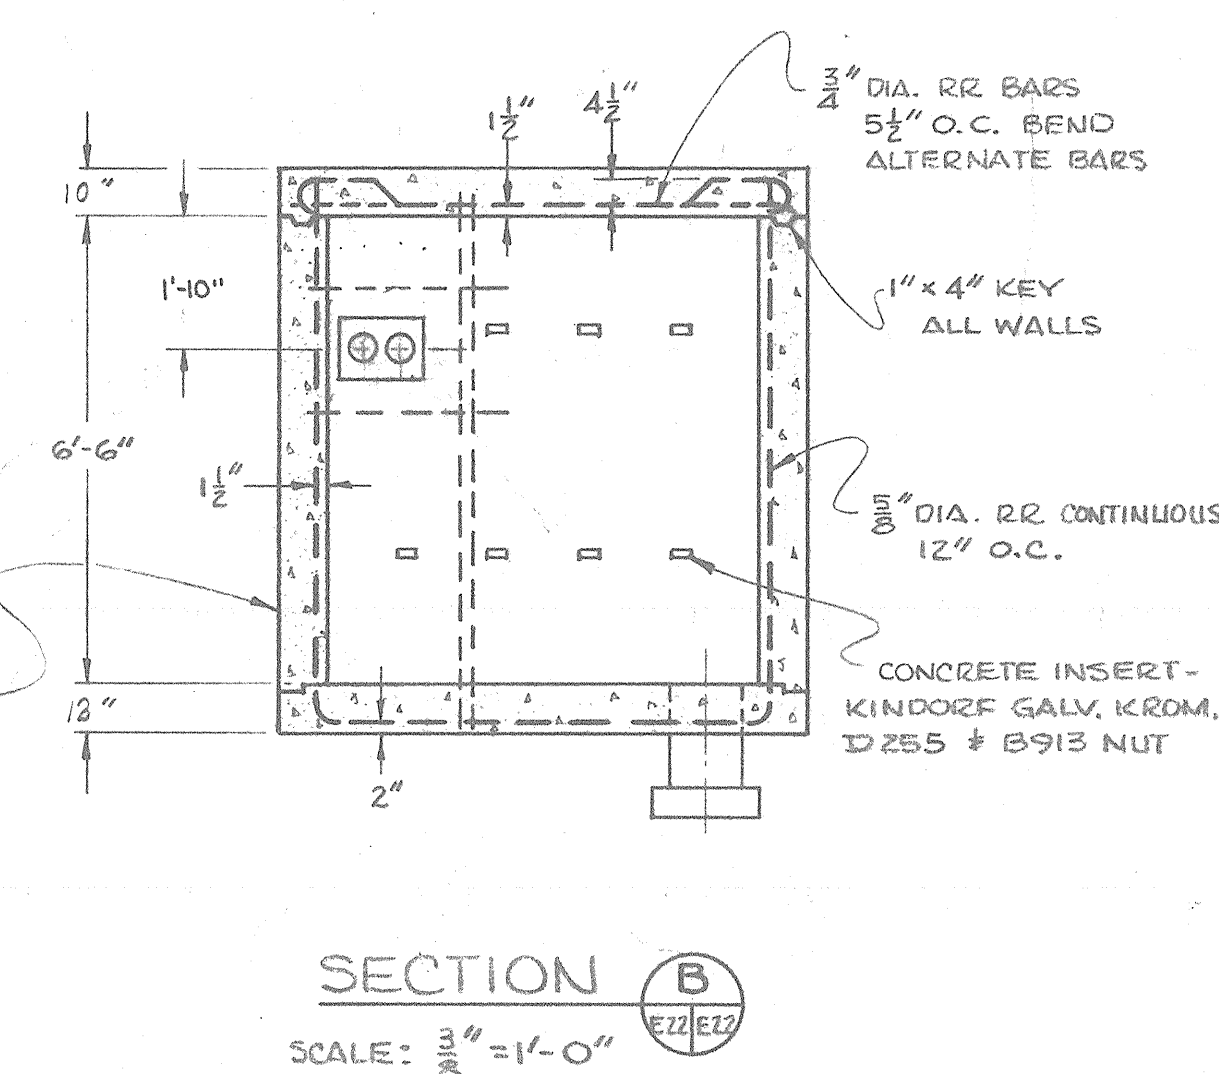
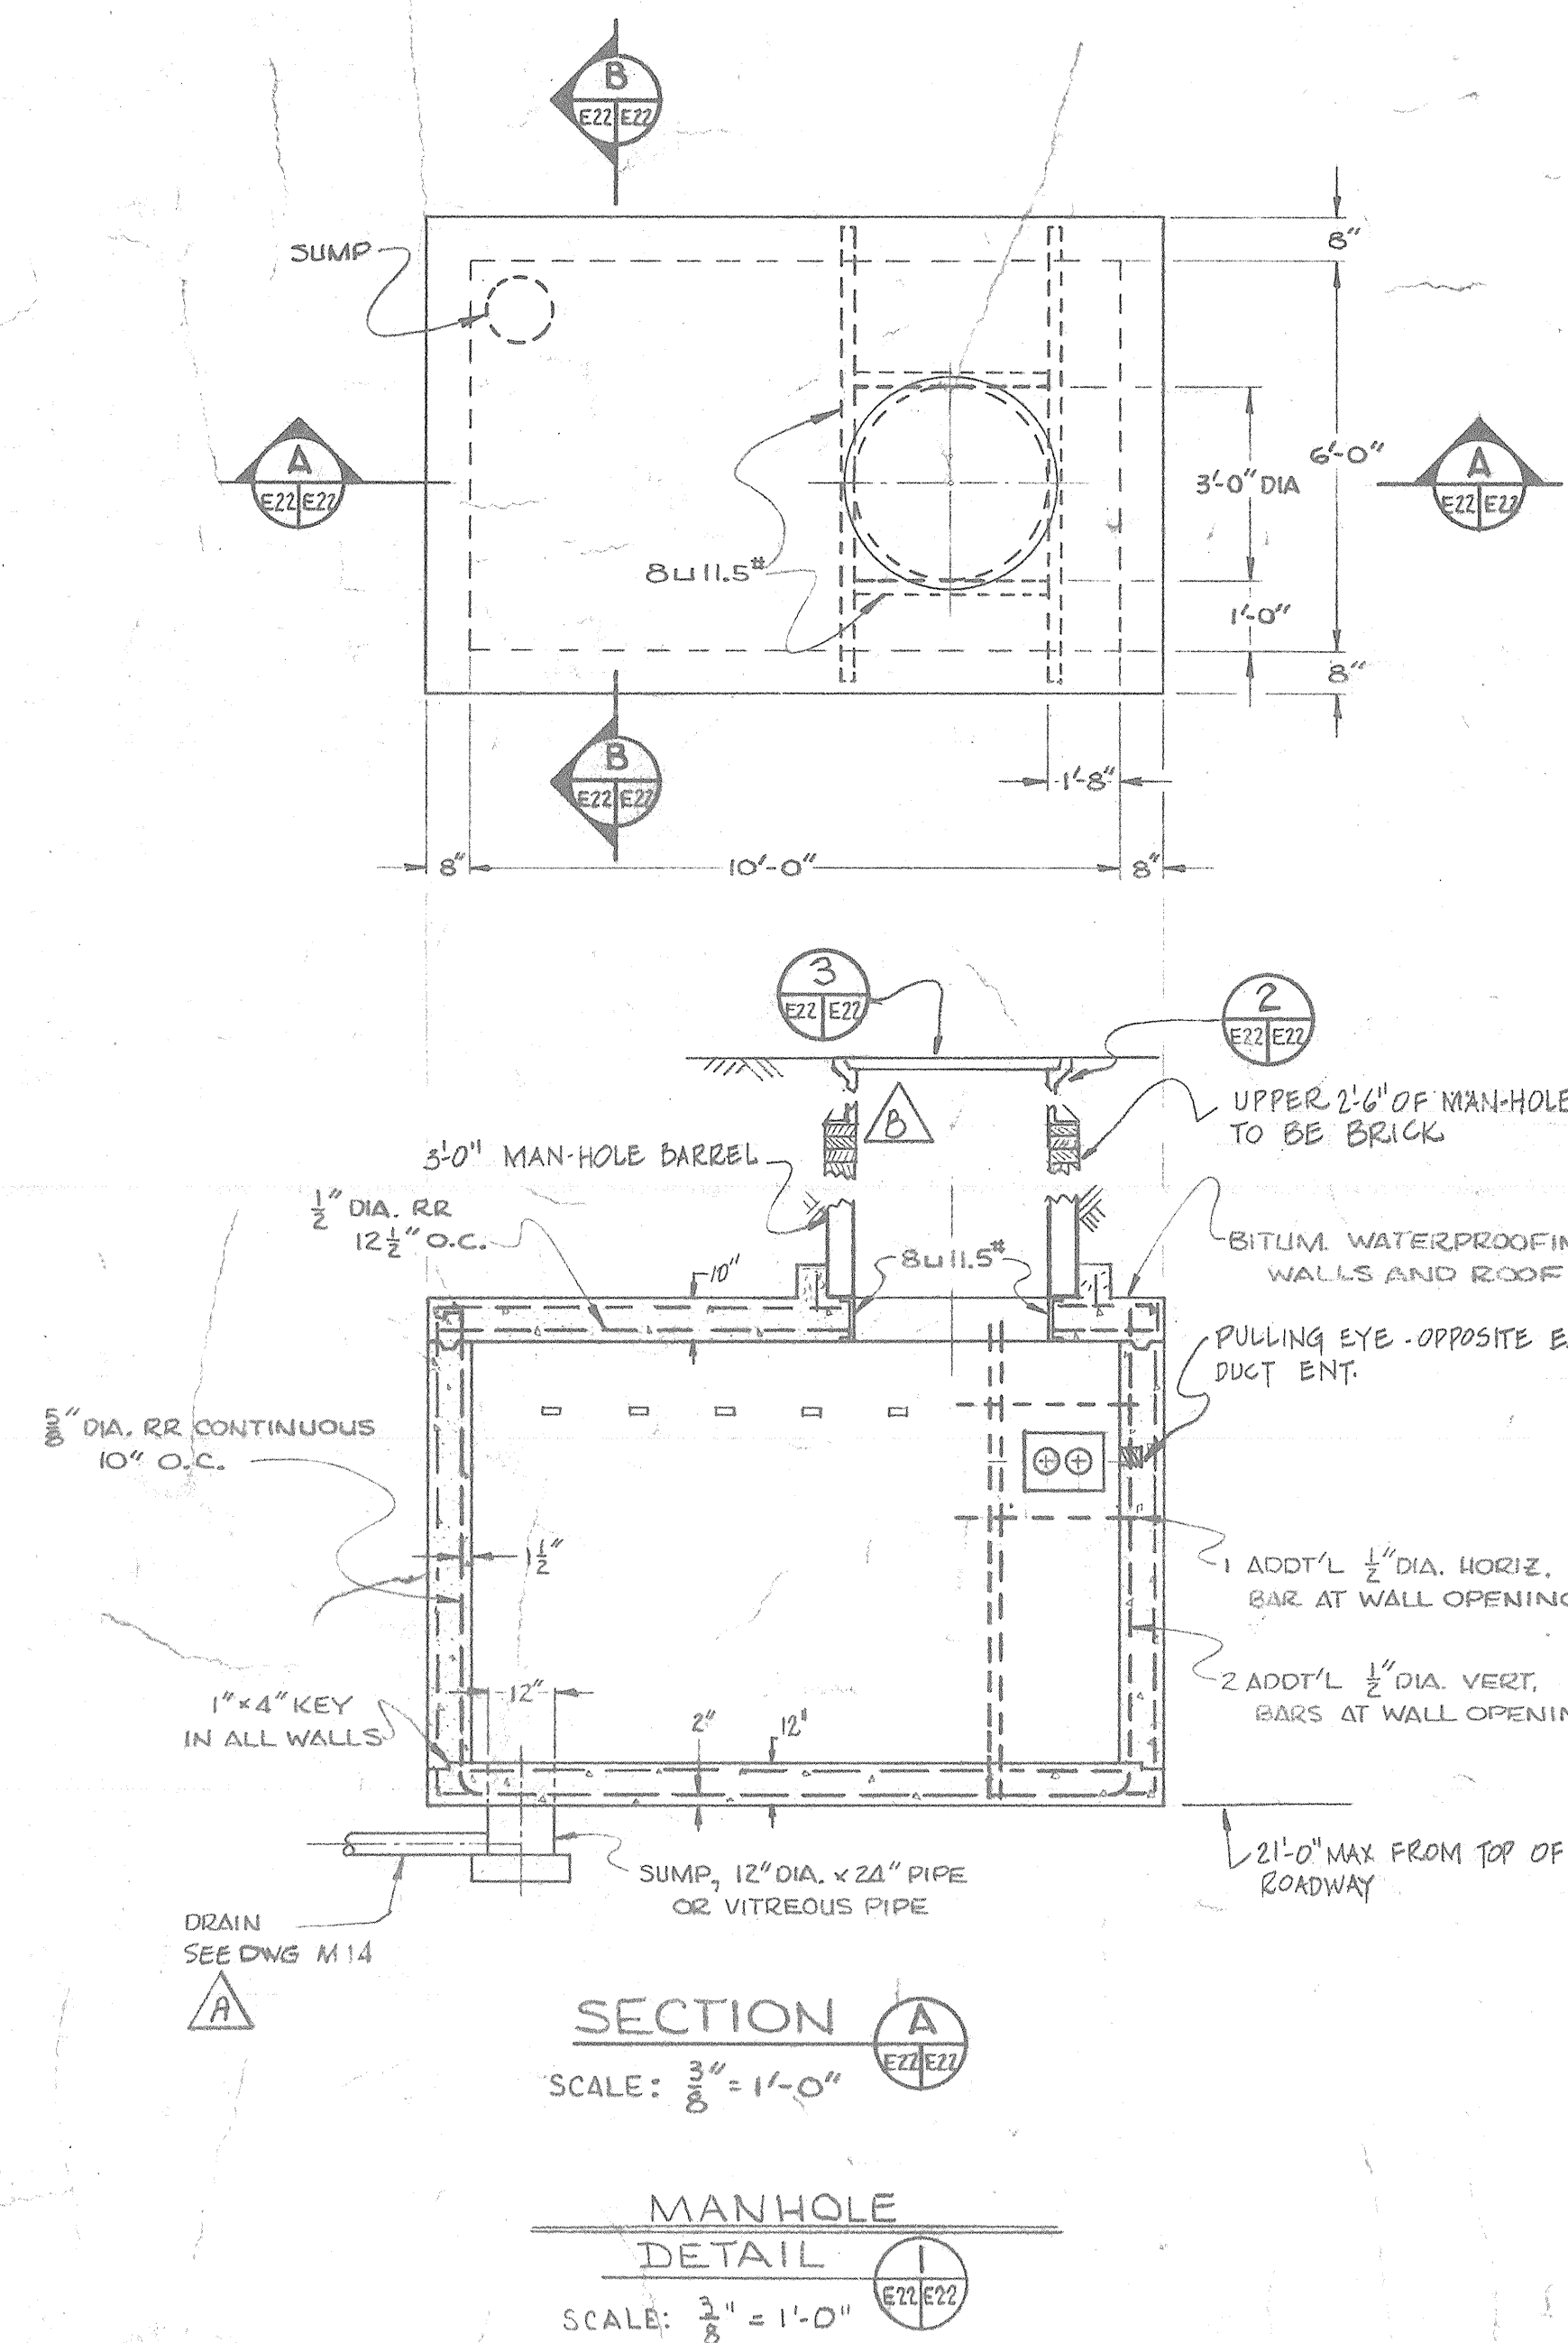
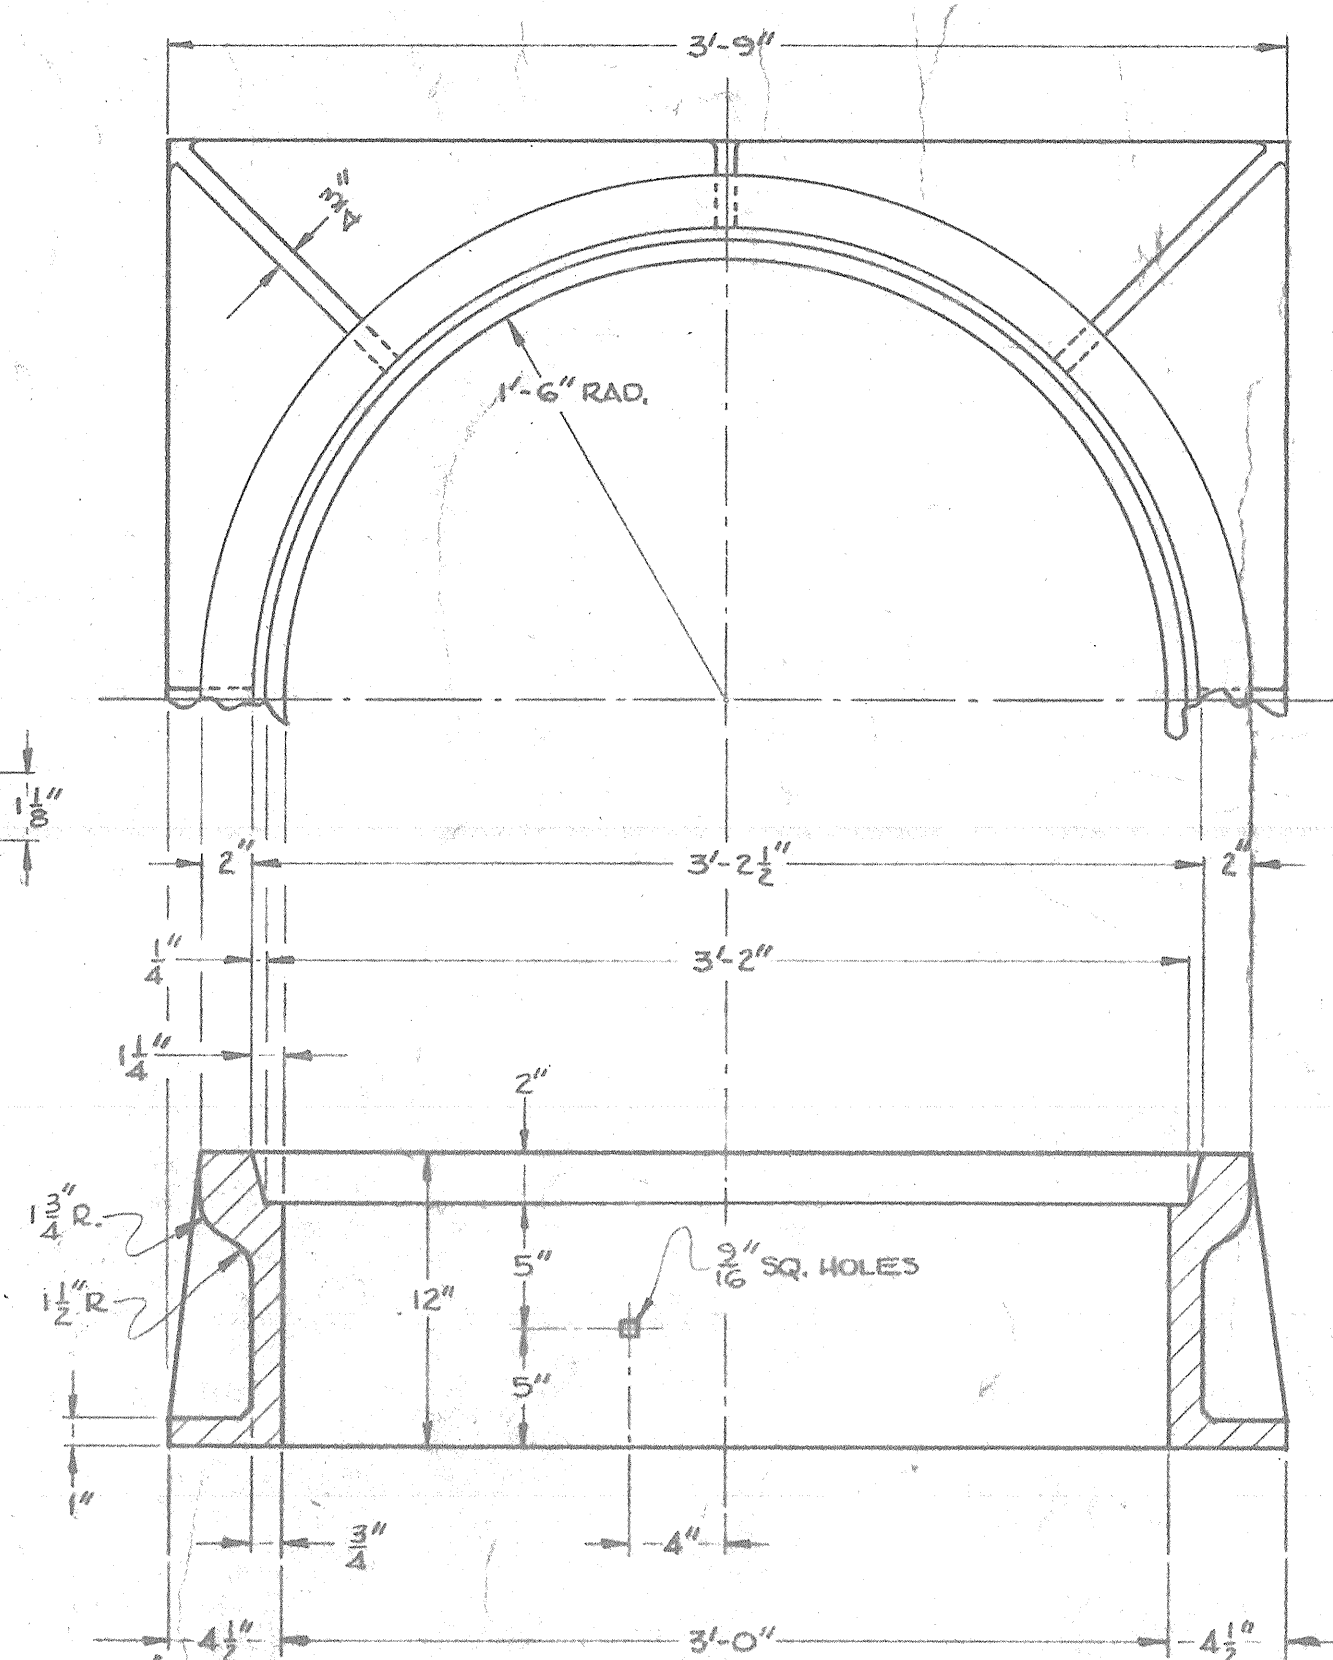
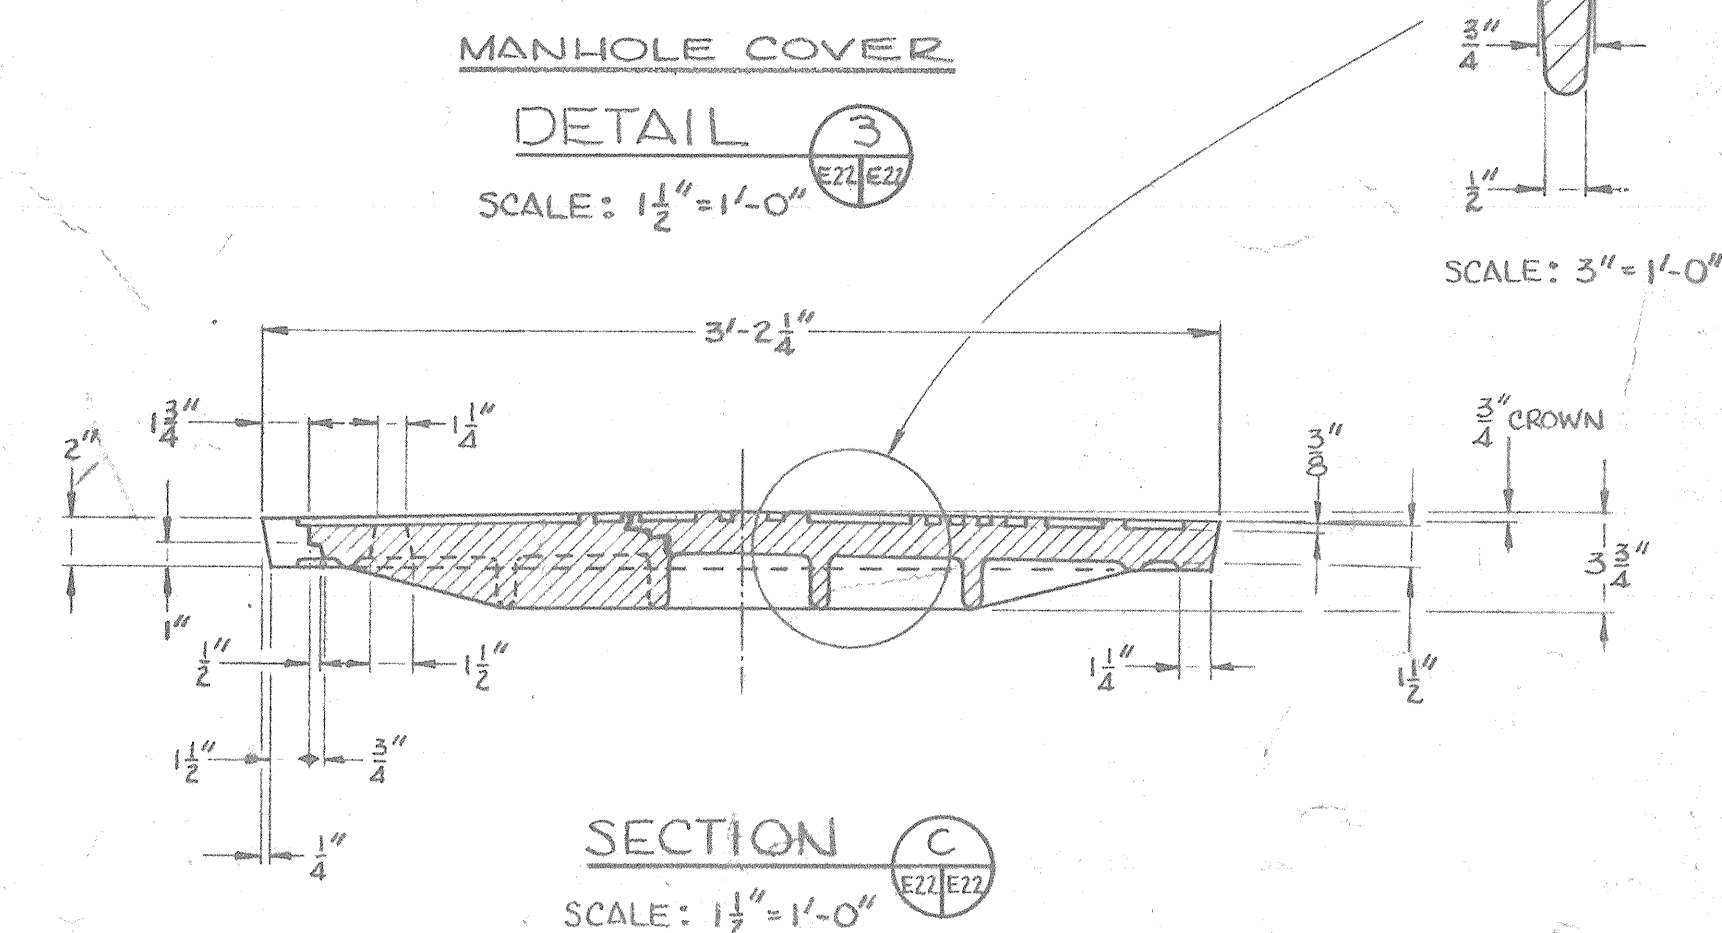
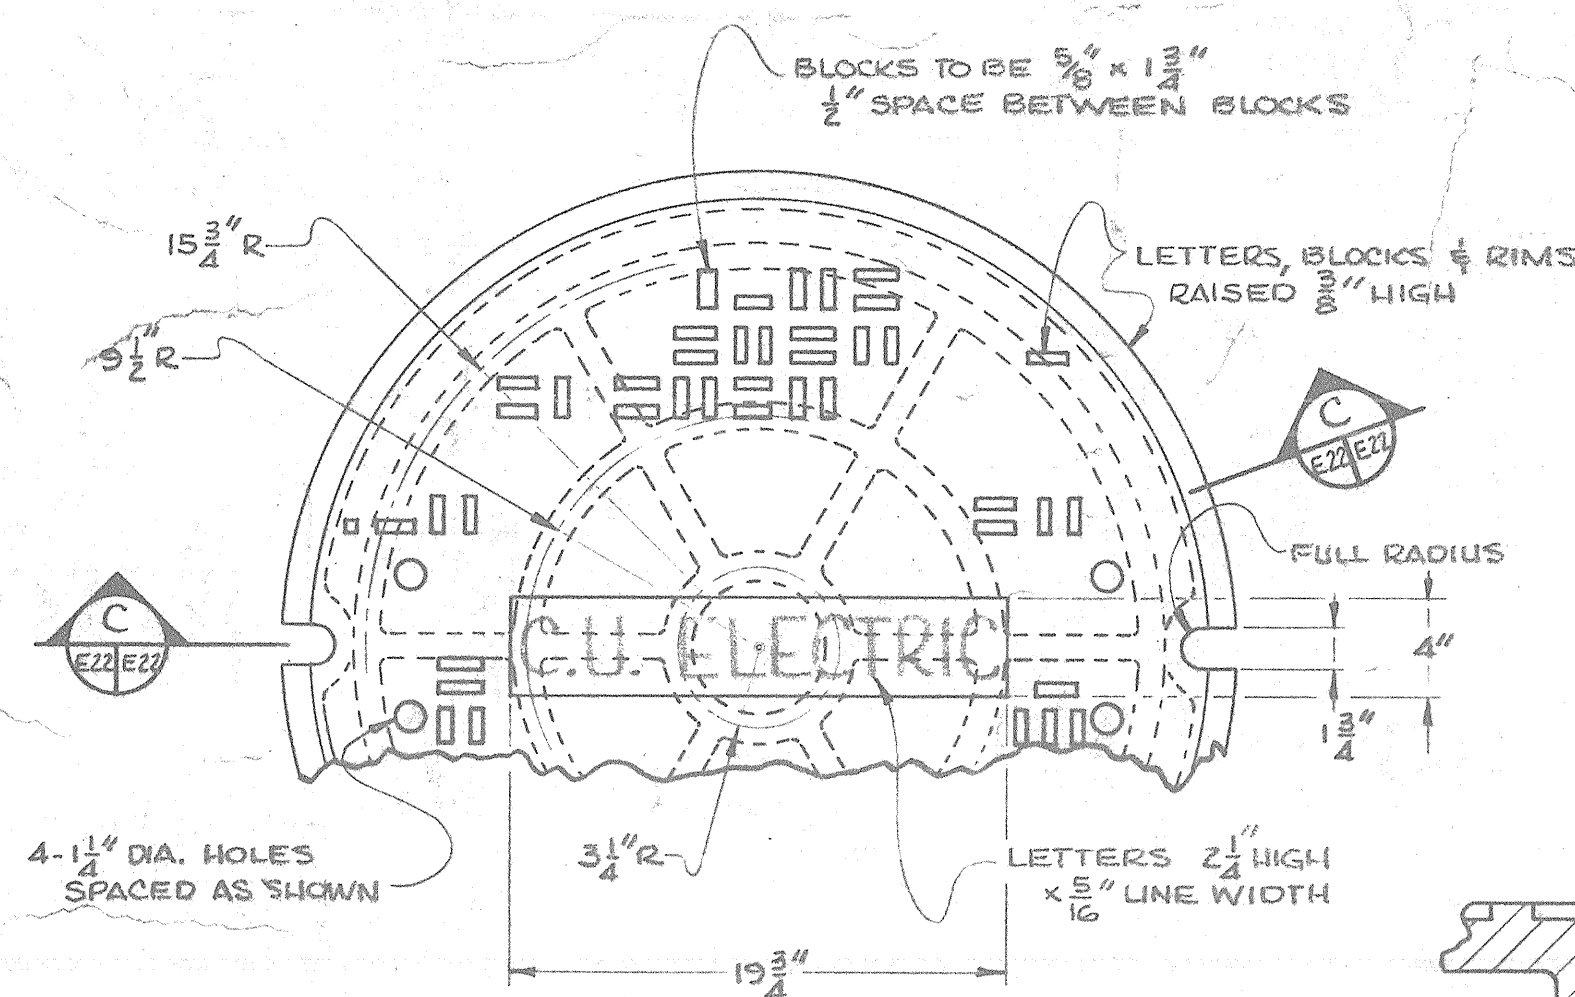


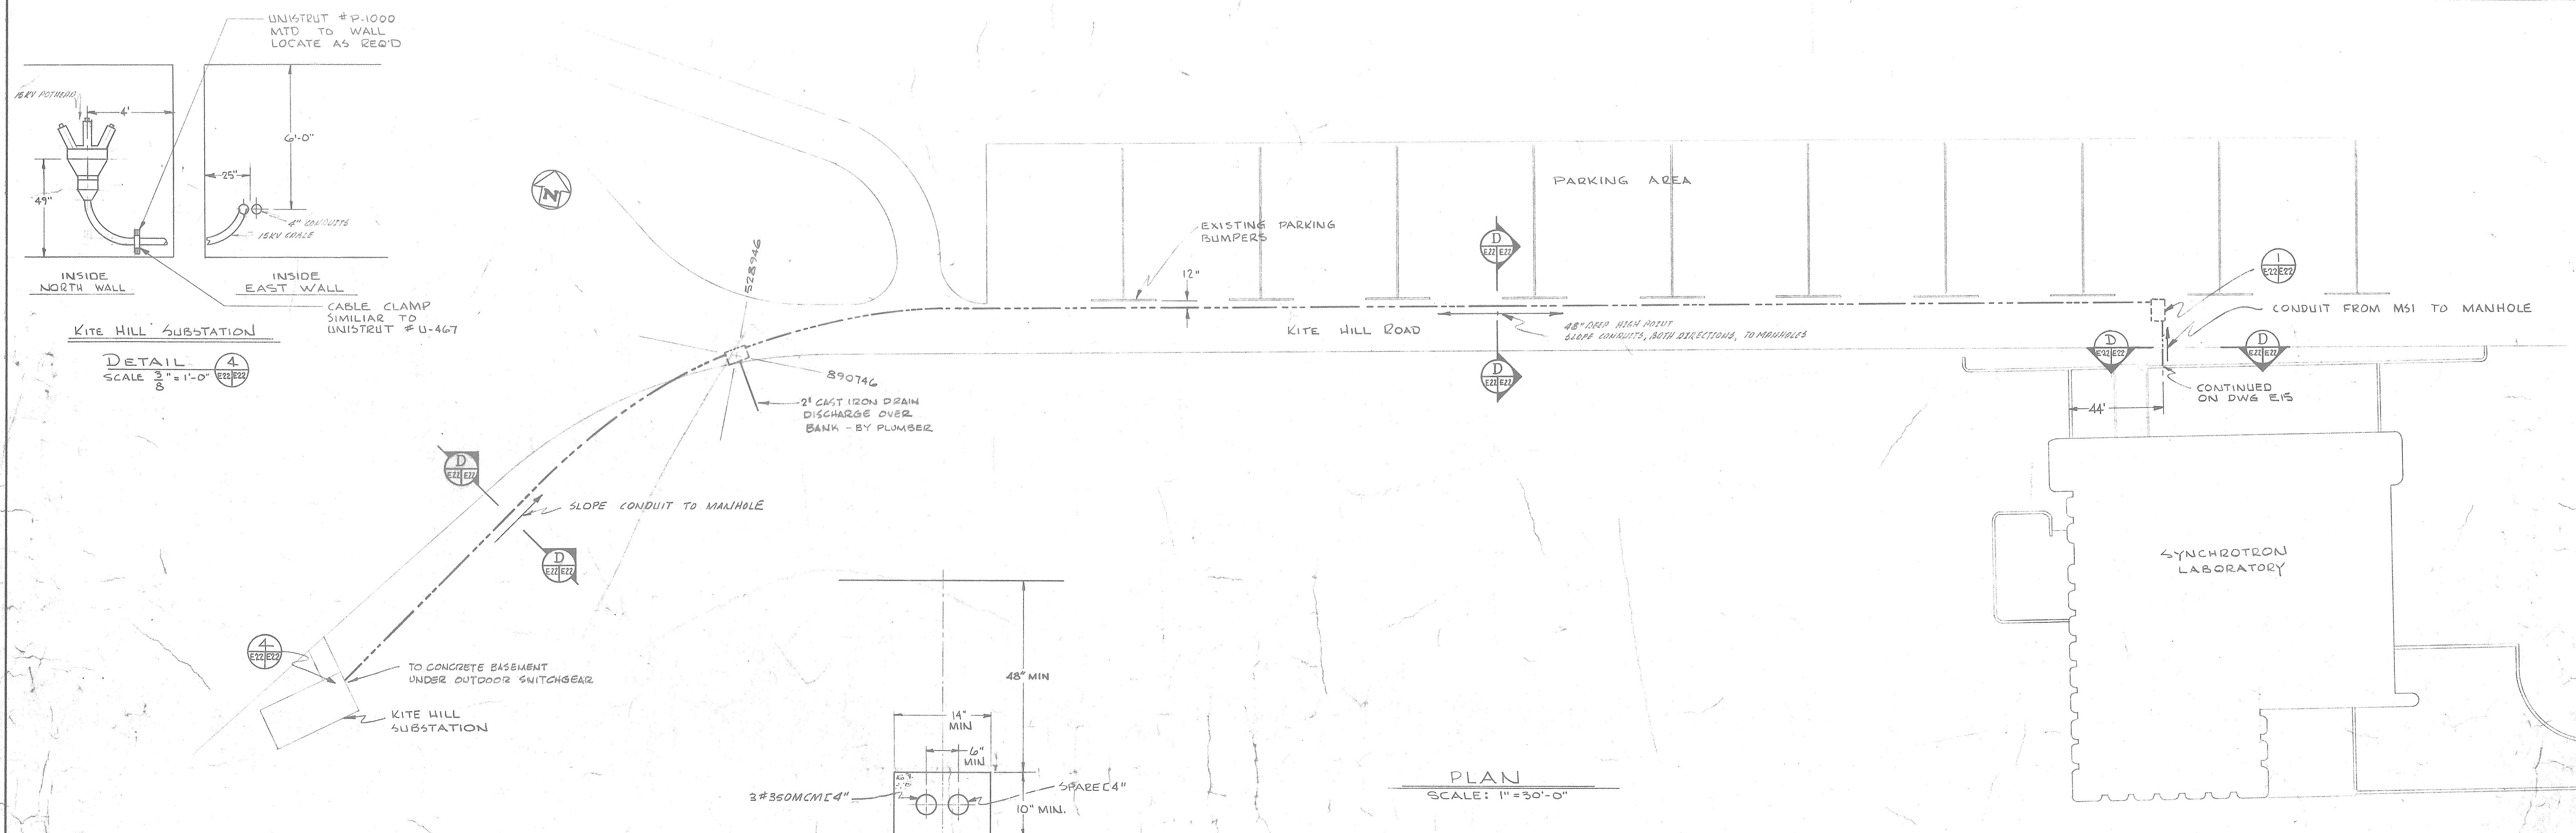

	AS BUILT CORRECTIONS	6-28-67 EDZ
	SEE ALTERNATE I	1-10-68 T.C.M. J.W.R.
LTR	REVISIONS	DATE BY
		CHD' APP'D
IO GEV CORNELL SYNCHROTRON LABORATORY CORNELL UNIVERSITY ITHACA NEW YORK		
13.6 KV UNDERGROUND SERVICE BUILDING PLAN: DETAILS		
WILLIAM M. BROBECK AND ASSOCIATES IAN MACKINLAY, AIA JACOB OFF & MATHEW GREGG ASSOCIATES 950 GILMAN ST. TELEPHONE BERKELEY, CALIF. 94710 510 - 524 - 8664		
DR. MOCHIDA	CHK. <i>R. B. ...</i>	SUPV. <i>R. B. ...</i>
RELEASED	APPROVED	SCALE AS NOTED
<i>T.H. Oline</i>	LAB NUCLEAR STUDIES	SHEET 96 OF 106
<i>W. B. ...</i> DATE NOV 15 1968	M.P. - BUSINESS <i>William M. Brobeck</i> DATE JAN 15 1969	DRAWING NO. E22 WMB & N. NO. 1114
1" =		
2085-365-65-423 044 299 Cornell University B. & P.		
1" =		