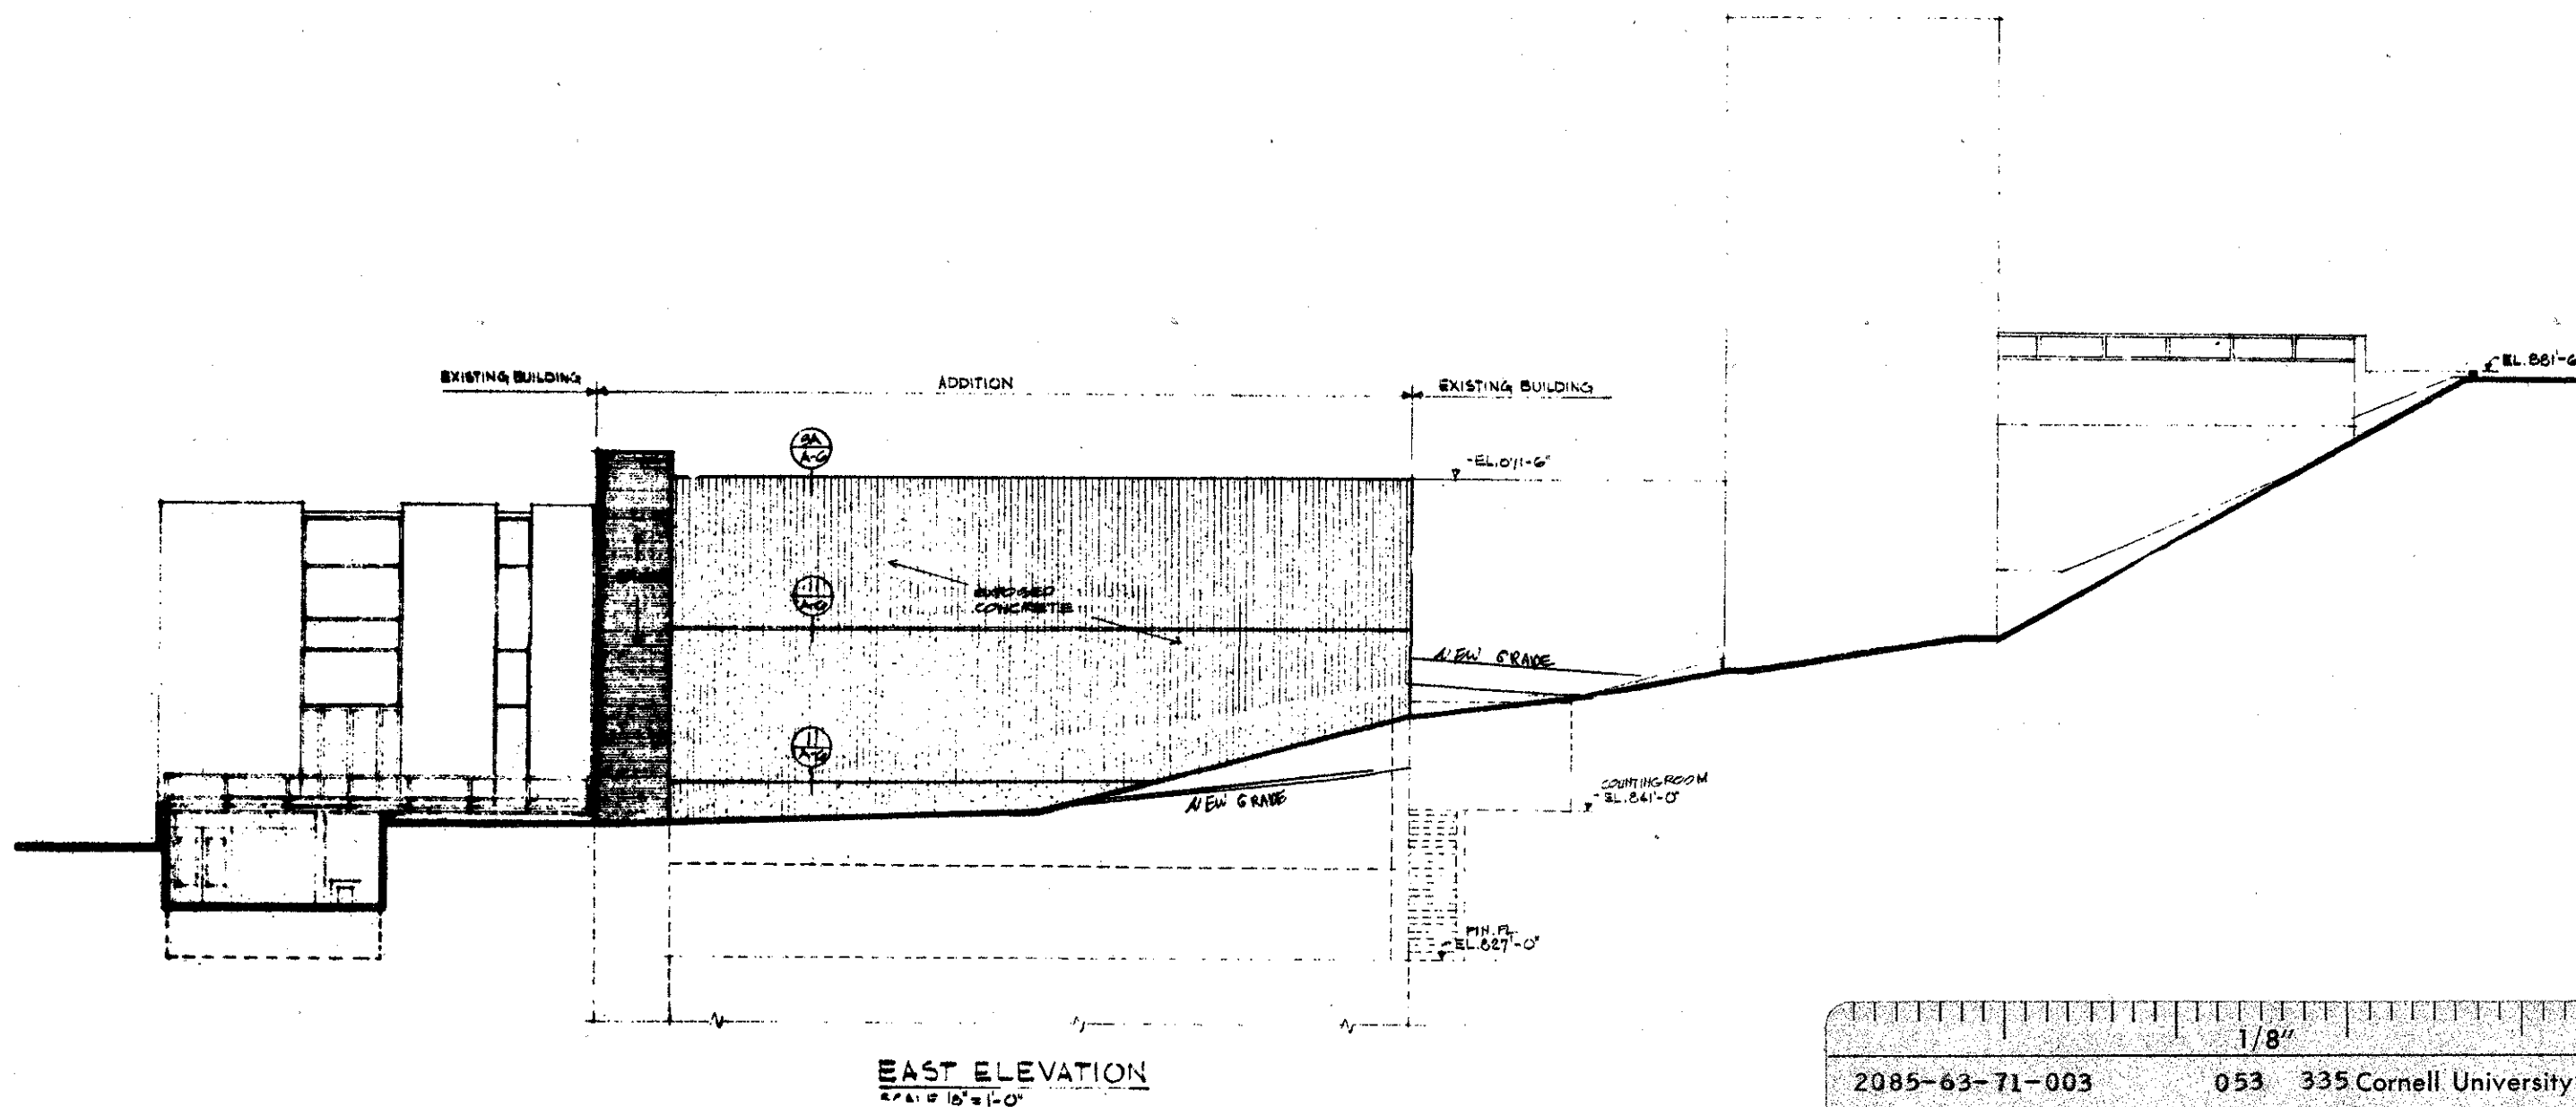
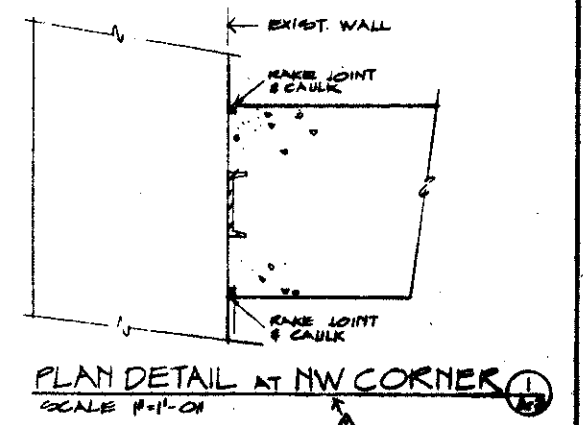
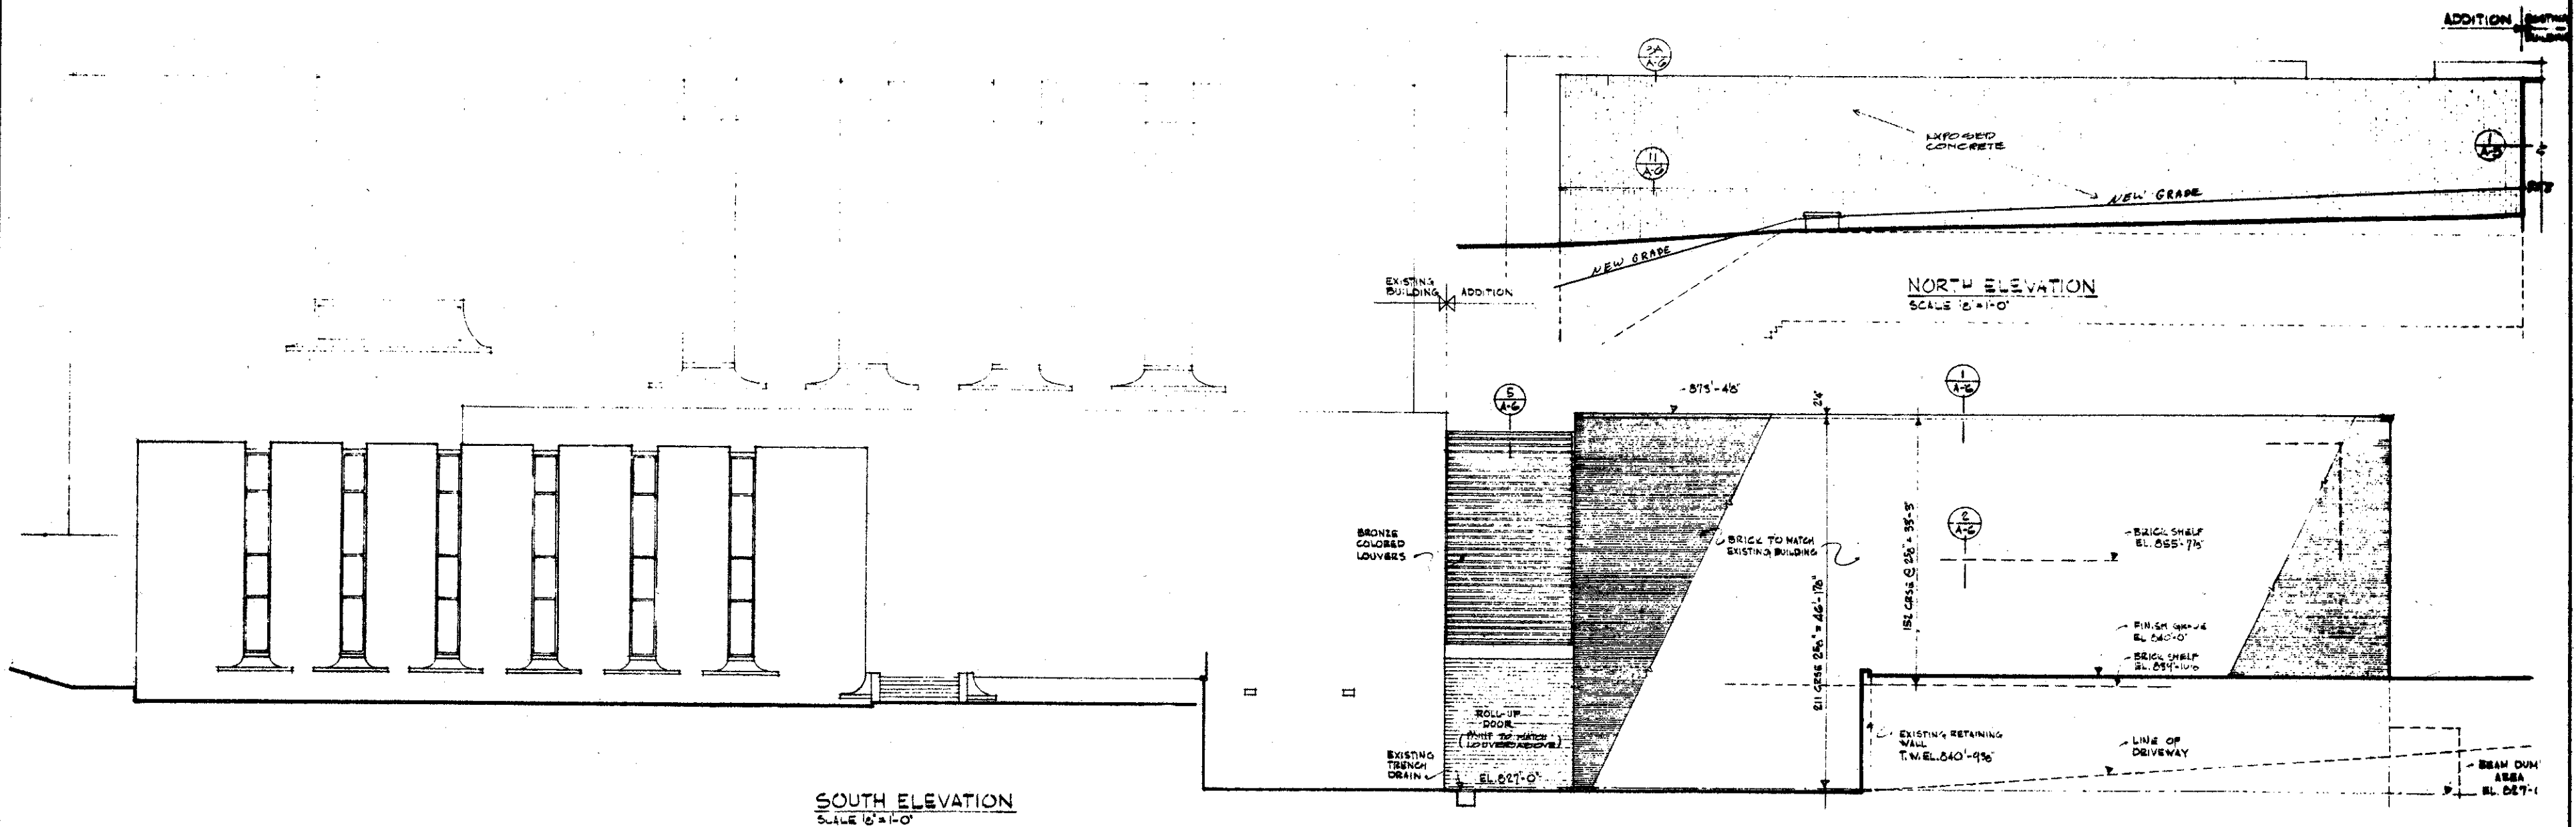


As Built
Bob Corning
A. FRIEDERICH & SONS

0-2-71	REVISION AS NOTED	
WANK ADAMS SLAYES & ASSOCIATES	ARCHITECTS & ENGINEERS	100 EAST 48 STREET NEW YORK NY 10017
10 GEY CORNELL	WILSON SYNCHRONIZATION	CORNELL UNIVERSITY TRAILWAY
ELEVATIONS		A-3