




EXISTING BUILDING ADDITION



as built
Bob Conroy
A. FRIEDRICH & SONS

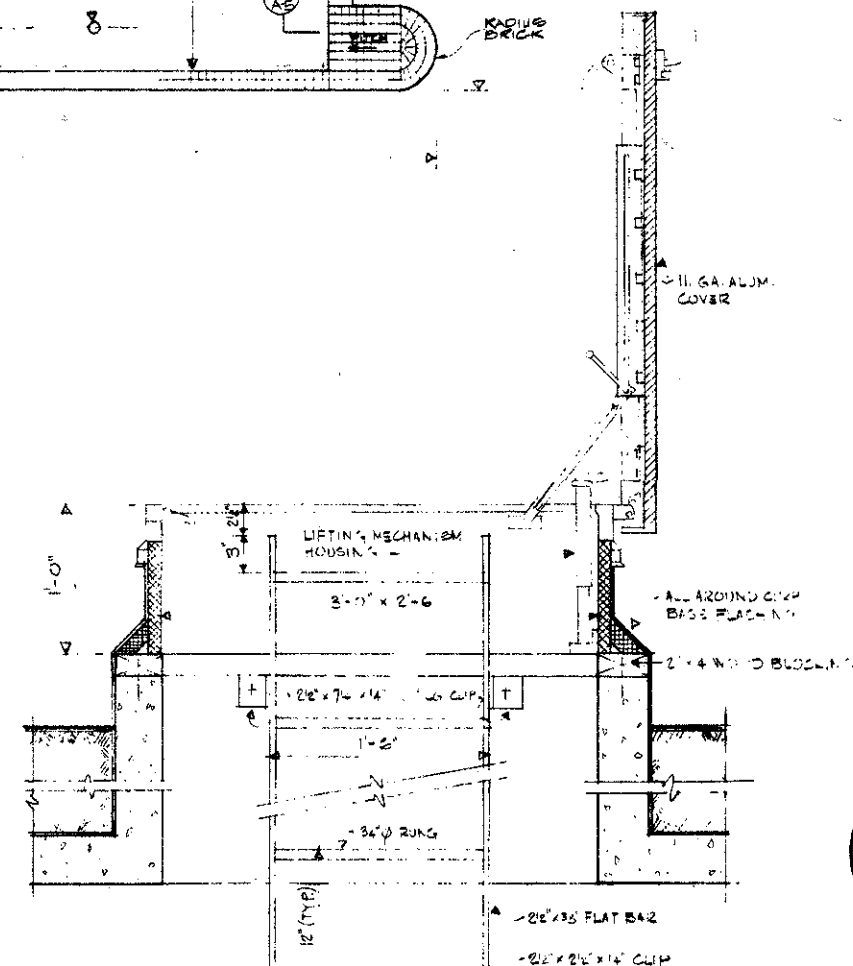

REVISIONS	5-271	REVISION AS NOTED	
	SCALE 1" = 10'-0"	DATE JULY 1, 1961	
REVISIONS	DRAWN BY L. G. B.	WANK ADAMS SLAVIN & ASSOCIATES ARCHITECTS & ENGINEERS 195 EAST 42 STREET NEW YORK NY 10017	IO GEV CORNELL WILSON SYNCHROTRON LAB. ADDITION CORNELL UNIVERSITY ITHACA N.Y.
		ROOF PLAN	