



DOI: 10.1002/for

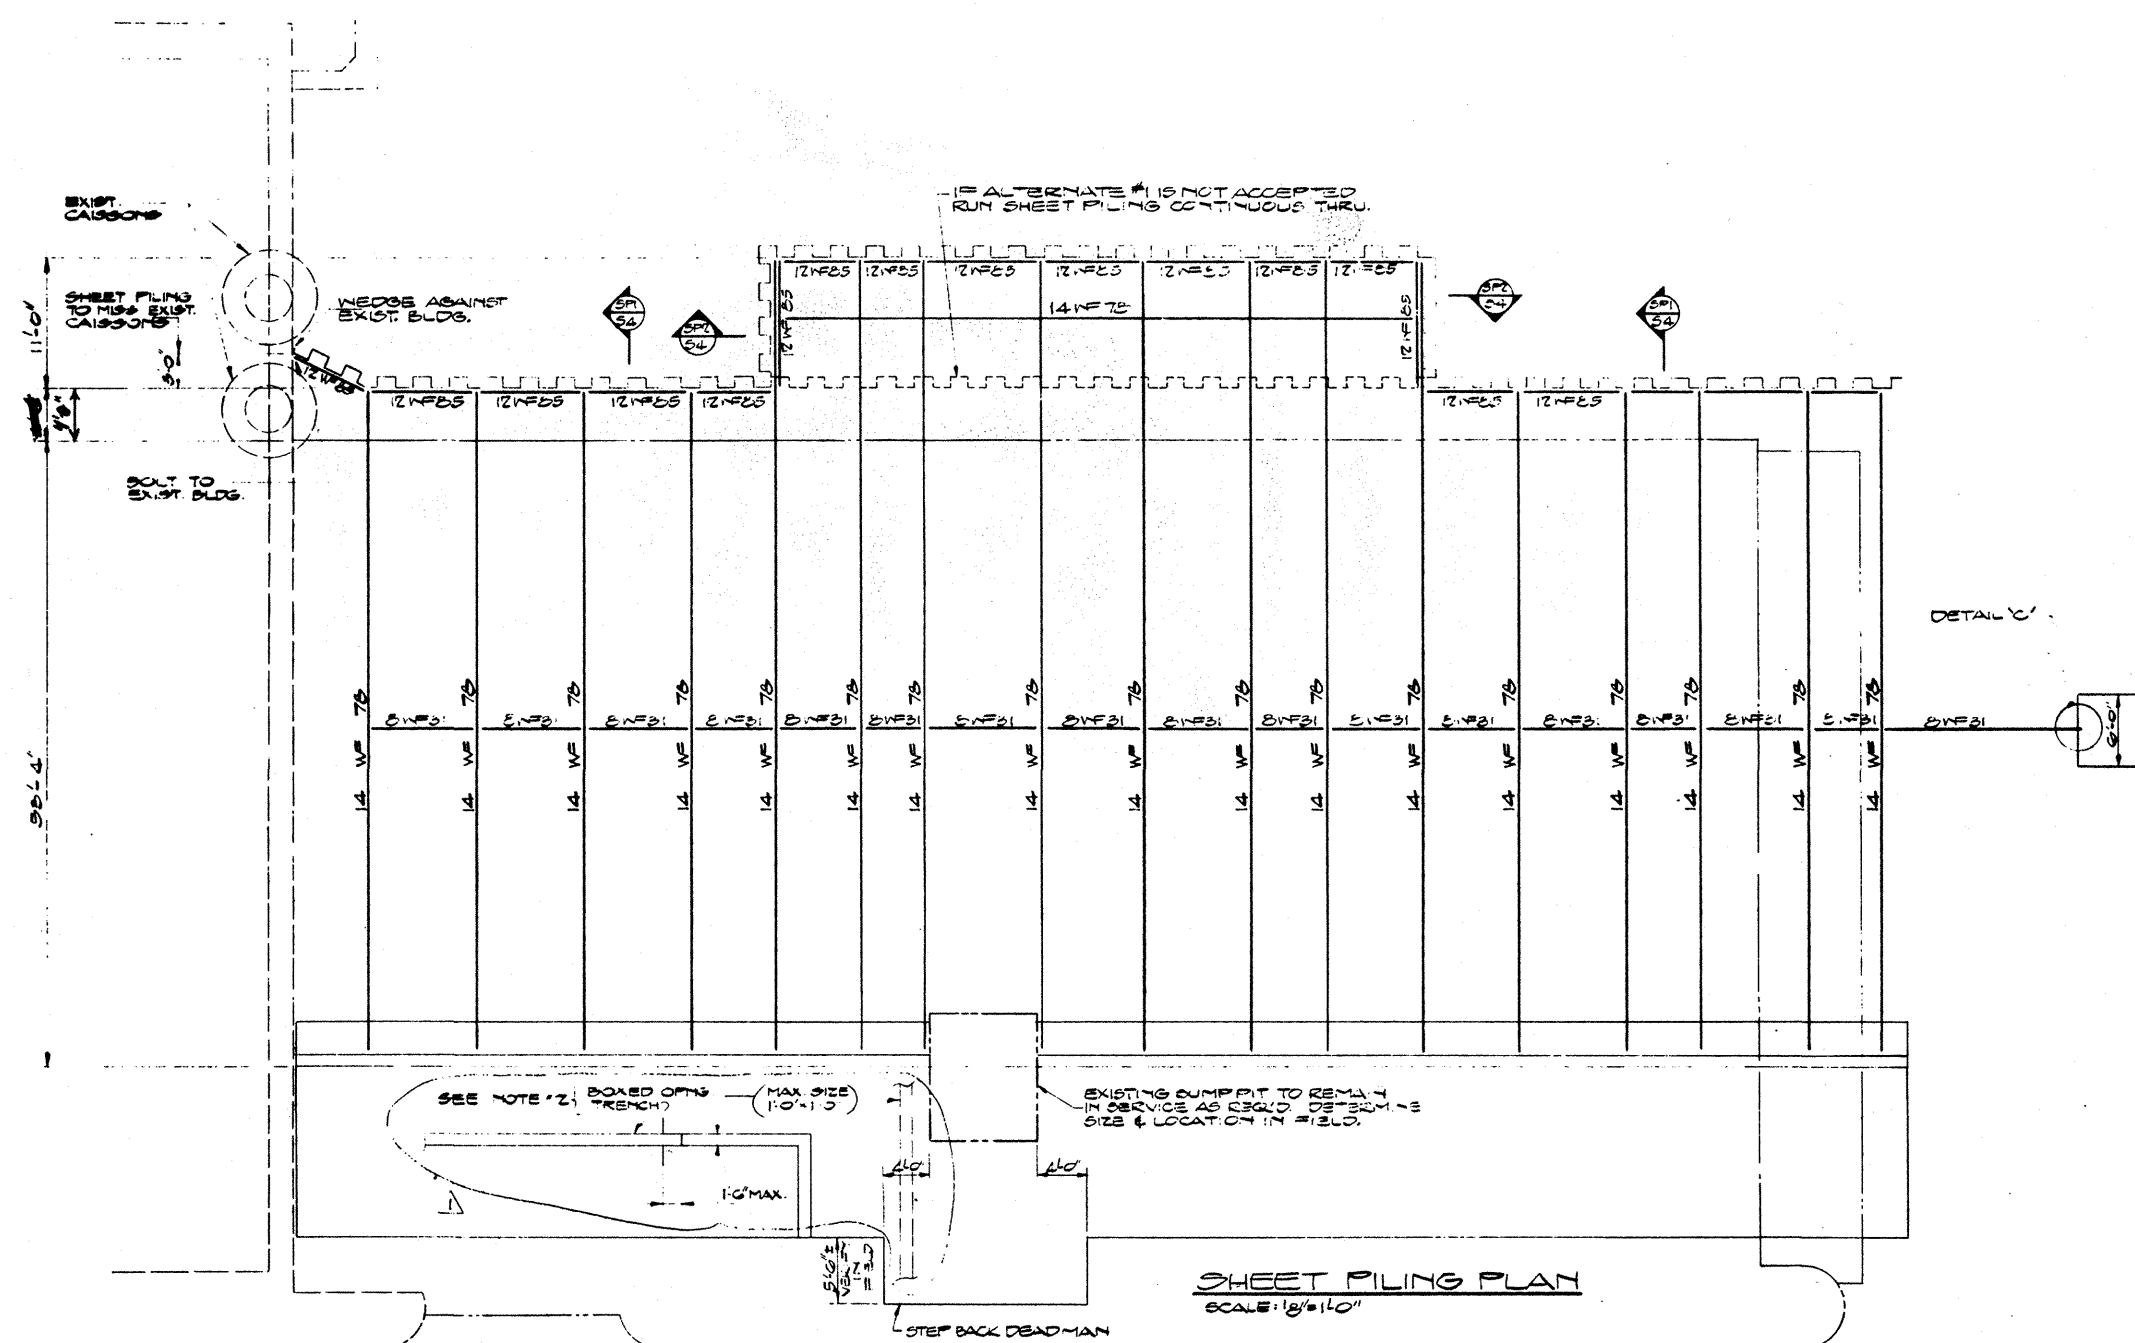


NOTE:

1. SHEET PILING BRACES (4-15) SHALL BE LOCATED SO AS TO NEWLY EXISTING BRACES, CASINGS & EXIST. SUMP PIT LOCATIONS SHOWN ON THE AREA. BRACES WILL BE VARIED IN FIELD & MAXIMUM HORIZONTAL DISTANCE BETWEEN BRACES SHALL BE 21' OF
2. PROVIDE TRENCHES AND/OR SLEEVES TO THE DEATH TO ACCOMMODATE EXIST. PROPOSED PILING LINES. SEE LOCATION OF LINES. SEE PILING OWNS, VERIFY IN FIELD.

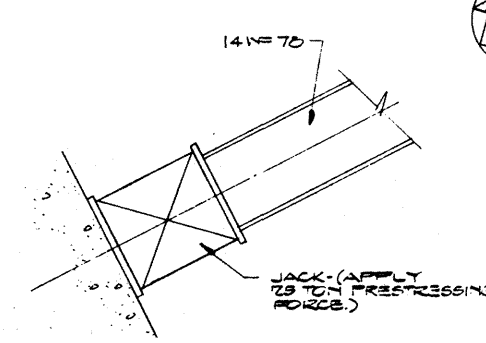


DETAIL 'A'


SCALE: $\frac{3}{4} = 1'-0"$

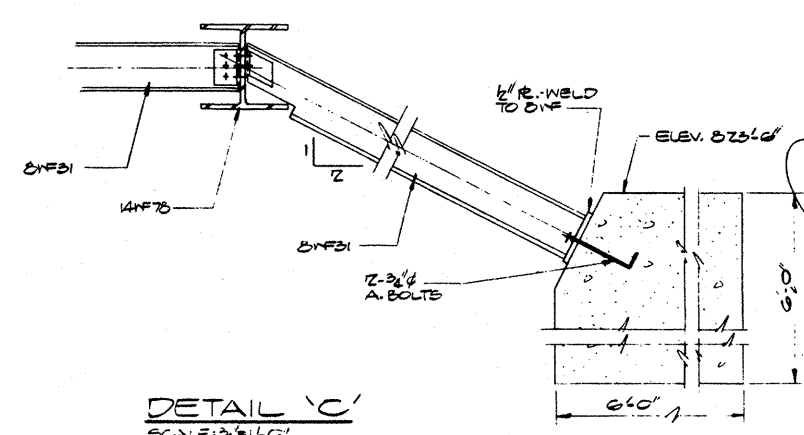


DETAIL 'C'
SCALE: $\frac{3}{4}'' = 1'-0''$

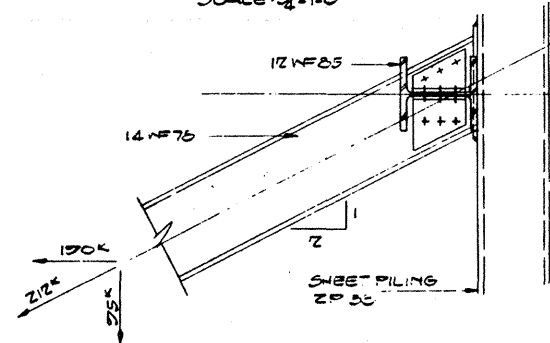


DETAIL 'B
SCALE: $\frac{1}{2}'' = 1'-0''$

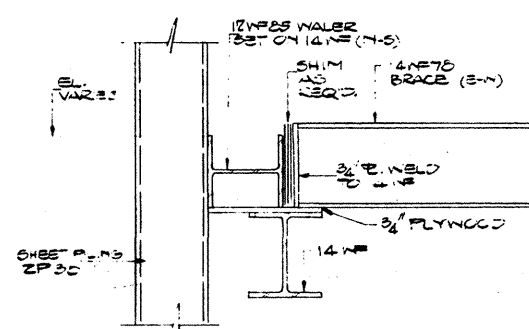

SECTION (S)
SCALE: 3/8" = 1'-0"

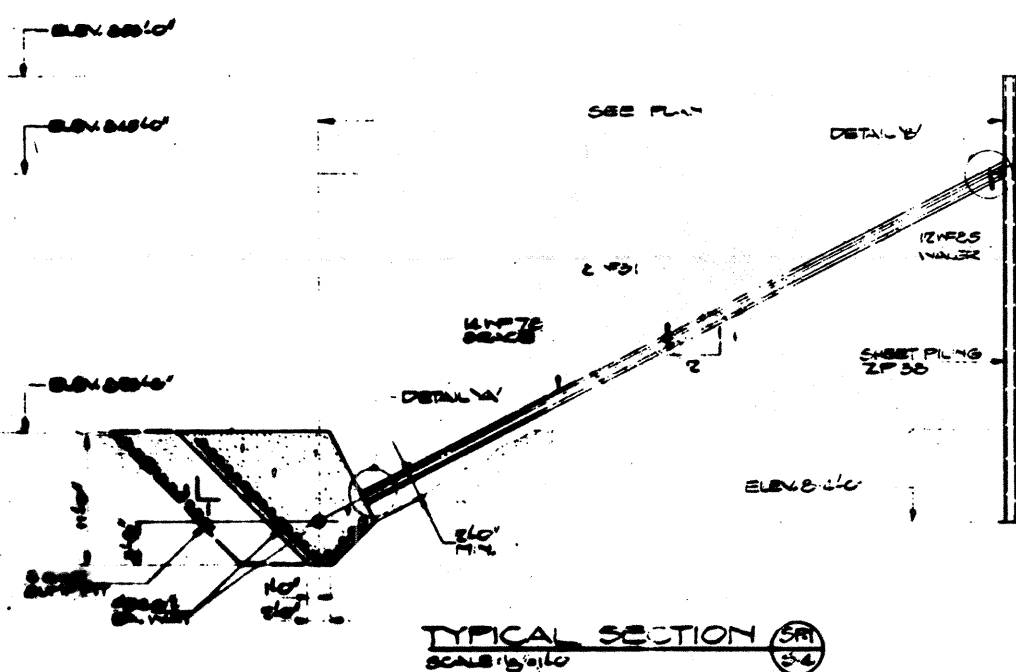

TYPICAL SECTION 5M
54

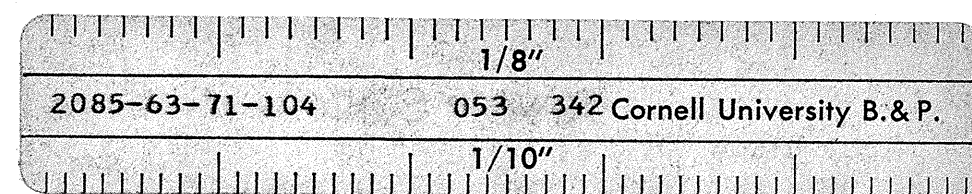

As Built
Bob Conroy
A. FRIEDERICH & SONS
Robert F. Conroy
ARCHITECTS - ENGINEERS - SURVEYORS
CONSULTING ENGINEERS
415 LEXINGTON AVENUE
NEW YORK, N.Y. 10017

NO "DOCKED"	REVISIONS	DATE	BY	NOTED	WANK ADAMS SLAVIN & ASSOCIATES ARCHITECTS INC. 200 WEST 42ND ST 150 EAST 42 STREET NEW YORK NY 10017 10 GEV CORNELL NELSON SYNCHROTRON LAB. ADDITION CORNELL UNIVERSITY ITHACA, N.Y. SHEET FILING PLAN SECTS., DETS. & NOTES
1/12/71	NO "DOCKED"	1/12/71	NO "DOCKED"	NO "DOCKED"	34