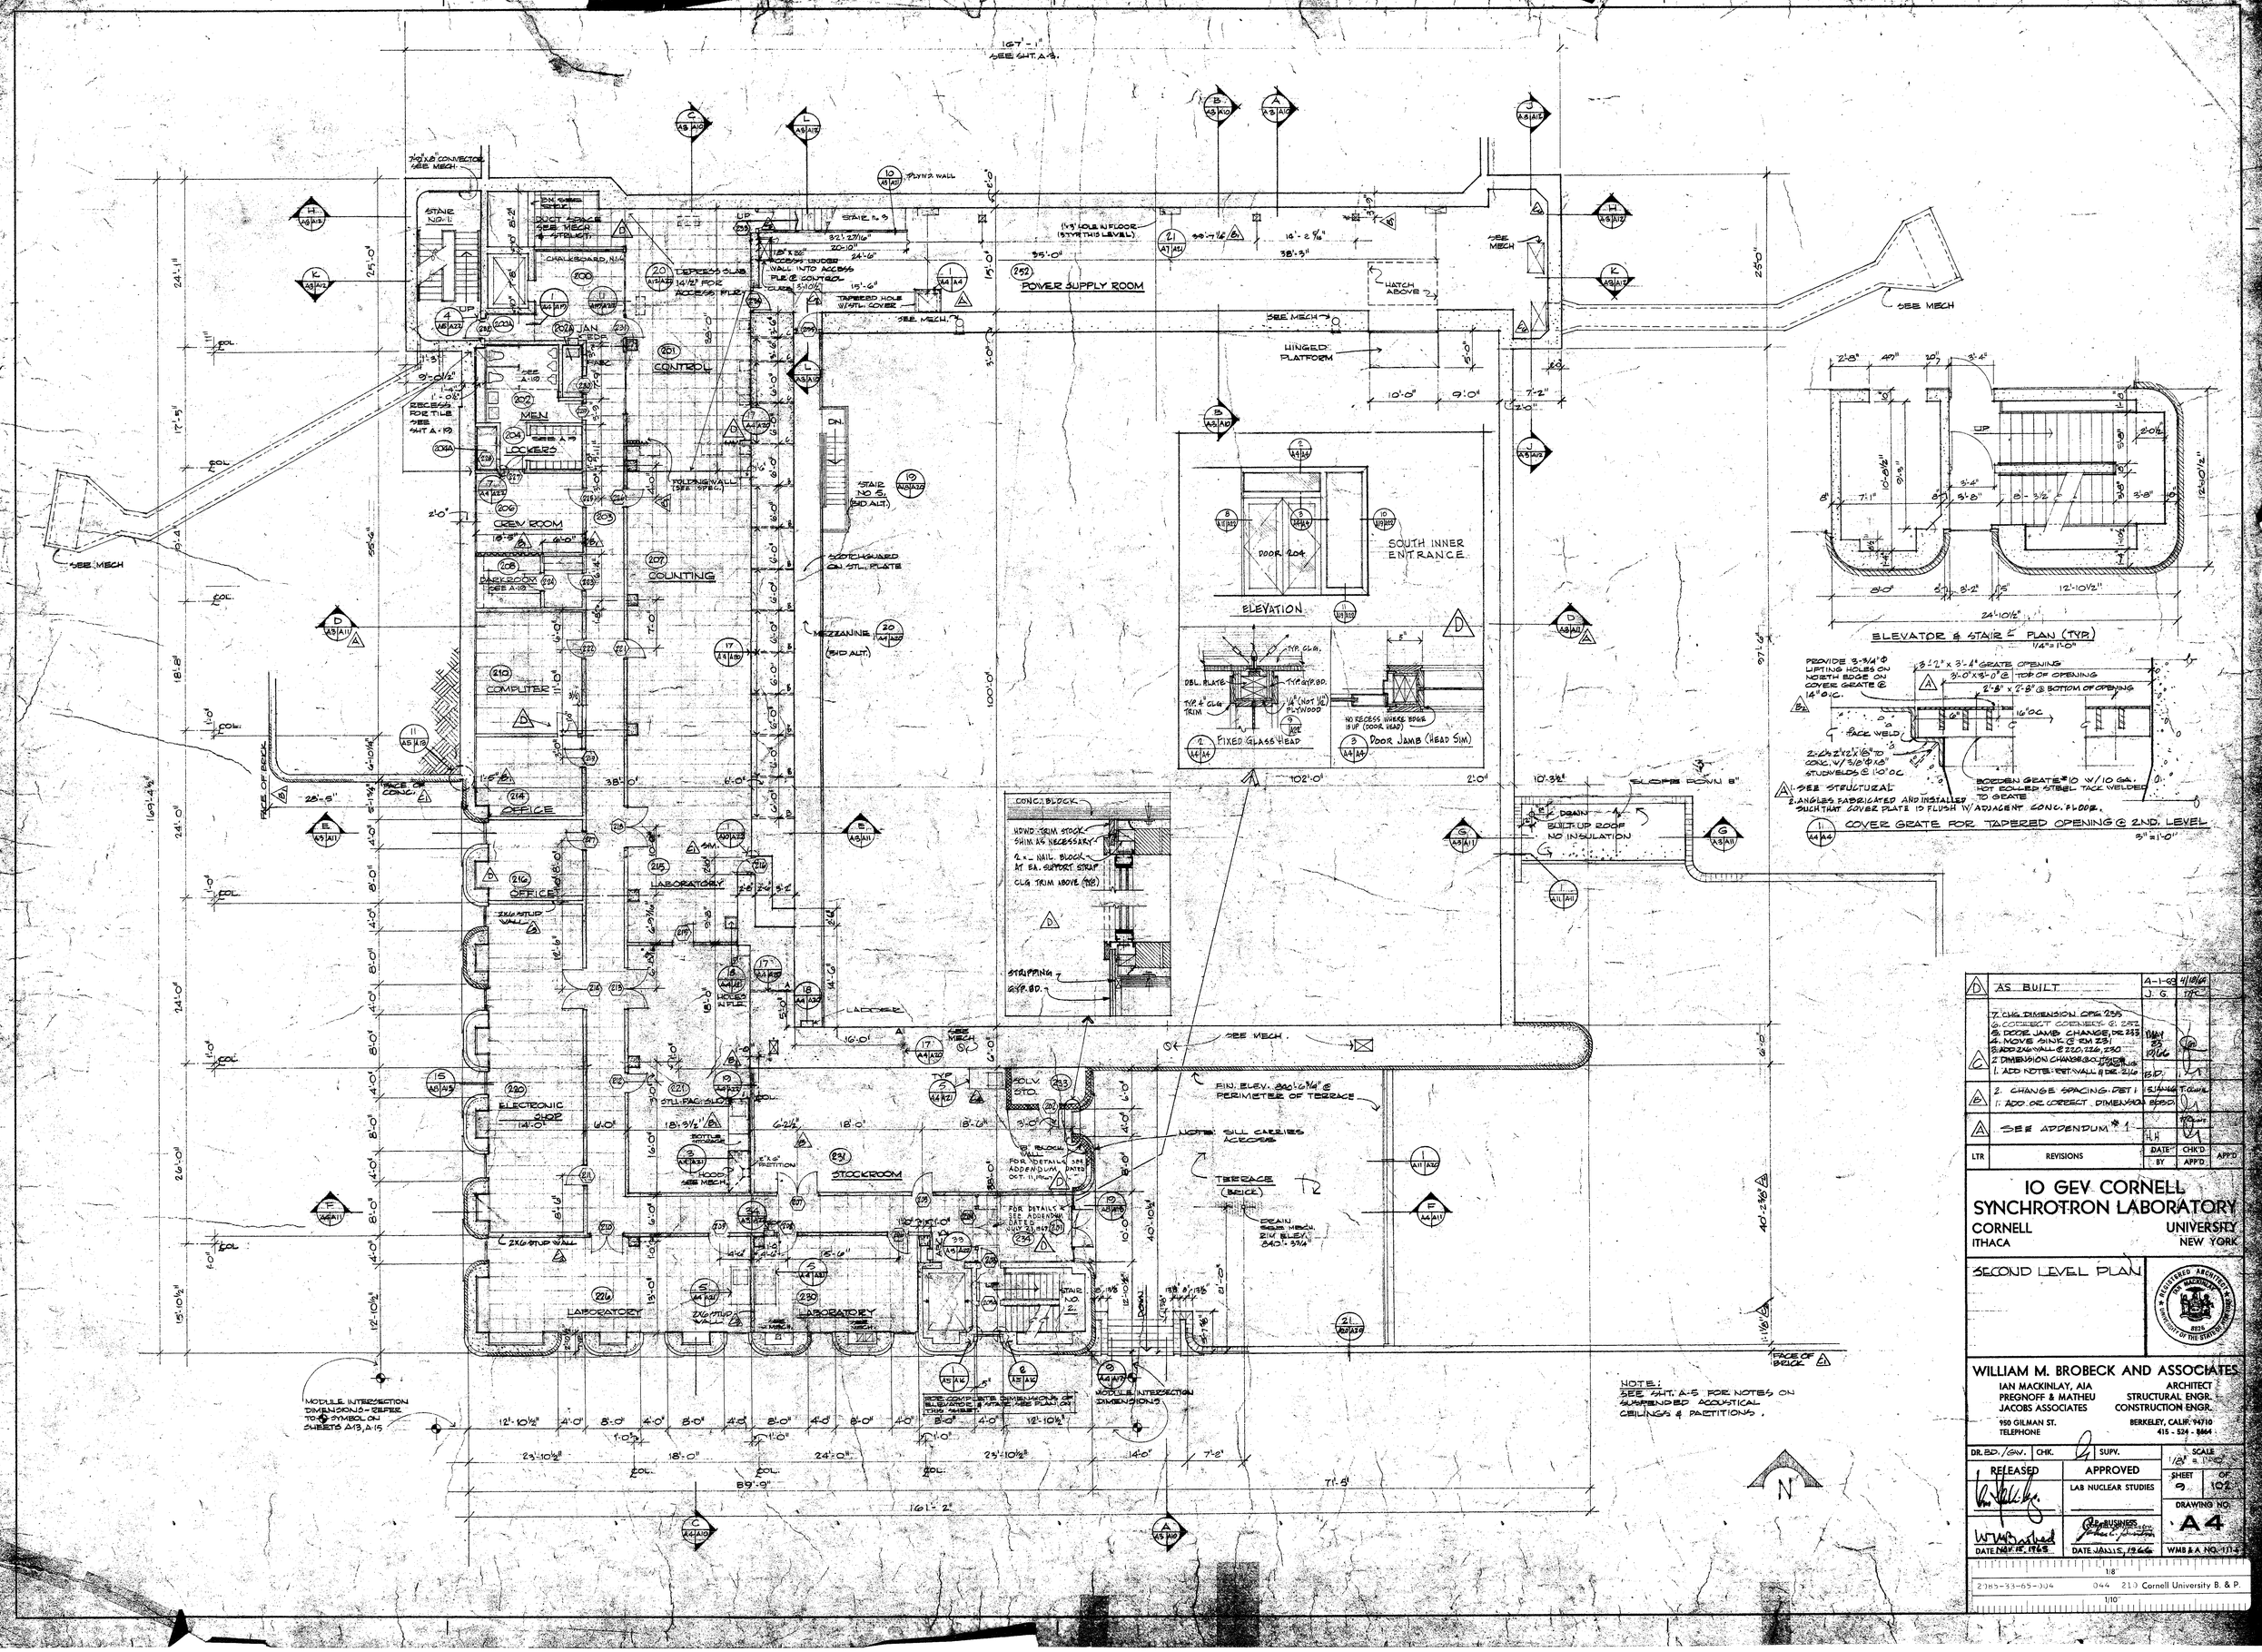
POWER SUPPLY ROOM
CONTROL
MEN
LOCKERS
CREW ROOM
COUNTING
COMPUTER
OFFICE
LABORATORY
ELECTRONIC SHOP
STOCKROOM
SOUTH INNER ENTRANCE
ELEVATOR & STAIR PLAN (TYP)
COVER GRATE FOR TAPERED OPENING @ 2ND. LEVEL
ELEVATION
FIXED GLASS HEAD
DOOR JAMB (HEAD SIM)
HINGED PLATFORM
BUILT-UP ROOF NO INSULATION
SEE MECH
NOTE:
SEE SHT. A-5 FOR NOTES ON SUSPENDED ACOUSTICAL CEILINGS & PARTITIONS.
AS BUILT
SEE ADDENDUM #1
10 GEV CORNELL SYNCHROTRON LABORATORY
CORNELL UNIVERSITY
ITHACA NEW YORK
SECOND LEVEL PLAN
WILLIAM M. BROBECK AND ASSOCIATES
IAN MACKINLAY, AIA ARCHITECT
PREGNOFF & MATHEU STRUCTURAL ENGR.
JACOBS ASSOCIATES CONSTRUCTION ENGR.
950 GILMAN ST. BERKELEY, CALIF. 94710
TELEPHONE 415 - 524 - 8864
RELEASED
APPROVED
LAB NUCLEAR STUDIES
DRAWING NO. A4
2085-33-65-304 044 210 Cornell University B. & P.