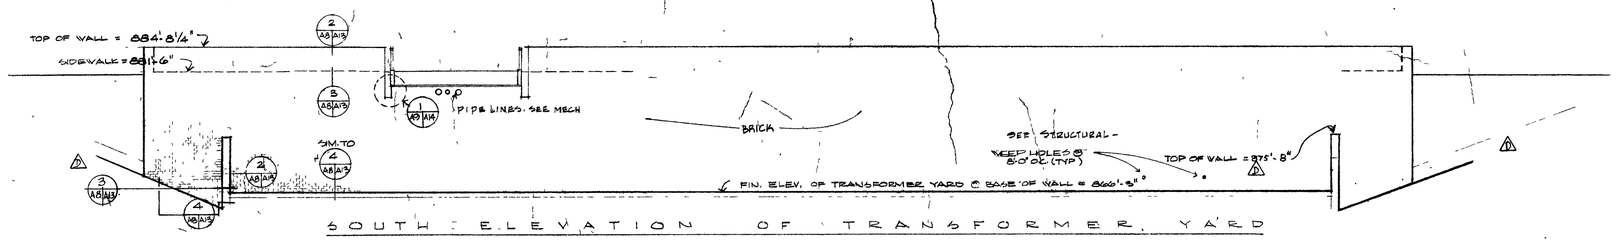

SOUTH ELEVATION OF TRANSFORMER YARD

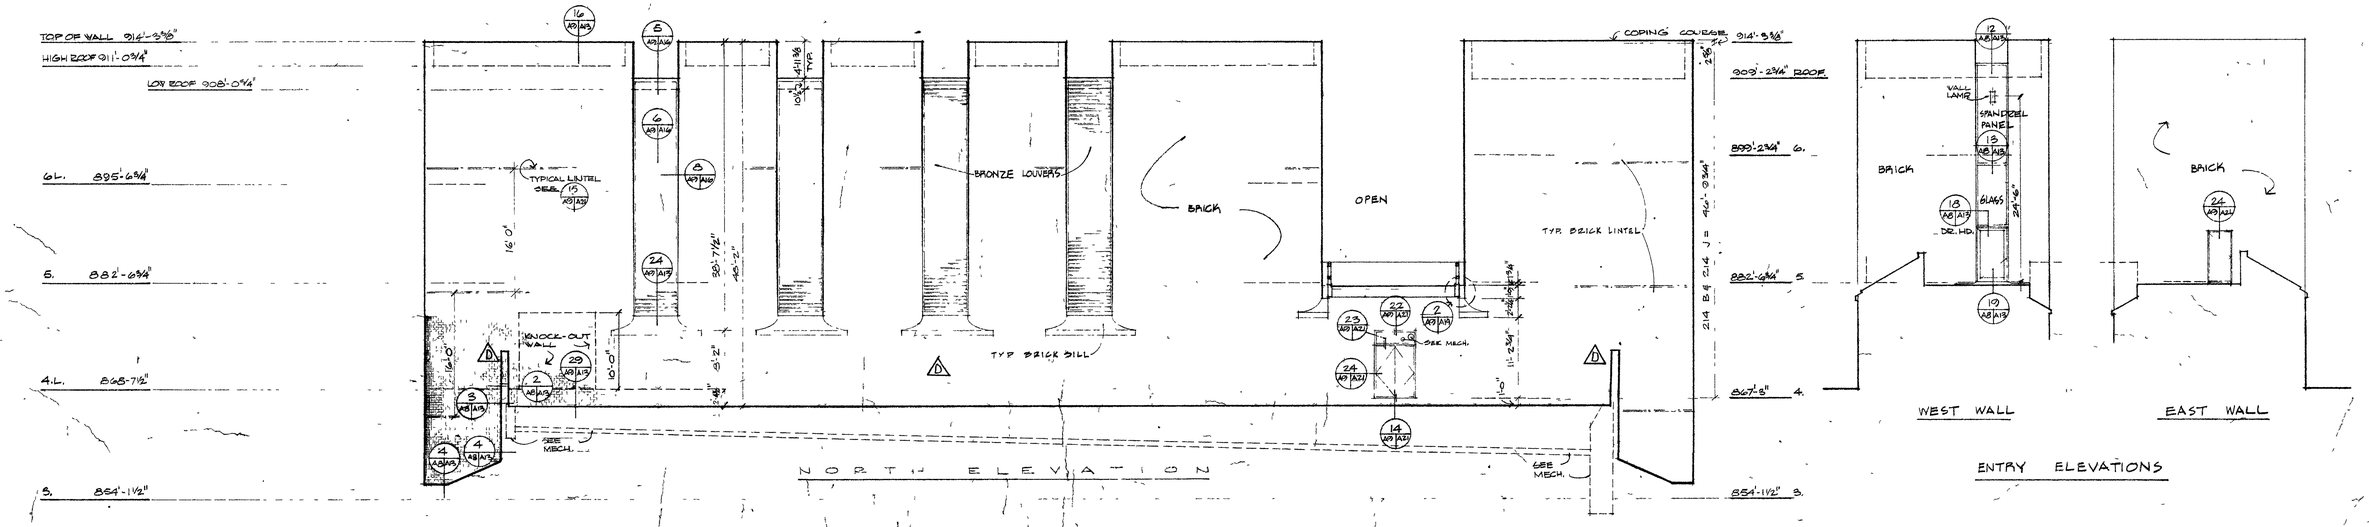

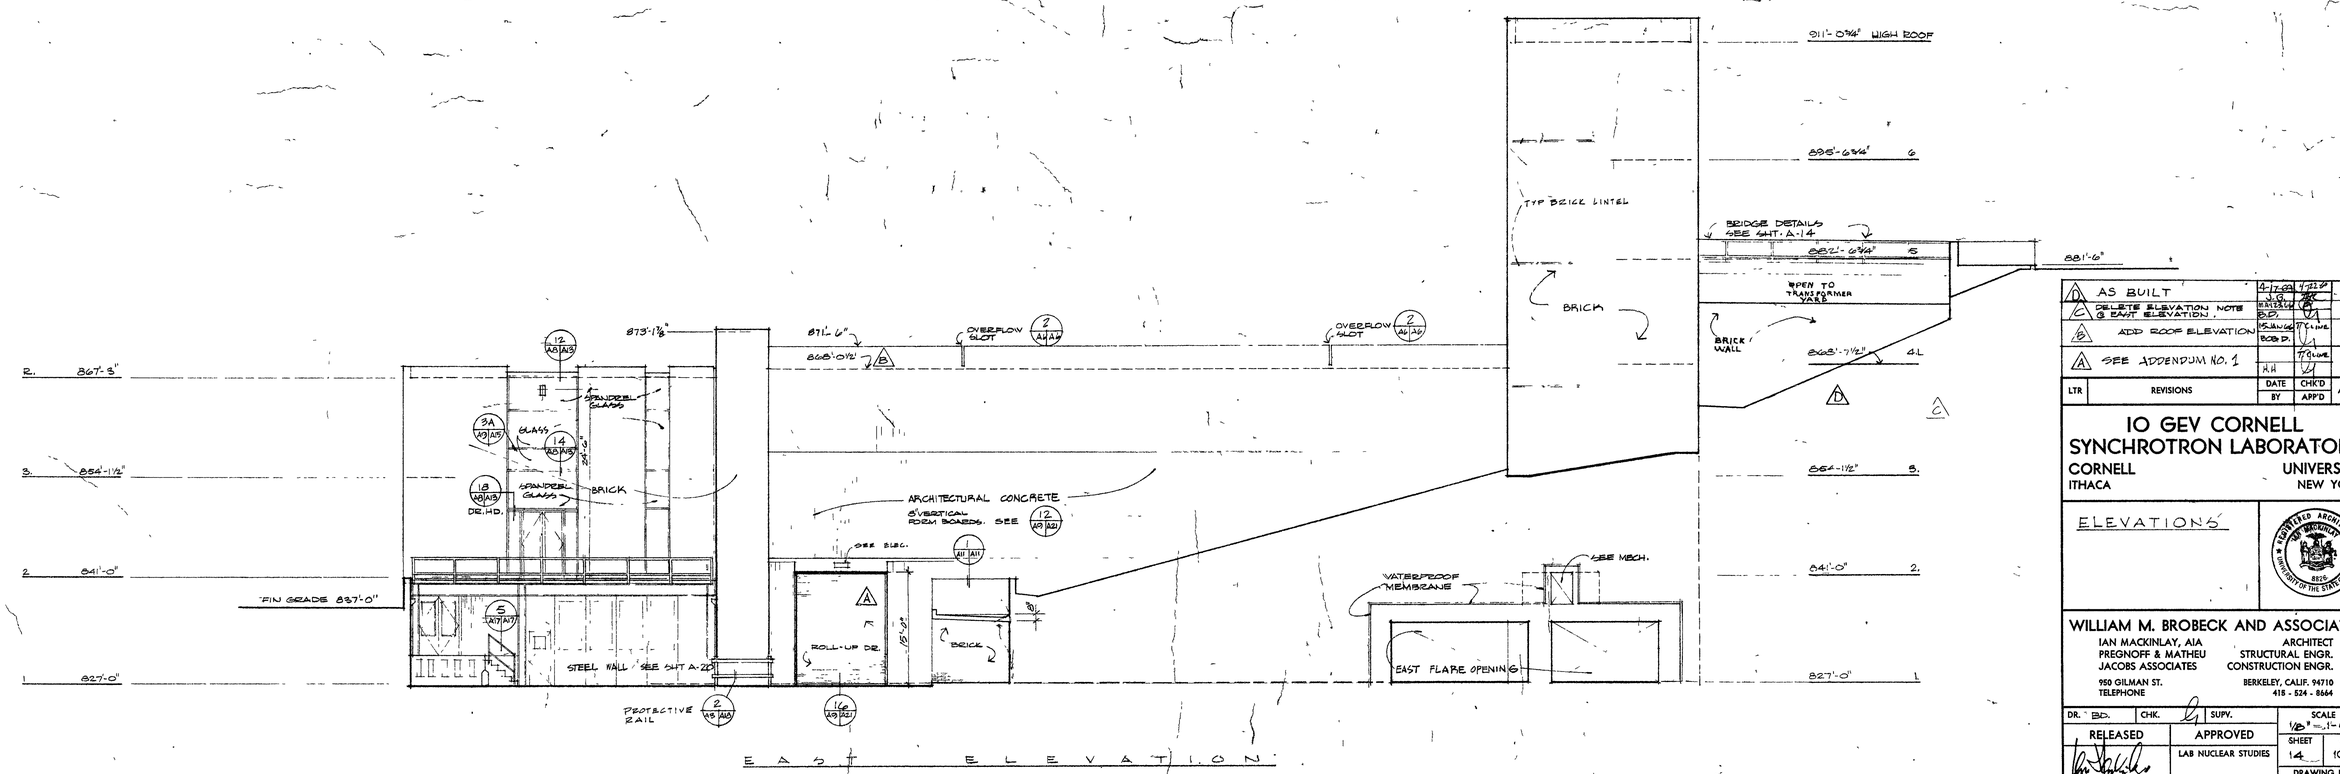

EAST ELEVATION

LTR	REVISIONS	DATE / BY	CHK'D / APP'D	APP'D
D	AS BUILT	4-17-69 J.G.	4-22-69	
C	DELETE ELEVATION NOTE @ EAST ELEVATION.	11-21-66 B.D.		
B	ADD ROOF ELEVATION	12-30-66 B.D.P.		
A	SEE ADDENDUM NO. 1	H.H.		

10 GEV CORNELL SYNCHROTRON LABORATORY

CORNELL UNIVERSITY
ITHACA NEW YORK

ELEVATIONS

WILLIAM M. BROBECK AND ASSOCIATES
IAN MACKINLAY, AIA — ARCHITECT
PREGNOFF & MATHEU — STRUCTURAL ENGR.
JACOBS ASSOCIATES — CONSTRUCTION ENGR.
950 GILMAN ST. BERKELEY, CALIF. 94710
TELEPHONE 418 - 524 - 8664

DR. BD. | CHK. | SUPV.

RELEASED — DATE NOV. 16, 1965

APPROVED — LAB NUCLEAR STUDIES — V.P.-BUSINESS — DATE JAN. 15, 1966

SCALE 1/8" = 1'-0"

SHEET 14 OF 102

DRAWING NO. A9

WMB & A NO. 111-8