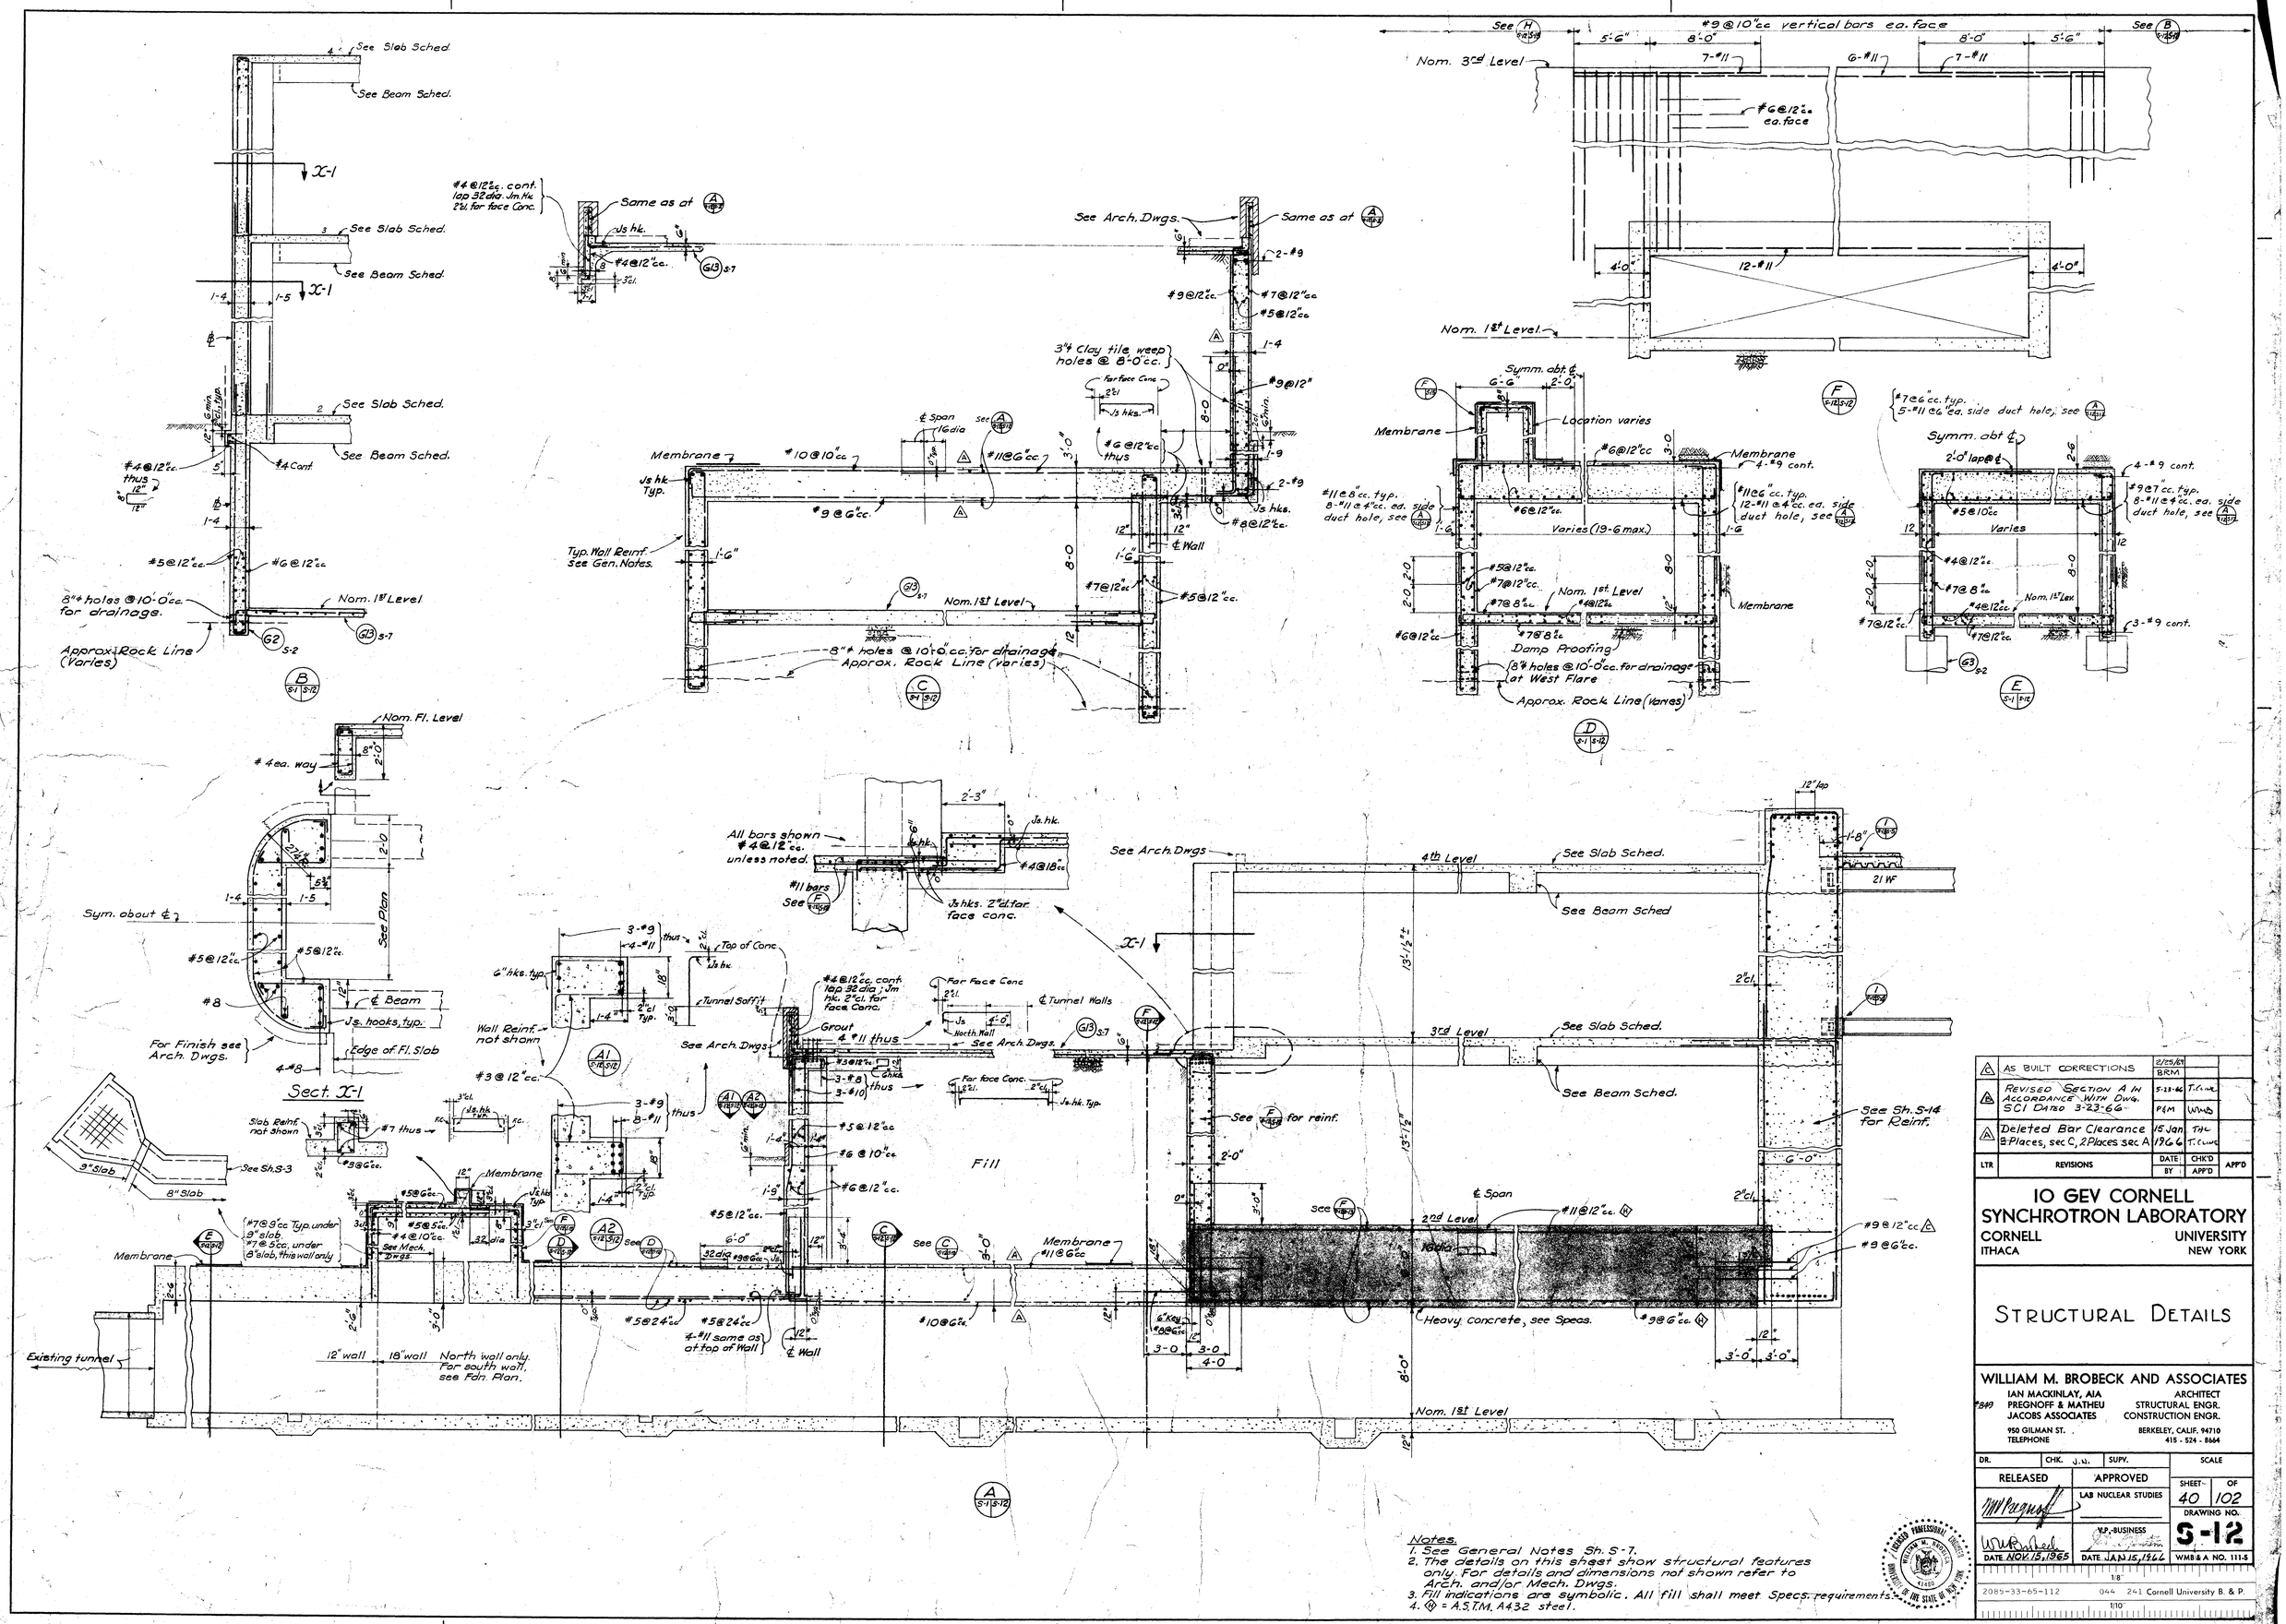

Notes.
1. See General Notes Sh. S-7.
2. The details on this sheet show structural features only. For details and dimensions not shown refer to Arch. and/or Mech. Dwgs.
3. Fill indications are symbolic. All fill shall meet Specs. requirements.
4. ⊗ = A.S.T.M. A432 steel.

LTR	REVISIONS	DATE / BY	CHK'D / APP'D	APP'D
A	AS BUILT CORRECTIONS	2/25/69 BRM		
B	REVISED SECTION A IN ACCORDANCE WITH DWG. SCI DATED 3-23-66	5-23-66 P&M	T.Clune WMB	
A	Deleted Bar Clearance @ Places, sec C, 2 Places sec A	15 Jan 1966	THC T.Clune	

10 GEV CORNELL SYNCHROTRON LABORATORY

CORNELL UNIVERSITY
ITHACA NEW YORK

STRUCTURAL DETAILS

WILLIAM M. BROBECK AND ASSOCIATES
ARCHITECT
IAN MACKINLAY, AIA.
#849 PREGNOFF & MATHEU — STRUCTURAL ENGR.
JACOBS ASSOCIATES — CONSTRUCTION ENGR.
950 GILMAN ST. BERKELEY, CALIF. 94710
TELEPHONE 415 - 524 - 8664

DR.	CHK. J.J.	SUPV.	SCALE
RELEASED	APPROVED		SHEET 40 OF 102
	LAB NUCLEAR STUDIES		DRAWING NO. S-12
DATE NOV. 15, 1965	V.P. BUSINESS DATE JAN 15, 1966		WMB & A NO. 111-5

2085-33-65-112 044 241 Cornell University B. & P.