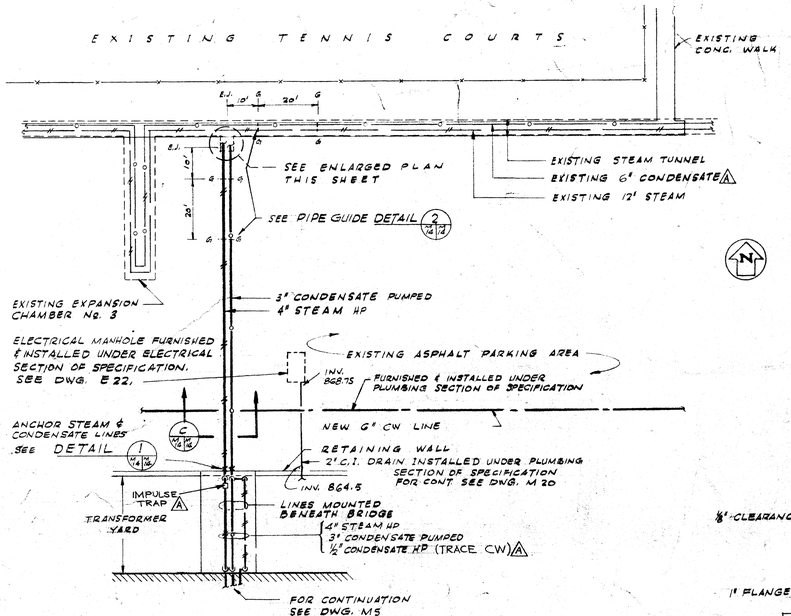

STEAM DISTRIBUTION - PARTIAL PLAN

SCALE 1" = 20'

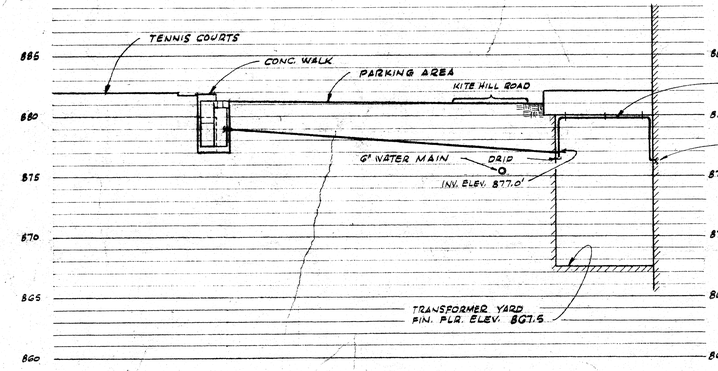

PROFILE

HORIZ. SCALE 1" = 20'-0

VERT. SCALE 1" = 5'-0

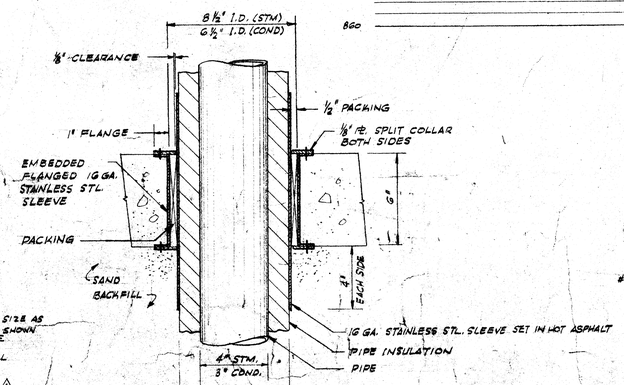

PIPE SEAL DETAIL 4

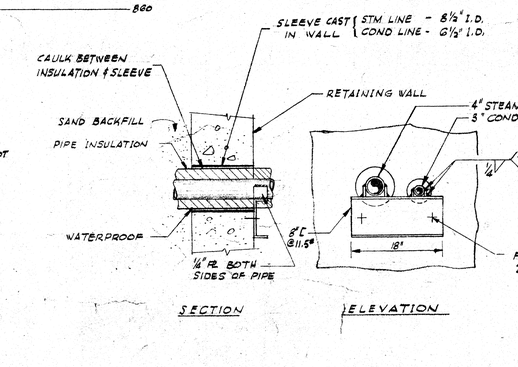

SECTION

ELEVATION

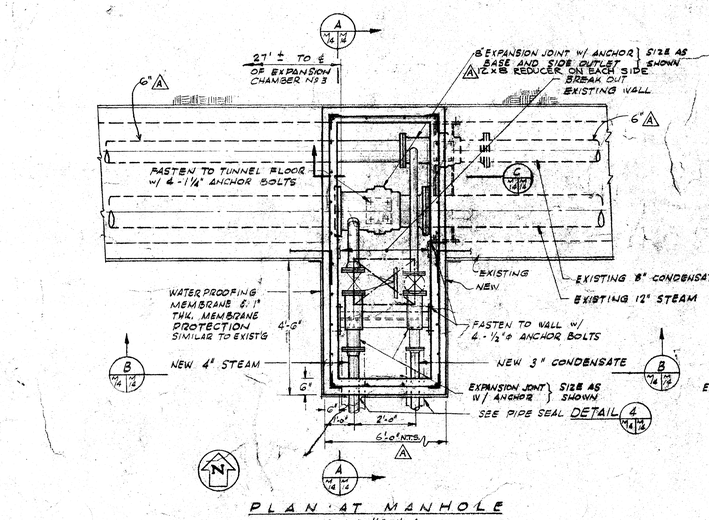

PLAN AT MANHOLE

SCALE ½" = 1'-0"

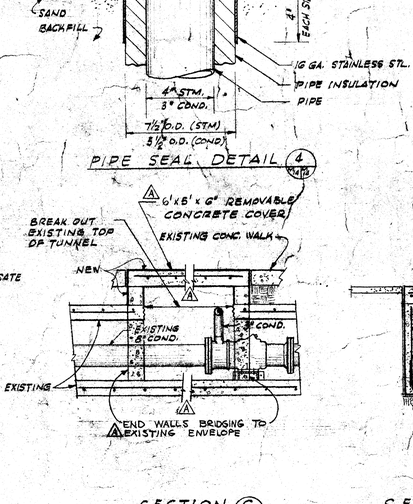

SECTION C

SCALE ½" = 1'-0"

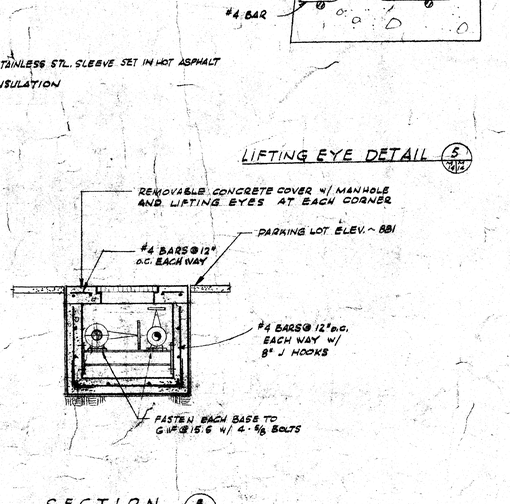

SECTION B

SCALE ½" = 1'-0"

LIFTING EYE DETAIL 5

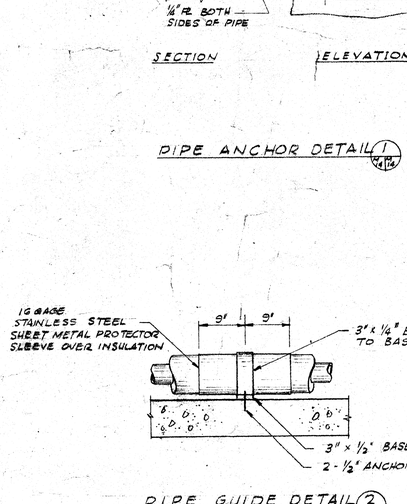

PIPE GUIDE DETAIL 2

PIPE ANCHOR DETAIL 1

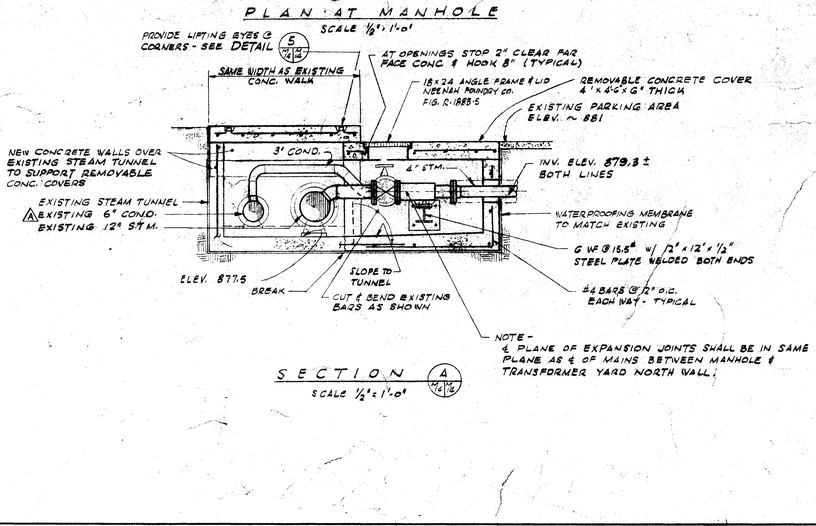

SECTION A

SCALE ½" = 1'-0"

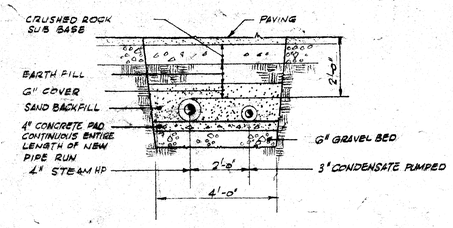

SECTION C

SCALE ½" = 1'-0"

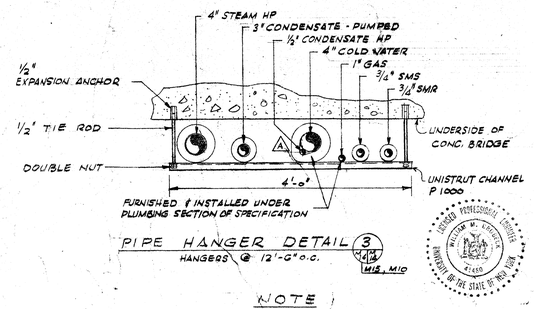

PIPE HANGER DETAIL 3

HANGERS @ 12'-0" o.c.

M16 MIO

NOTE

1. FOR EQUIPMENT SCHEDULE AND LEGEND REFER TO DWG. M1.

LTR	REVISIONS	DATE	BY	CHK'D	APP'D
A	AS BUILT CORRECTIONS	12/16/68	BRM		

10 GEV CORNELL SYNCHROTRON LABORATORY

CORNELL UNIVERSITY
ITHACA NEW YORK

AIR CONDITIONING HEATING & VENTILATING STEAM DISTRIBUTION PLAN & DETAILS

WILLIAM M. BROBECK AND ASSOCIATES
IAN MACKINLAY, AIA — ARCHITECT
PREGNOFF & MATHEU — STRUCTURAL ENGR.
JACOBS ASSOCIATES — CONSTRUCTION ENGR.
950 GILMAN ST. BERKELEY, CALIF. 94710
TELEPHONE 415 - 524 - 8664

DR. RobessL | CHK'D | SUPV'D | SCALE NOTED

RELEASED | APPROVED | SHEET 60 OF 102

T.H. Cline — LAB NUCLEAR STUDIES — DRAWING NO. M16

DATE Nov. 15, 1968 | MP-BUSINESS | DATE JAN 15, 1966 | WMB & A NO. 111-5

1/8"

2085-33-65-216 044 261 Cornell University B. & P.

1/10"