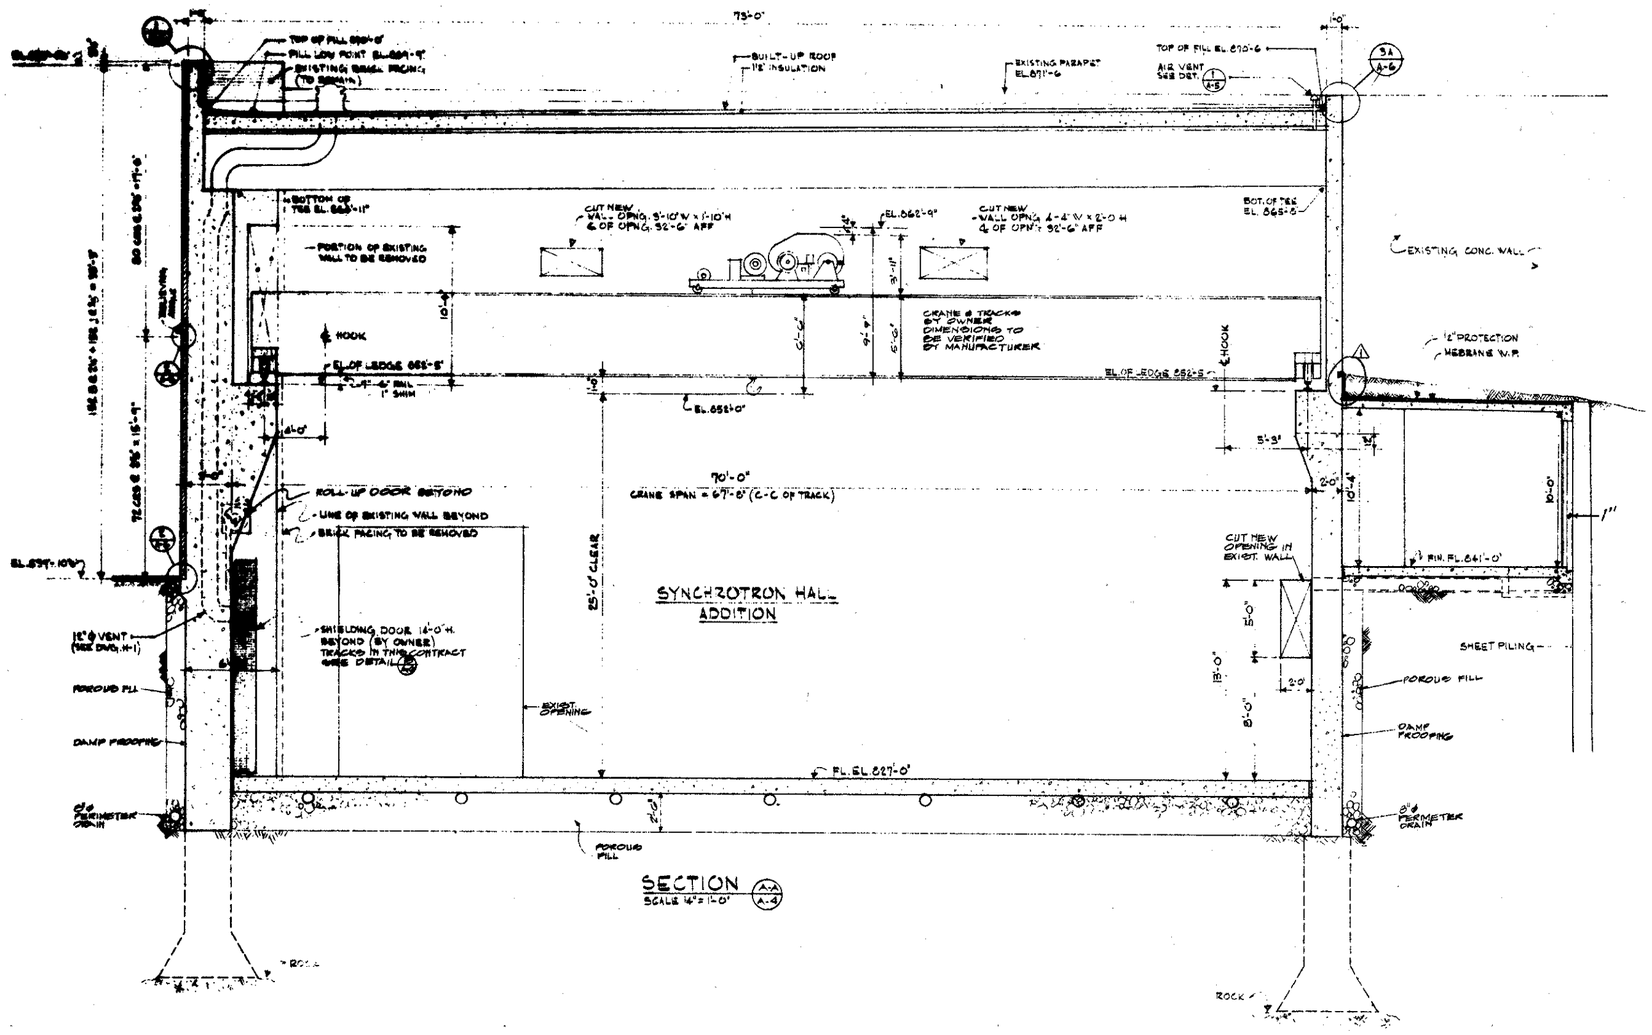

SECTION A-A / A-4
SCALE ¼" = 1'-0"

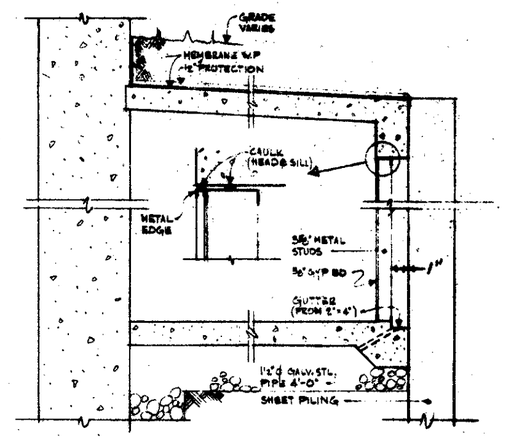

COUNTING ROOM DETAILS
SCALE 3/4" = 1'-0"

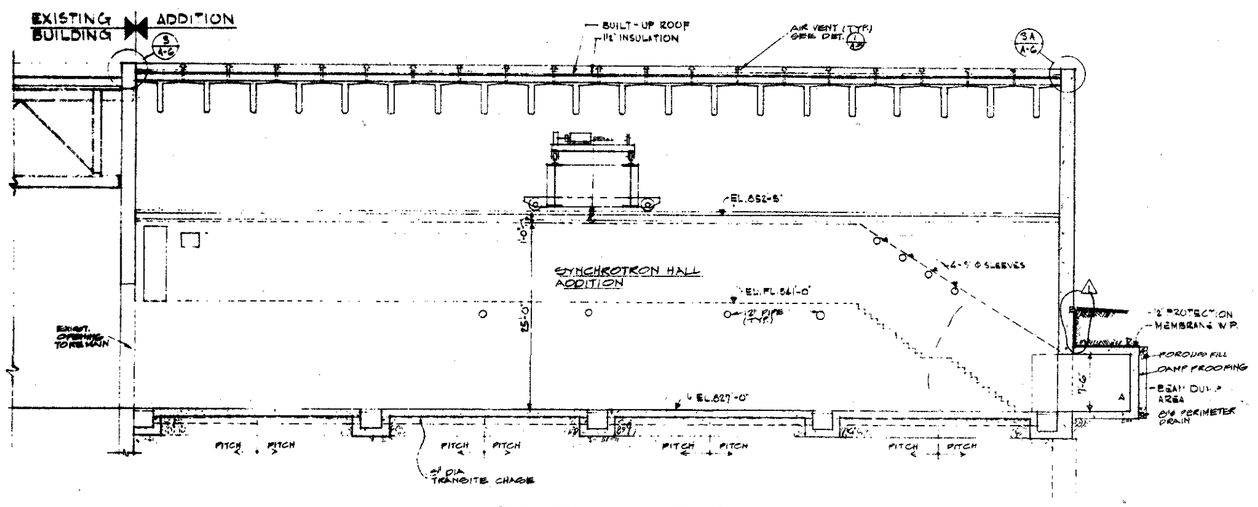

LONGITUDINAL SECTION B-B / A-4
SCALE ⅛" = 1'-0"

As Built
Bob Cowing
A. FRIEDERICH & SONS

8-2-71	REVISION AS NOTED	1
REVISIONS	DATE JULY 1-1971	WANK ADAMS SLAVIN & ASSOCIATES ARCHITECTS & ENGINEERS 155 EAST 42 STREET NEW YORK NY 10017
	SCALE AS SHOWN	10 GEV CORNELL WILSON SYNCHROTRON LAB. ADDITION CORNELL UNIVERSITY ITHACA, N.Y.
DRAWN BY L.G.		SECTIONS A-4

1/8"

2085-63-71-004 053 336 Cornell University B.&P.

1/10"